

CONSTRUCTION/RECORD DRAWINGS

COLONEL WRIGHT WAY STREET IMPROVEMENTS

SW 1/4, SEC. 30, T.36N., R.5W., B.M.

CITY OF LEWISTON, NEZ PERCE COUNTY, IDAHO

Record Drawing 08/07/2018

SHEET INDEX

GENERAL	
G-1	COVER AND SHEET INDEX
G-2	GENERAL CONSTRUCTION NOTES & QUANTITY SUMMARY
G-3	SITE PLAN AND SURVEY CONTROL
G-4	ROADWAY TYPICAL SECTIONS
G-5	DETAILS

ROADWAY	
C-1	PLAN
C-2	PLAN
C-3	PROFILE CURB & GUTTER RIGHT
C-4	PROFILE CURB & GUTTER RIGHT
C-5	PROFILE CURB & GUTTER LEFT
C-6	PROFILE CURB & GUTTER LEFT
C-7	TEMPORARY TRAFFIC CONTROL PLAN
C-8	SIGNING & MARKING PLAN

LEGEND

	REMOVAL BITUMINOUS SURFACE
	SIDEWALK
	SWALE
	PAVEMENT
	DRIVEWAY


AGENCY TELEPHONE NUMBERS

CITY OF LEWISTON PUBLIC WORKS DEPARTMENT	208 746-1316
STREETS ON CALL	208 791-2311
WASTEWATER	208 791-0986
WATER	208 790-1712
AVISTA UTILITIES	208 798-1473
CABLEONE	208 746-3325
CENTURYLINK	208 798-8380
DIGLINE UNDERGROUND UTILITY LOCATE	811

CALL BEFORE YOU DIG
IT'S THE LAW
811
OHWD

THE LOCATION OF EXISTING UTILITIES ON THESE PLANS ARE APPROXIMATE AND ARE SHOWN FOR INFORMATION ONLY. THE CONTRACTOR SHALL PERFORM A SEPARATE INVESTIGATION IN THE FIELD TO DETERMINE THE EXACT LOCATION OF ALL EXISTING UNDERGROUND UTILITIES. INFORMATION REGARDING THE LOCATION OF EXISTING UNDERGROUND UTILITIES CAN BE OBTAINED FROM CALLING DIG LINE AT 811.

PROFESSIONAL ENGINEER
LICENSED
Alannah Bailey
14113
11-02-2017
STATE OF IDAHO
ALANNAH M. BAILEY

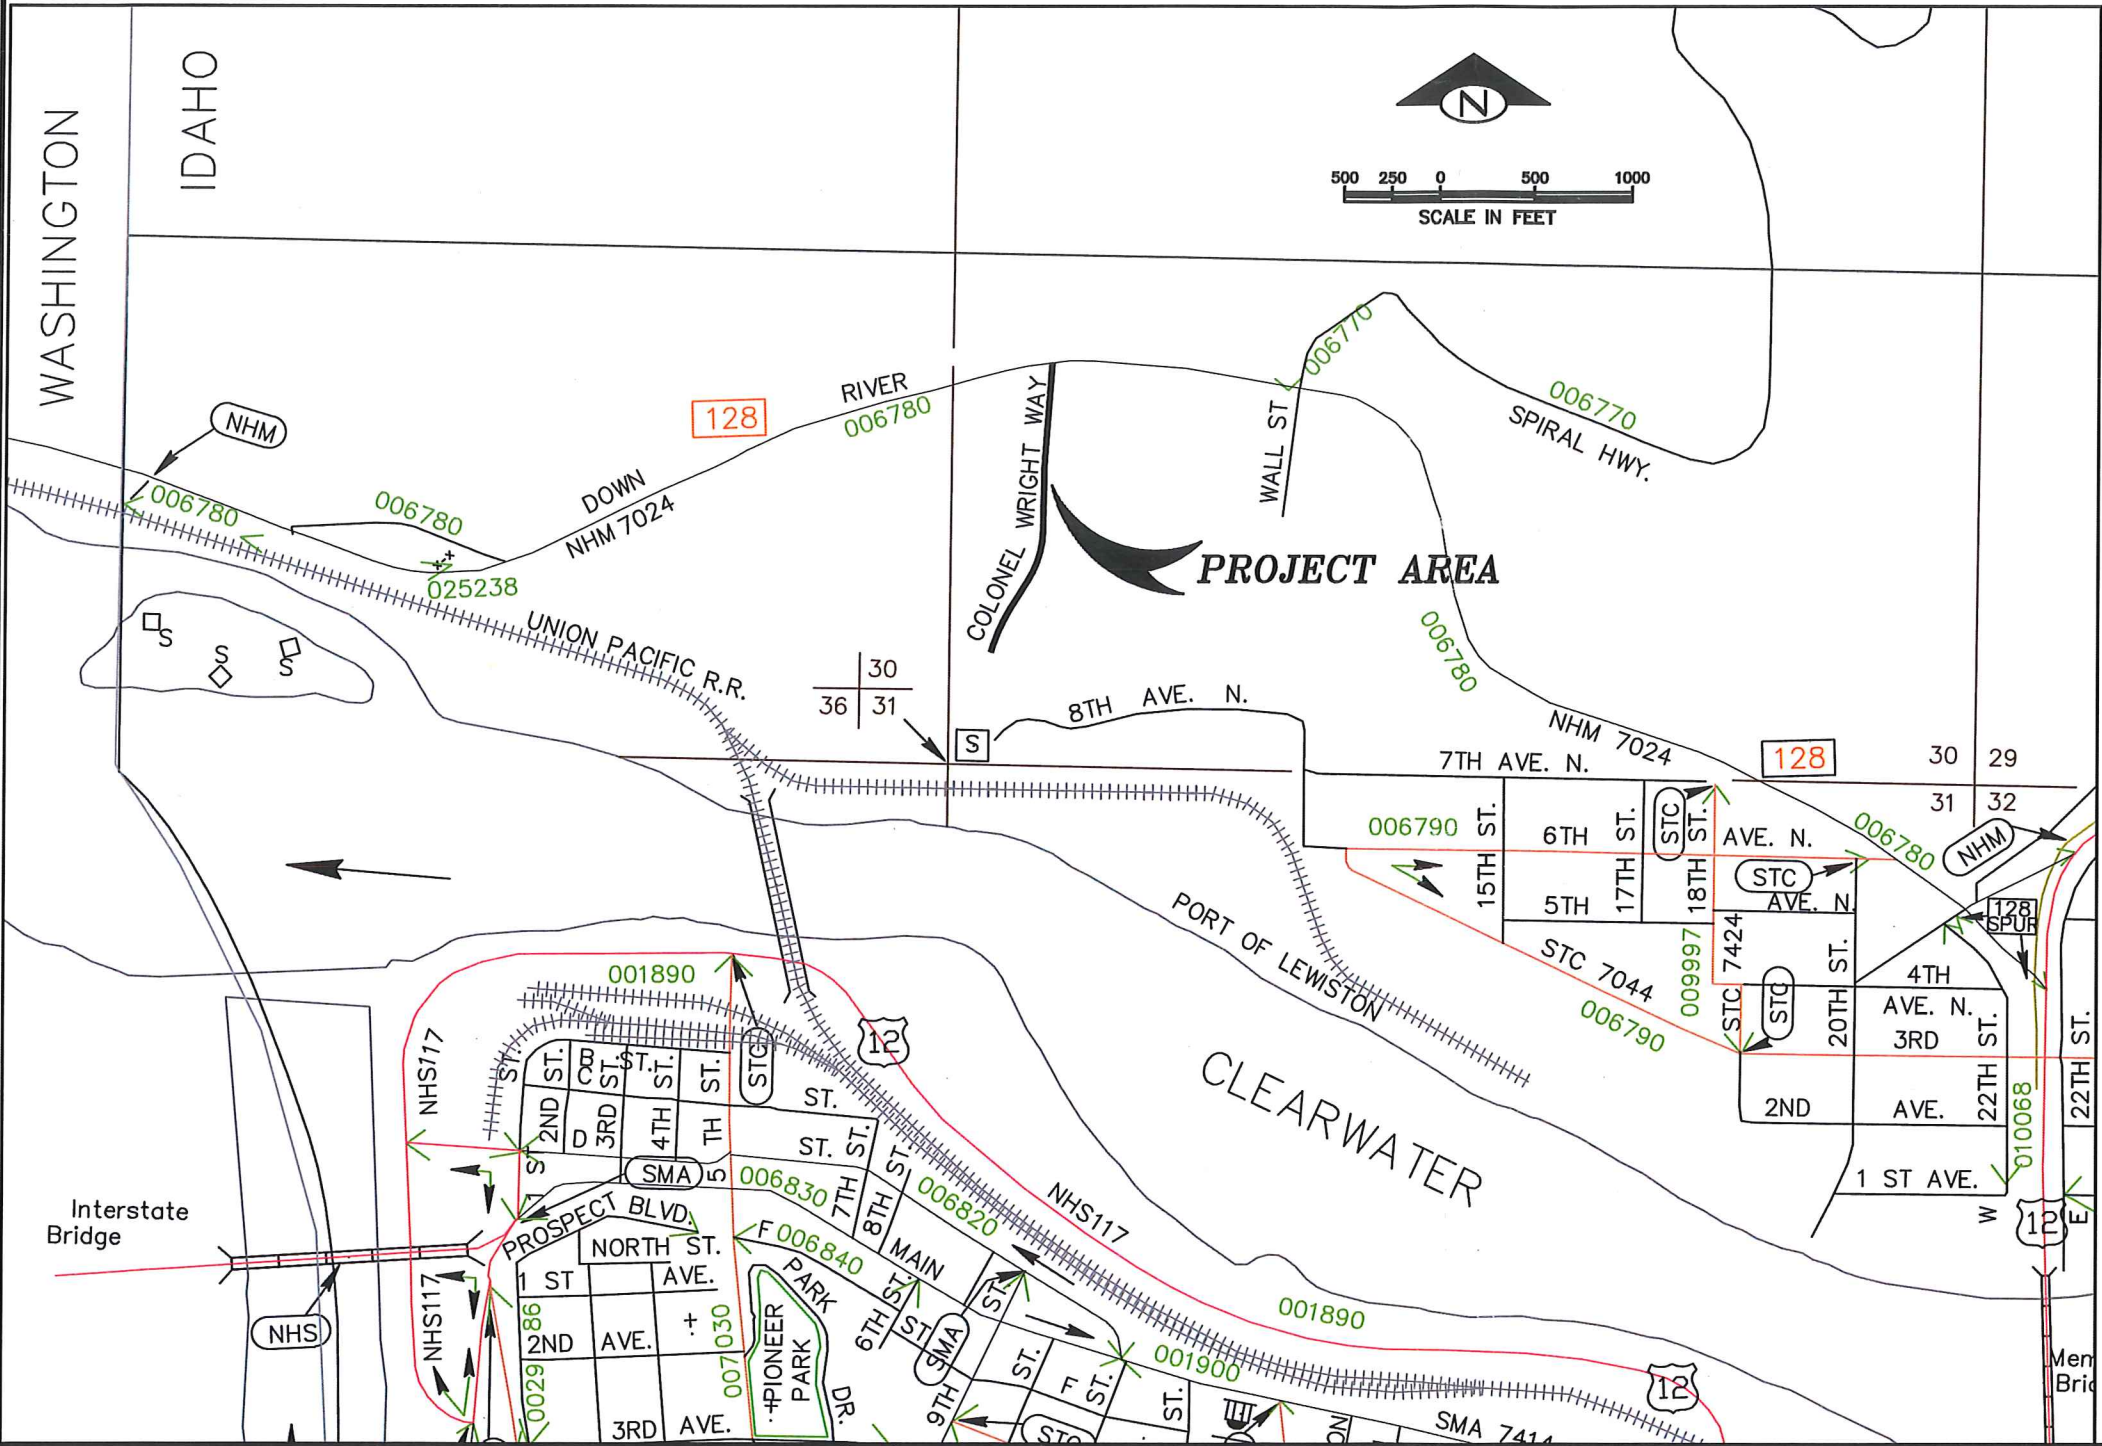


REVISIONS			
NO.	DATE	DESCRIPTION	BY

CITY OF LEWISTON
PUBLIC WORKS
DEPARTMENT
1861

215 "D" Street, Lewiston, ID 83501-1930
Phone: 208-746-1316 Fax: 208-746-5595

COLONEL WRIGHT WAY STREET IMPROVEMENTS	SCALE: 1" = 40'
	DESIGNED BY: A. BAILEY
COVER AND SHEET INDEX	DRAWN BY: B. STEWART
	CHECKED BY: S. STUBBERS
	SHEET SET: CW-WAY
	DATE: 11-01-2017
	DRAWING NO.: G-1
	SHEET 1 OF 13

File Name: j:\CAPITAL\Streets\TR043 TransferStation_Access Rd-Col Wright Way.dwg\Production Drawings\PLAN & PROFILE.dwg Printed 11/1/2017 11:26 AM By Bruce Stewart

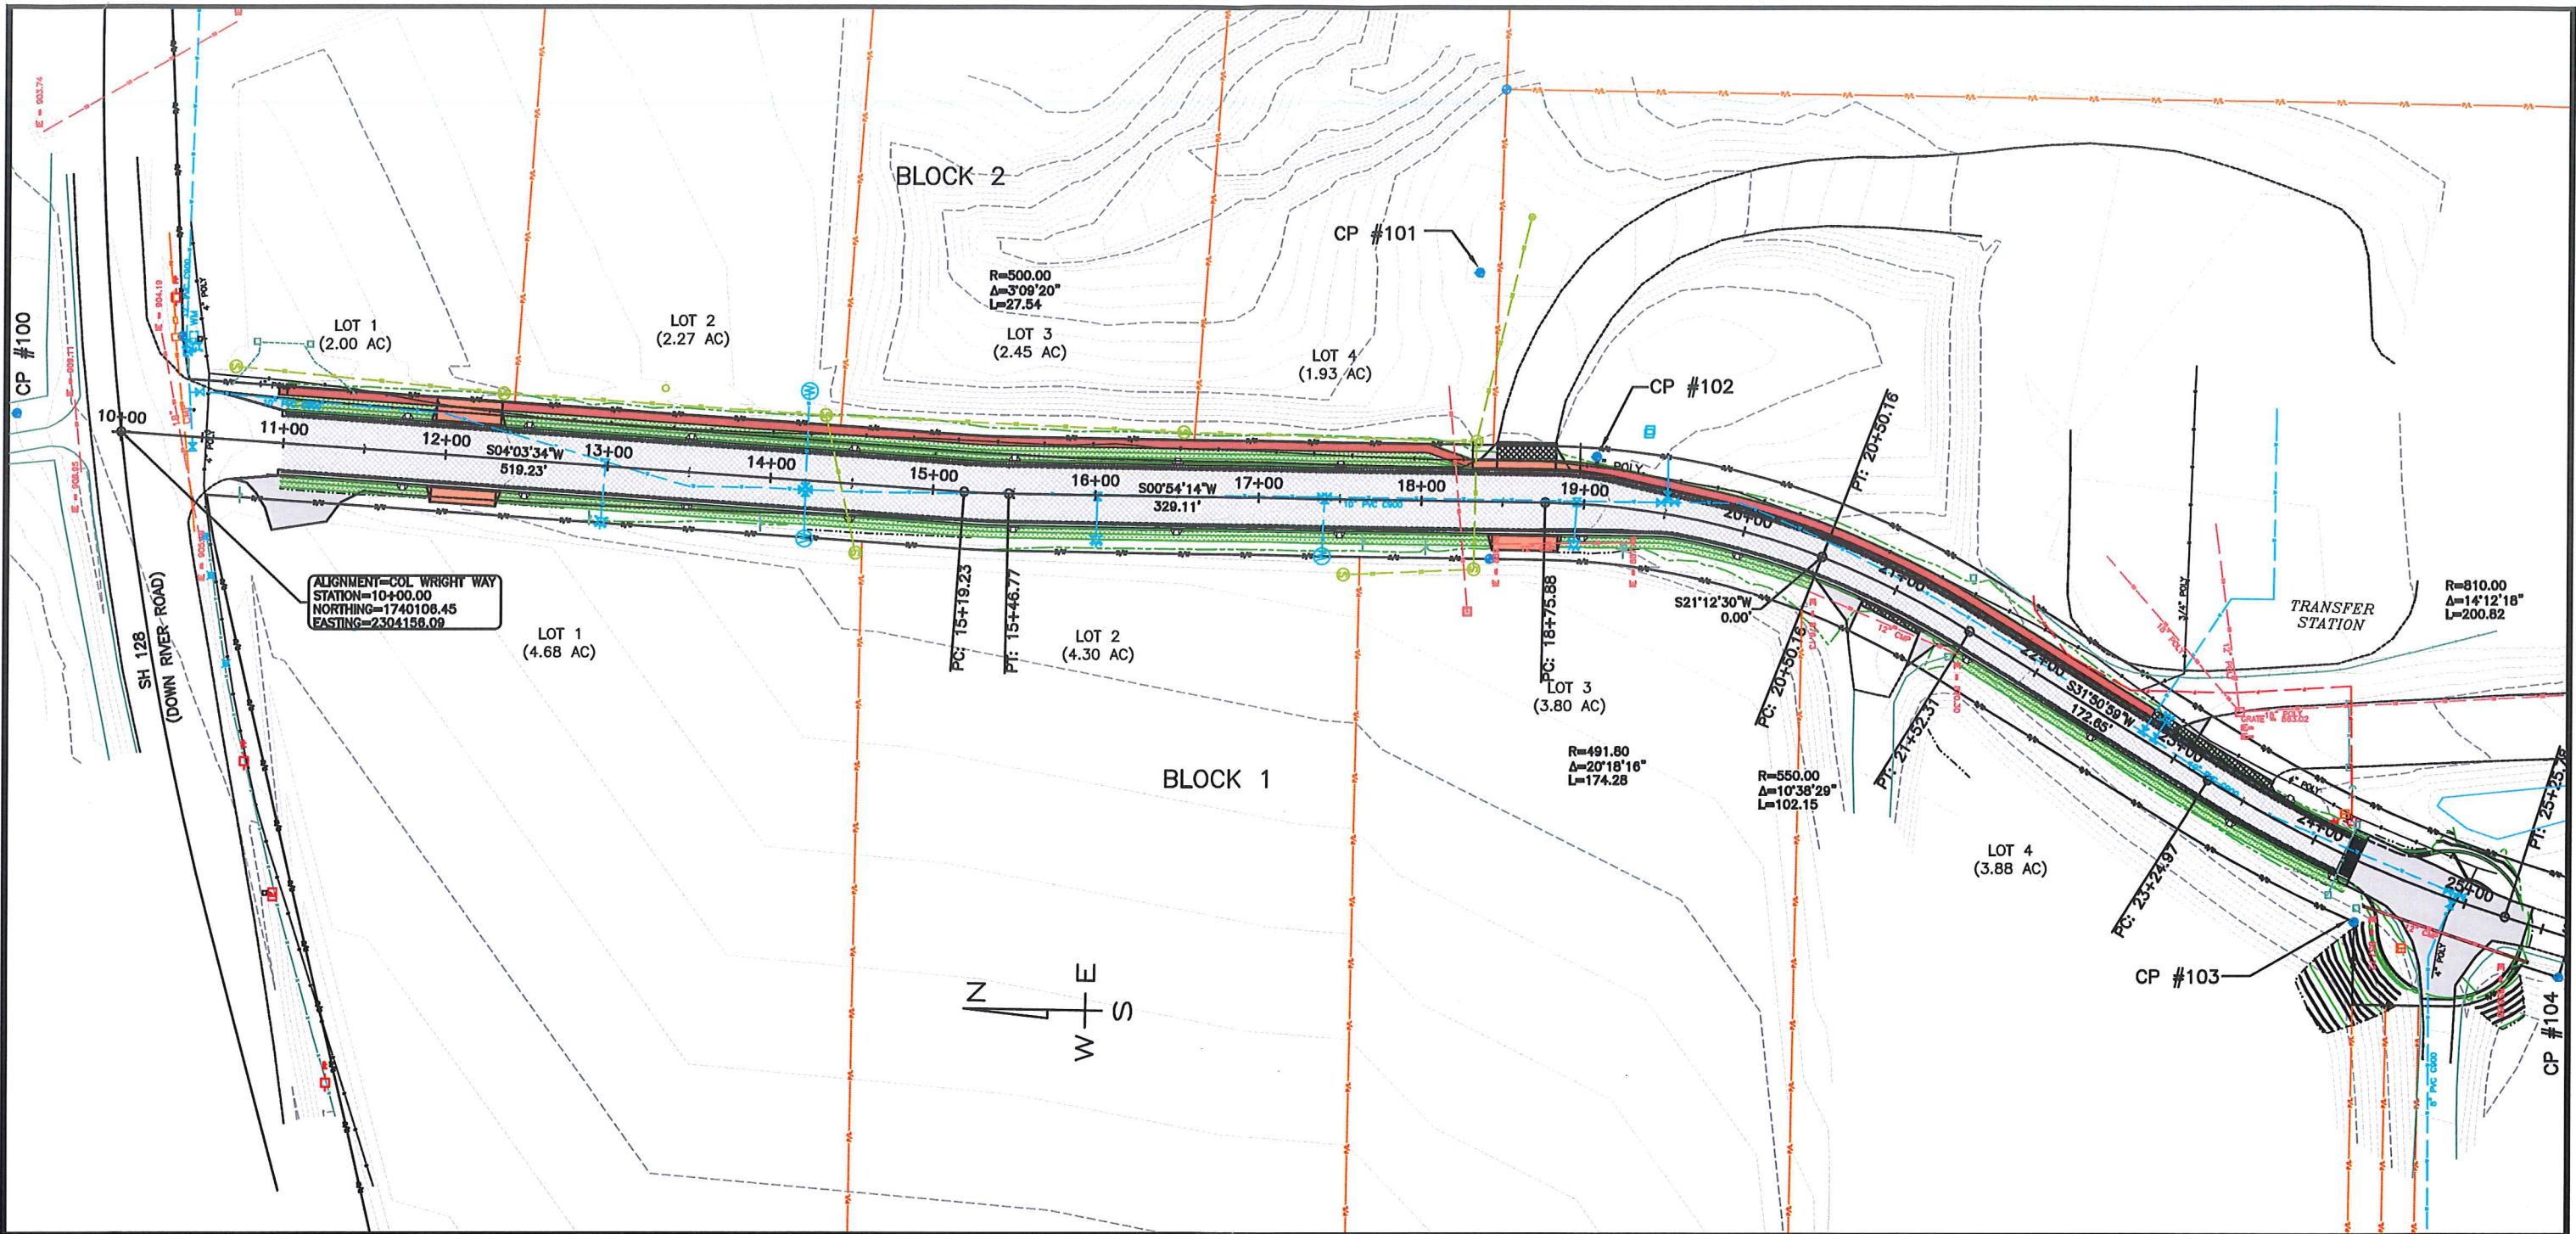

SURVEY CONTROL


1. All Units are in U.S. Survey Feet, Grid Values are SPC Zone 1103 (Idaho West), Geodetic Values are NAD83(1998/1999). Elevations are NAVD88.
2. To convert ground distance to State Plane Grid distances, scale using a combined factor of 1.00001547 (Pt 2A). The difference between grid distances and ground distances does not exceed 1:15,000 for the Idaho West Zone at all locations within this project so scaling may not be necessary depending on accuracy requirements.

SURVEY NOTE:

THE LEFT AND RIGHT CURB AND GUTTER PROFILES ARE BASED ON ALIGNMENTS ALONG THE SAWCUT LINES WHICH DIFFERS SLIGHTLY IN STATIONING THAN THE CENTERLINE STATION SHOWN ON THE PLAN VIEWS DUE TO DIFFERENT OFFSETS AND CURVE LENGTHS. THESE ALIGNMENTS AND PROFILES WILL BE USED FOR THE STAKING OF THE SAWCUT LINE, CURB AND GUTTER. ALL STATIONING AND OFFSETS SHOWN ON THE PLAN VIEW DRAWINGS ARE BASED ON CENTERLINE STATIONING.



SURVEY CONTROL POINTS						
PNT#	NORTHING	EASTING	ELEV.	STATION	OFFSET	DESCRIPTION
100	1740170.48	2304167.47	914.75	9+35.33	6.81 LT	5/8" REBAR W/RED PLASTIC CAP
101	1739272.47	2304254.10	889.02	18+33.13	140.50 LT	5/8" REBAR (RIEDEL CPT#2)
102	1739200.04	2304141.25	891.35	19+05.56	29.75 LT	1/2" REBAR IN RR TIE WEST END
103	1738733.61	2303855.98	862.34	24+42.88	35.25 RT	5/8" REBAR W/YELLOW PLASTIC CAP
104	1738608.97	2303822.06	857.34	25+68.48	25.37 RT	5/8" REBAR W/YELLOW PLASTIC CAP

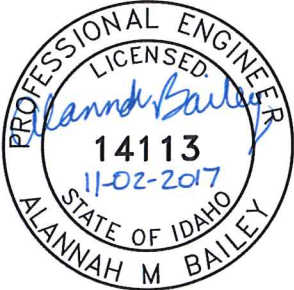

REVISIONS			
NO.	DATE	DESCRIPTION	BY




215 "D" Street, Lewiston, ID 83501-1930
Phone: 208-746-1316 Fax: 208-746-5595

**COLONEL WRIGHT WAY
STREET IMPROVEMENTS**


SITE PLAN AND SURVEY CONTROL

SCALE: AS SHOWN
DESIGNED BY: A. BAILEY
DRAWN BY: B. STEWART
CHECKED BY: S. STUBBERS
SHEET SET: CW-WAY
DATE: 11-01-2017
DRAWING NO.: G-3
SHEET 3 OF 13


File Name: J:\CAPITAL\Streets\TR043 TransferStation_Access Rd-Col Wright Way\dwg\Production Drawings\TYPICALS.dwg Printed 11/1/2017 11:28 AM By Bruce Stewart

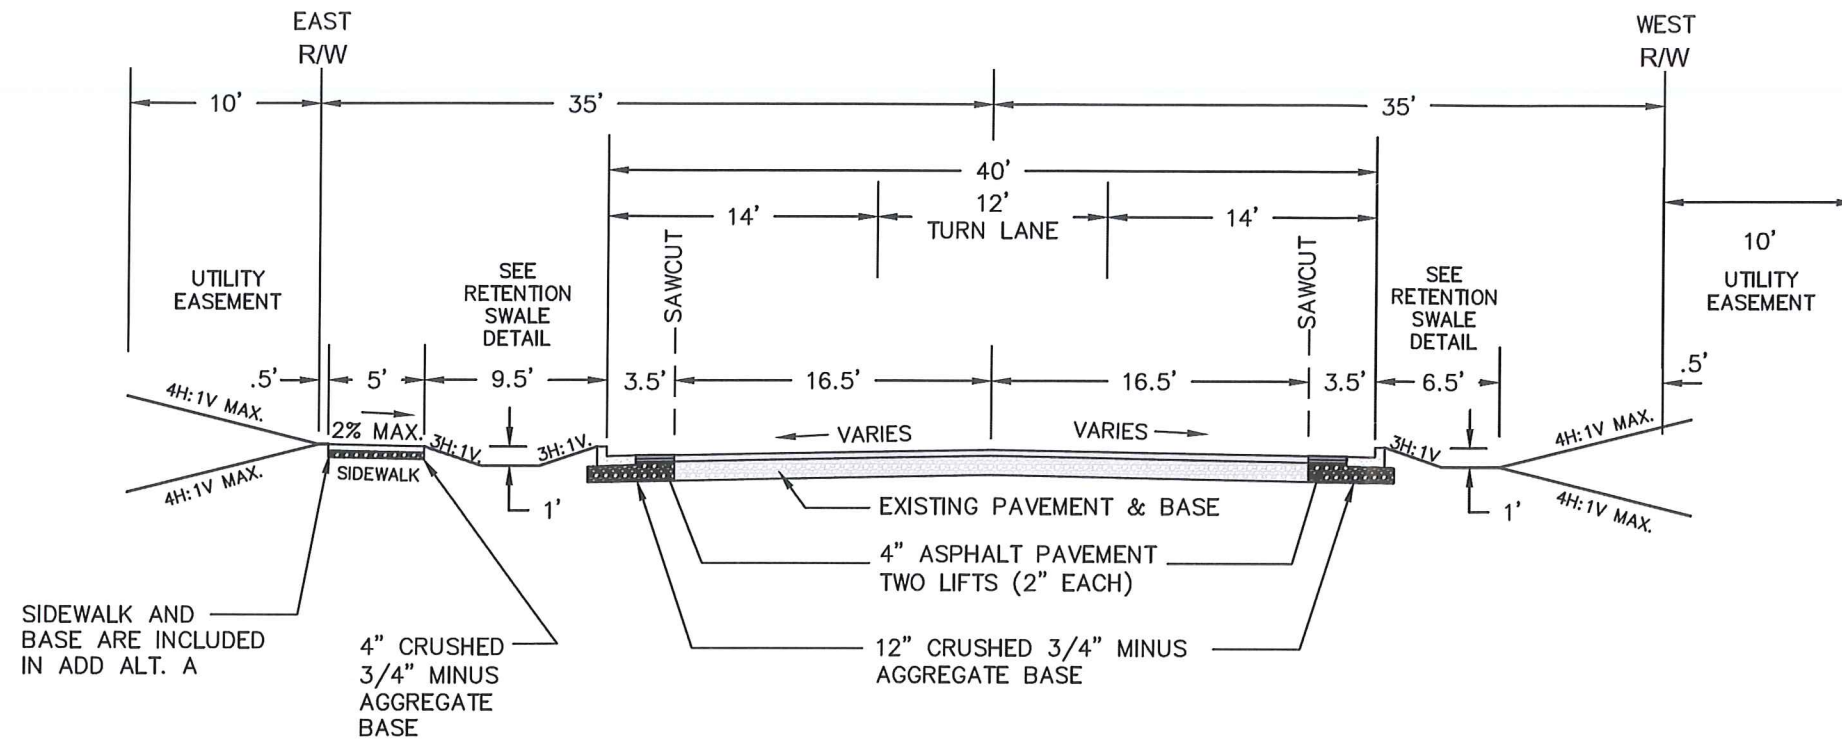

TYPICAL ROADWAY SECTION
STATION 11+00 TO STATION 18+03.19

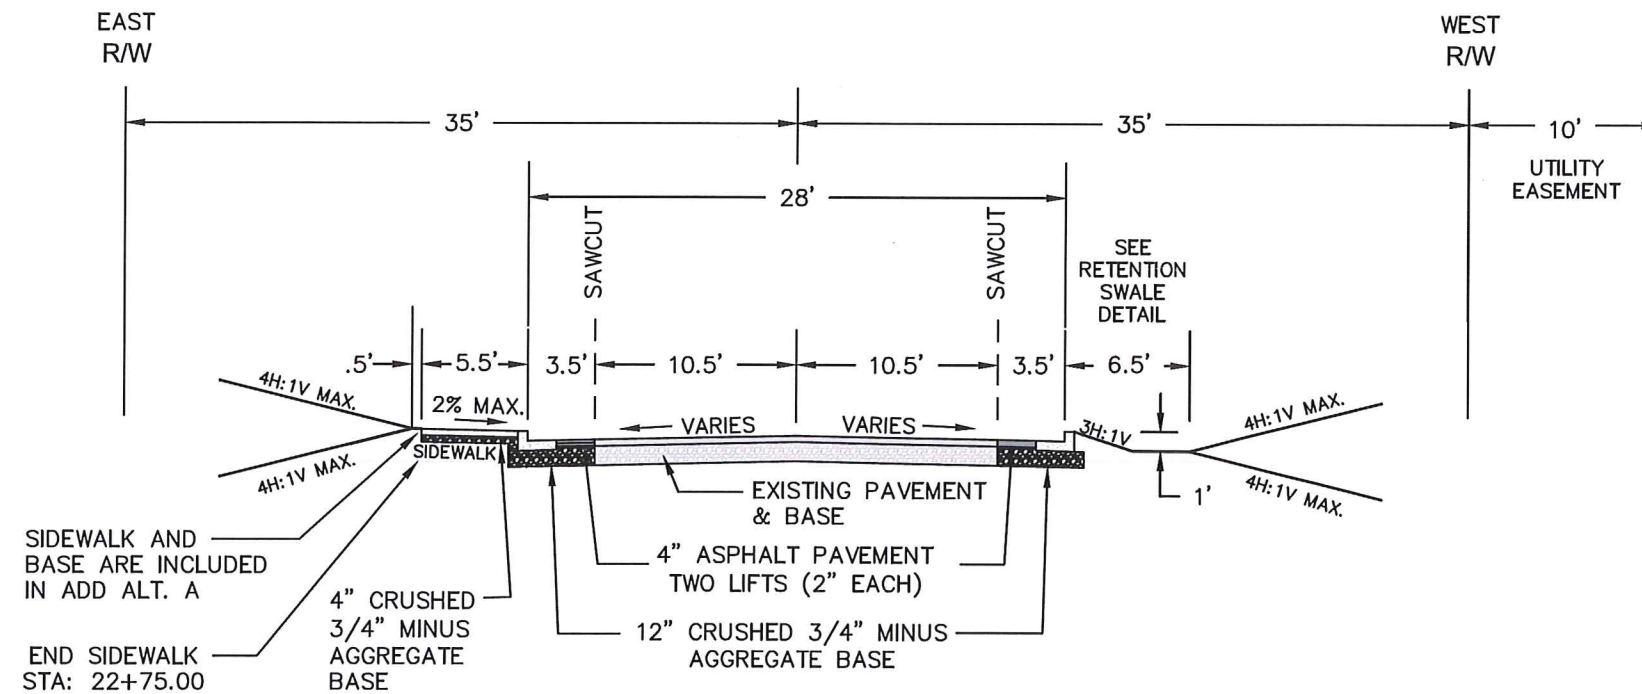

TYPICAL ROADWAY SECTION
STATION 19+79.36 TO STATION 24+30

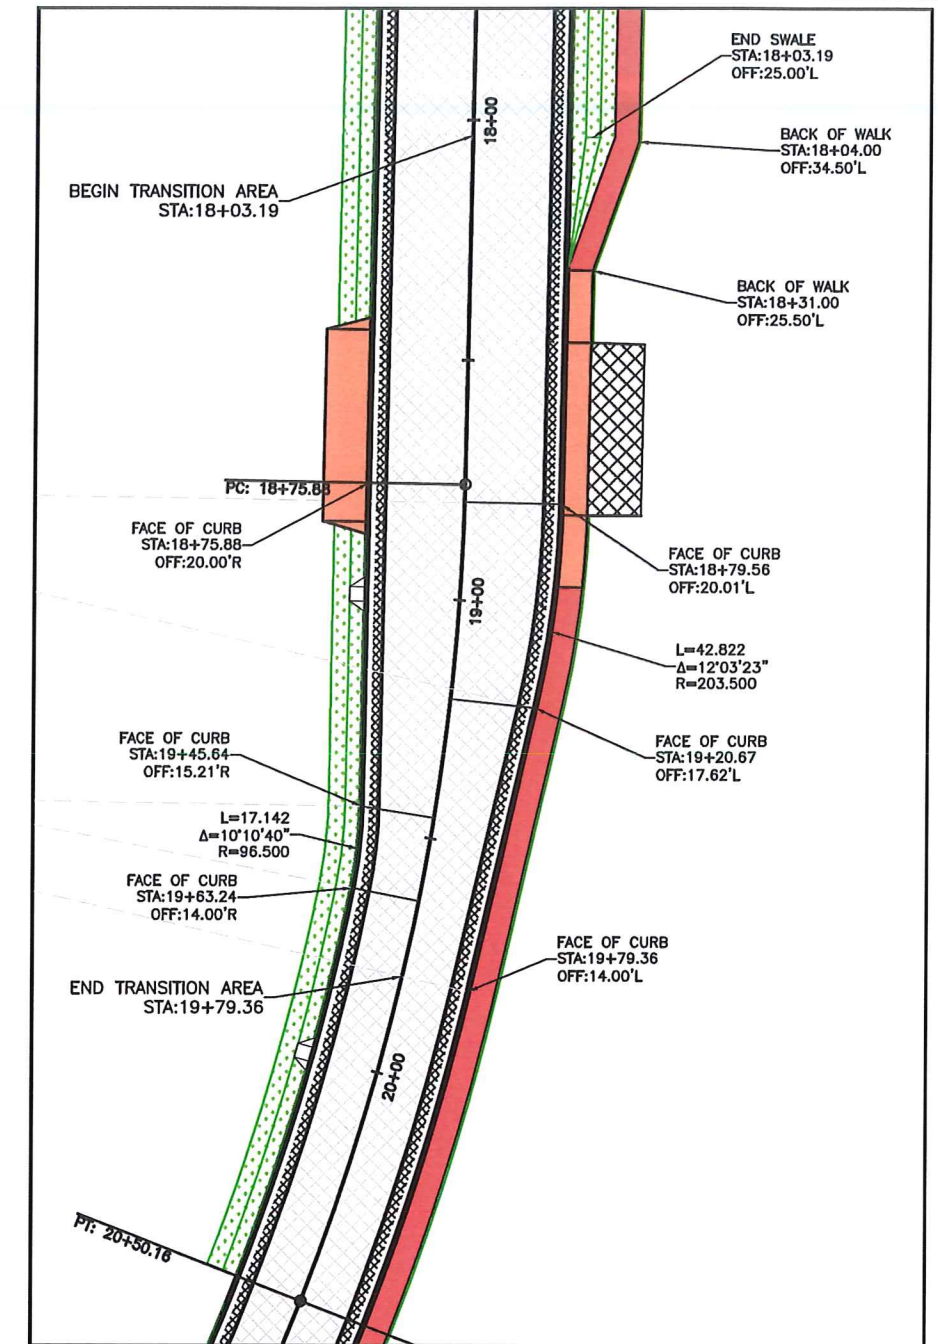

ROADWAY TRANSITION DETAIL
STATION 18+03.19 TO STATION 19+79.36



REVISIONS			
NO.	DATE	DESCRIPTION	BY




215 "D" Street, Lewiston, ID 83501-1930
Phone: 208-746-1316 Fax: 208-746-5595

COLONEL WRIGHT WAY
STREET IMPROVEMENTS


ROADWAY TYPICAL SECTION

SCALE: 1" = 40'
DESIGNED BY: A. BAILEY
DRAWN BY: B. STEWART
CHECKED BY: S. STUBBERS
SHEET SET: CW-WAY
DATE: 11-01-2017
DRAWING NO.: G-4
SHEET 4 OF 13

File Name \\CAPITAL\Streets\TR043 TransferStation_Access Rd\Col Wright Way\dwg\Production Drawings\PLAN & PROFILE.dwg Printed 11/2/2017 4:05 PM By Bruce Stewart

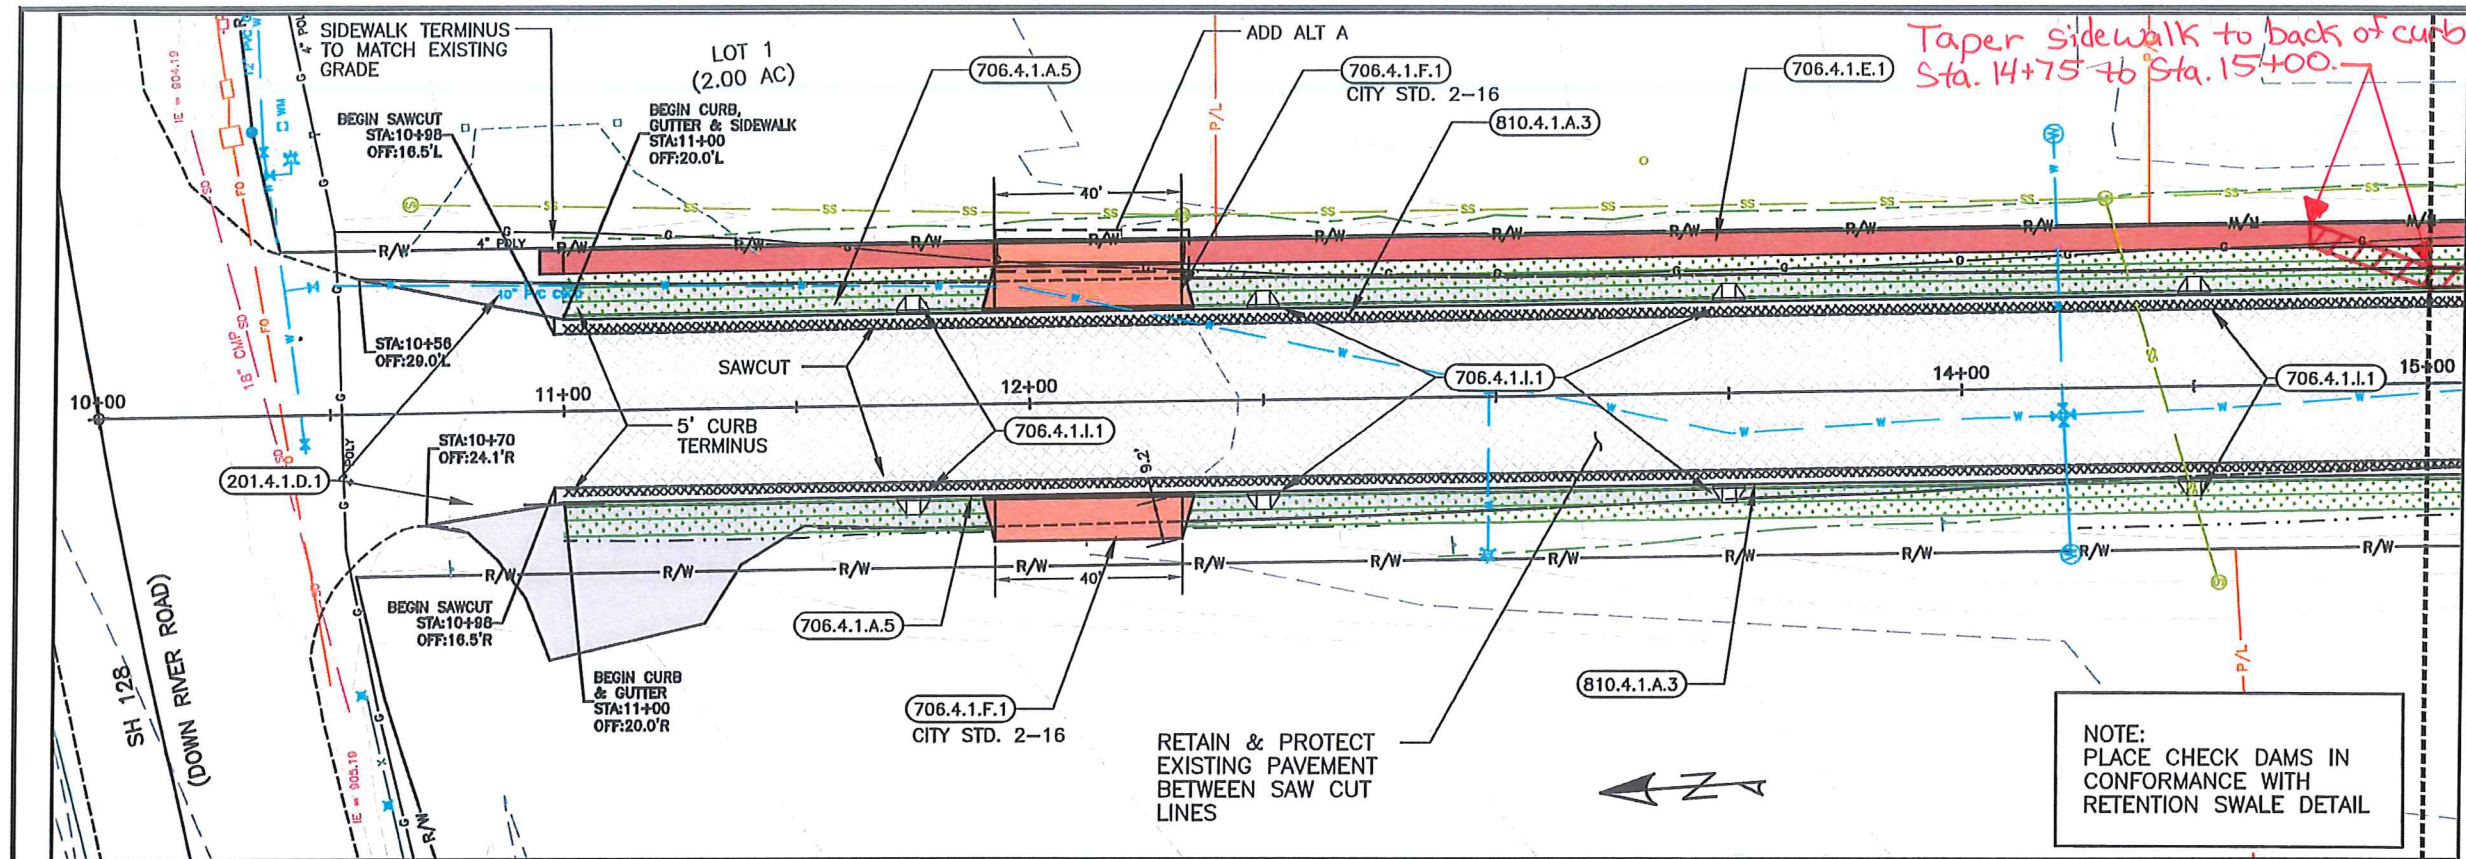

(201.4.1.D.1) REMOVAL OF BITUMINOUS SURFACE	
511 SY	10+70, 24.1'R to 20+00, 10.5'R
796 SY	10+56, 29.0'L to 20+00, 10.5'L
(706.4.1.A.5) STANDARD 6 INCH VERTICAL CURB & GUTTER	
903 FT	11+00, 20.0'R to 20+00, 14.0'R
897 FT	11+00, 20.0'L to 20+00, 14.0'L
(706.4.1.F.1) CONCRETE DRIVEWAY APPROACH	
43 SY	12+12.50, 20.0'R (40' WIDE)
43 SY	12+12.50, 20.0'L (40' WIDE)
43 SY	18+64.00, 20.0'R (40' WIDE)
20 SY	18+64.00, 20.0'L (36' WIDE)
(706.4.1.I.1) INLET APRON	
2 EA	11+75, 20.0'R&L
2 EA	12+50, 20.0'R&L
2 EA	13+50, 20.0'R&L
2 EA	14+50, 20.0'R&L
2-1 EA	15+50, 20.0'R&L
2-1 EA	16+50, 20.0'R&L
2-1 EA	17+50, 20.0'R&L
1 EA	19+00, 19.4'R
1 EA	20+00, 14.0'R
1 EA	16+75, 20'L
1 EA	18+00, 20'L
(810.4.1.A.3) PLANT MIX PAVEMENT (4"thk) SP-3,	
200 SY	11+00, 16.5'R to 20+00, 10.5'R
200 SY	11+00, 16.5'L to 20+00, 10.5'L
44 SY	18+64, 19.5'L

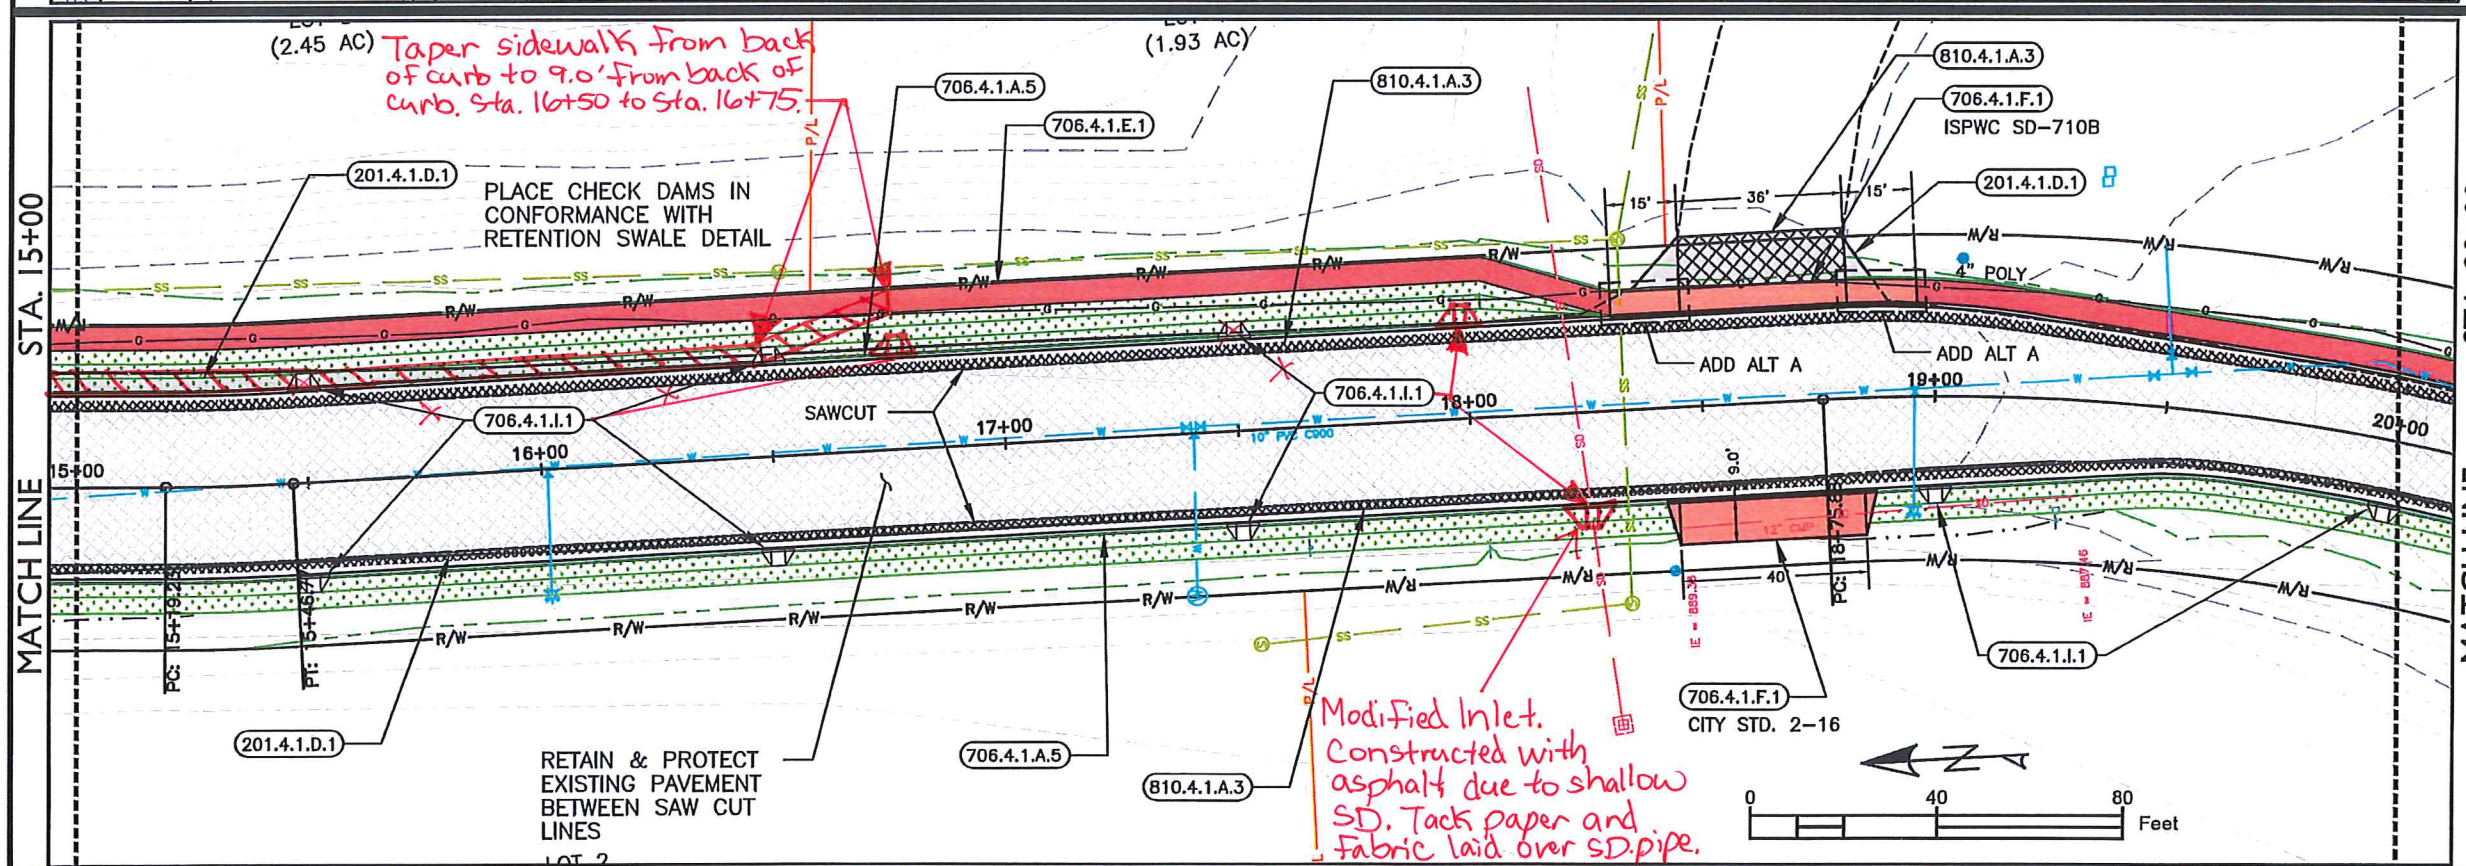

ADD ALT. "A" QUANTITIES SIDEWALK	
(706.4.1.E.1) CONCRETE SIDEWALK	
447 SY	11+00, 23.5'L to 20+00, 14.5'L
(706.4.1.F.1) CONCRETE DRIVEWAY APPROACH	
22 SY	12+12.50, 20.0'L (40' WIDE)
17 SY	18+64.00, 20.0'L (15' RAMPS)
CALLOUT STATION & OFFSETS	
CURB: FACE OF CURB	
INLET APRON: FACE OF CURB	



REVISIONS			
NO.	DATE	DESCRIPTION	BY




215 "D" Street, Lewiston, ID 83501-1930
Phone: 208-746-1316 Fax: 208-746-5595

COLONEL WRIGHT WAY STREET IMPROVEMENTS

PLAN

SCALE: 1" = 40'	
DESIGNED BY: A. BAILEY	
DRAWN BY: B. STEWART	
CHECKED BY: S. STUBBERS	
SHEET SET: CW-WAY	
DATE: 11-01-2017	
DRAWING NO.: C-1	
SHEET 6 OF 13	

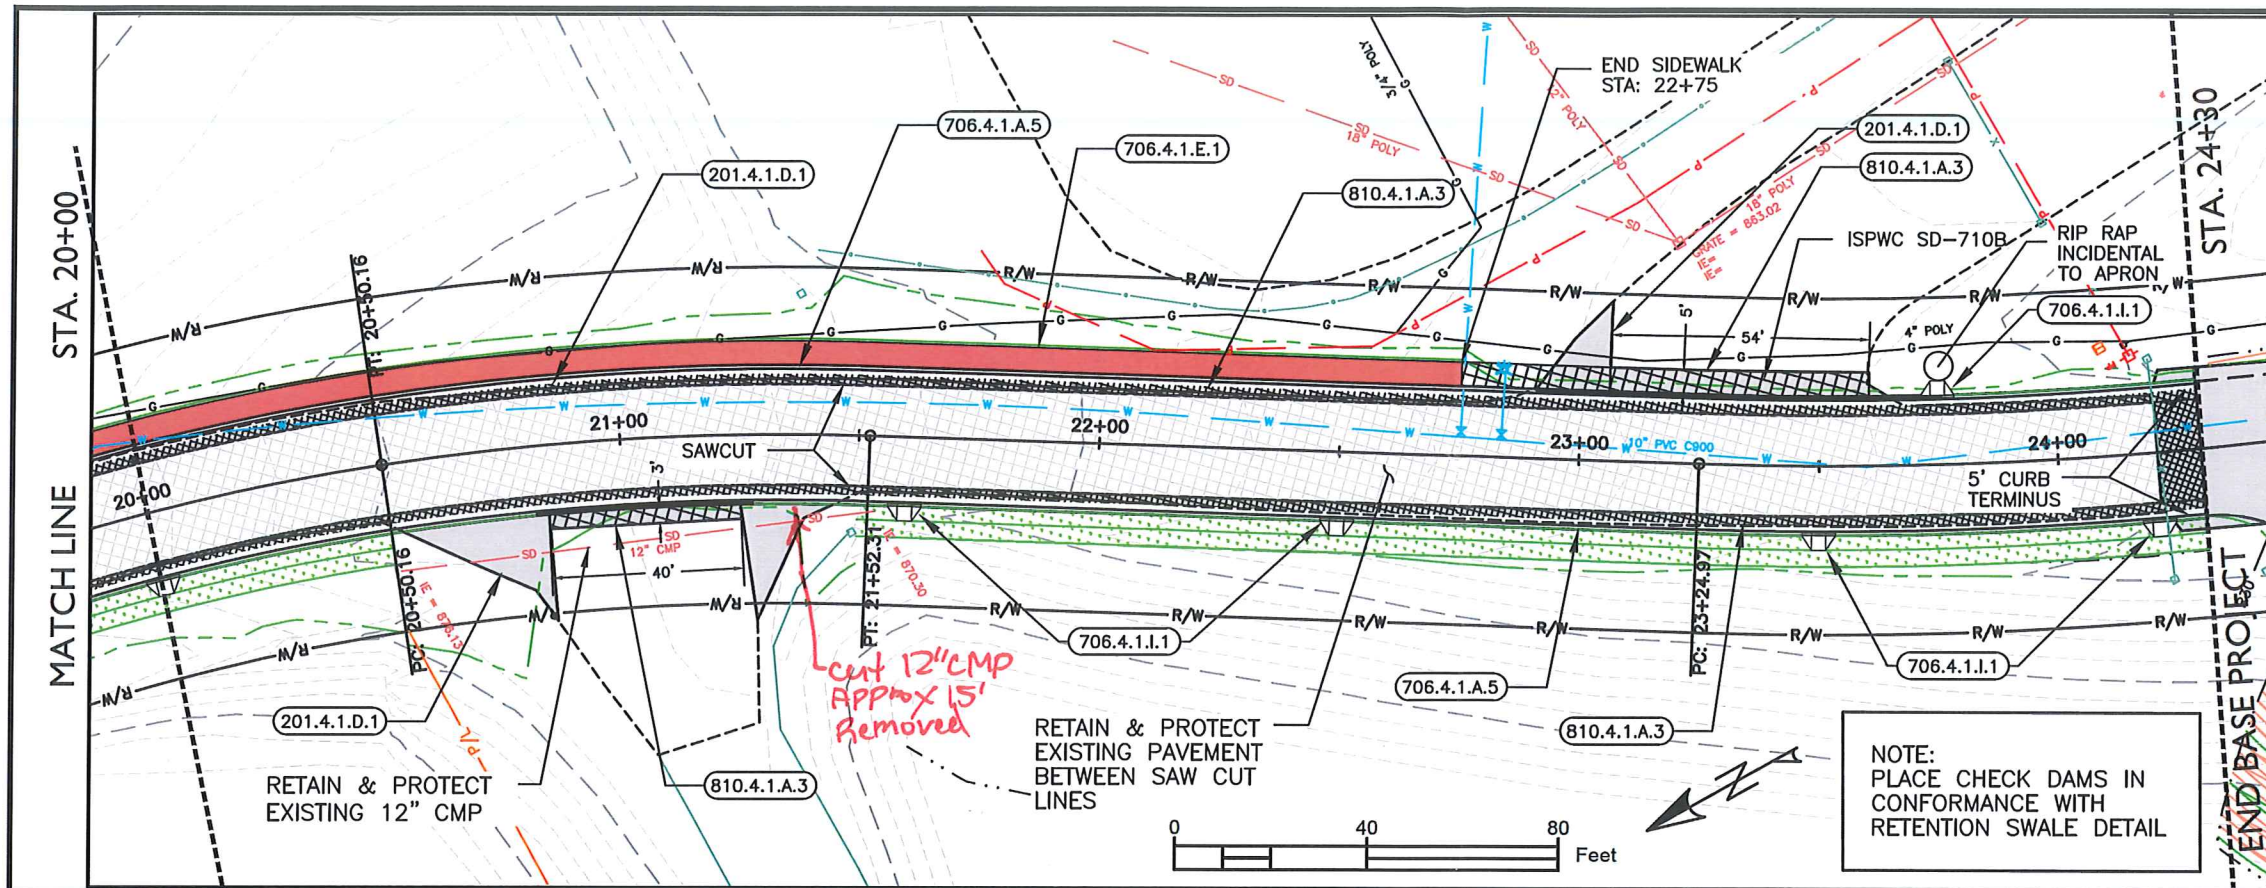

201.4.1.D.1 REMOVAL OF BITUMINOUS SURFACE

191 SY 20+00, 10.5'R to 24+30, 10.5'R
156 SY 20+00, 10.5'L to 24+30, 10.5'L

706.4.1.A.5 STANDARD 6 INCH VERTICAL CURB & GUTTER

428 LF 20+00, 14.0'R to 24+30, 14.0'R
432 LF 20+00, 14.0'L to 24+30, 14.0'L

706.4.1.1.1 INLET APRON

1 EA 21+60, 14.0'R
1 EA 22+50, 14.0'R
1 EA 23+50, 14.0'R
1 EA 23+75, 14.0'L
1 EA 24+20, 14.0'R

810.4.1.A.3 PLANT MIX PAVEMENT (4"thk) SP-3,

95 SY 20+00, 10.5'R to 24+30, 10.5'R
96 SY 20+00, 10.5'L to 24+30, 10.5'L
21 SY 24+20, 0.0'L&R to 24+30, 10.5'L&R
14 SY 21+05, 14.5'R
47 SY 22+75, 14.5'L to 23+60, 14.5'L

ADD ALT. "A" QUANTITIES SIDEWALK

706.4.1.E.1 CONCRETE SIDEWALK

156 SY 20+00, 14.5'L to 22+75, 14.5'L

ADD ALT. "B" QUANTITIES CUL-DE-SAC

201.4.1.D.1 REMOVAL OF BITUMINOUS SURFACE

560 SY 23+30 to 25+30



601.4.1.A.17 STORM DRAIN PIPE, 12" CPP

106 LF 24+44, 24.0'R - 25+48, 22.2'R


2030.4.1.C.1 VALVE BOX, ADJUST TO GRADE

1 EA 24+88, 3.9'L
1 EA 24+92, 3.3'R
1 EA 24+96, 3.8'L


CALLOUT STATION & OFFSETS
CURB: FACE OF CURB
INLET APRON: FACE OF CURB

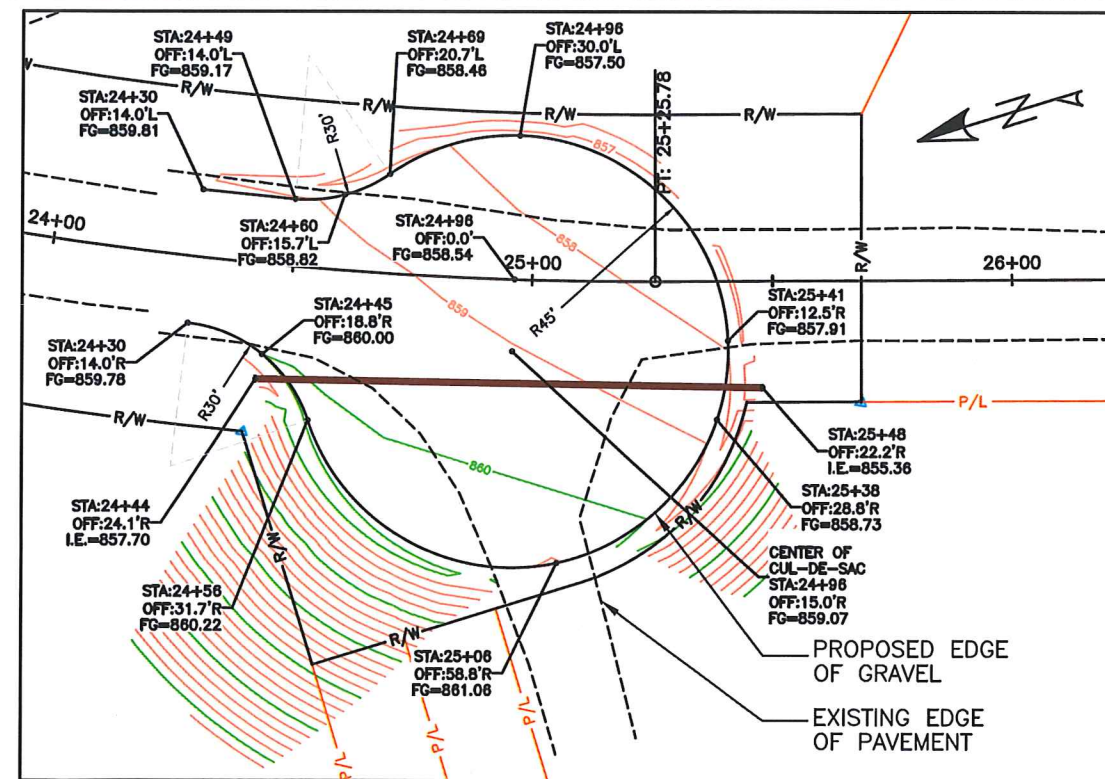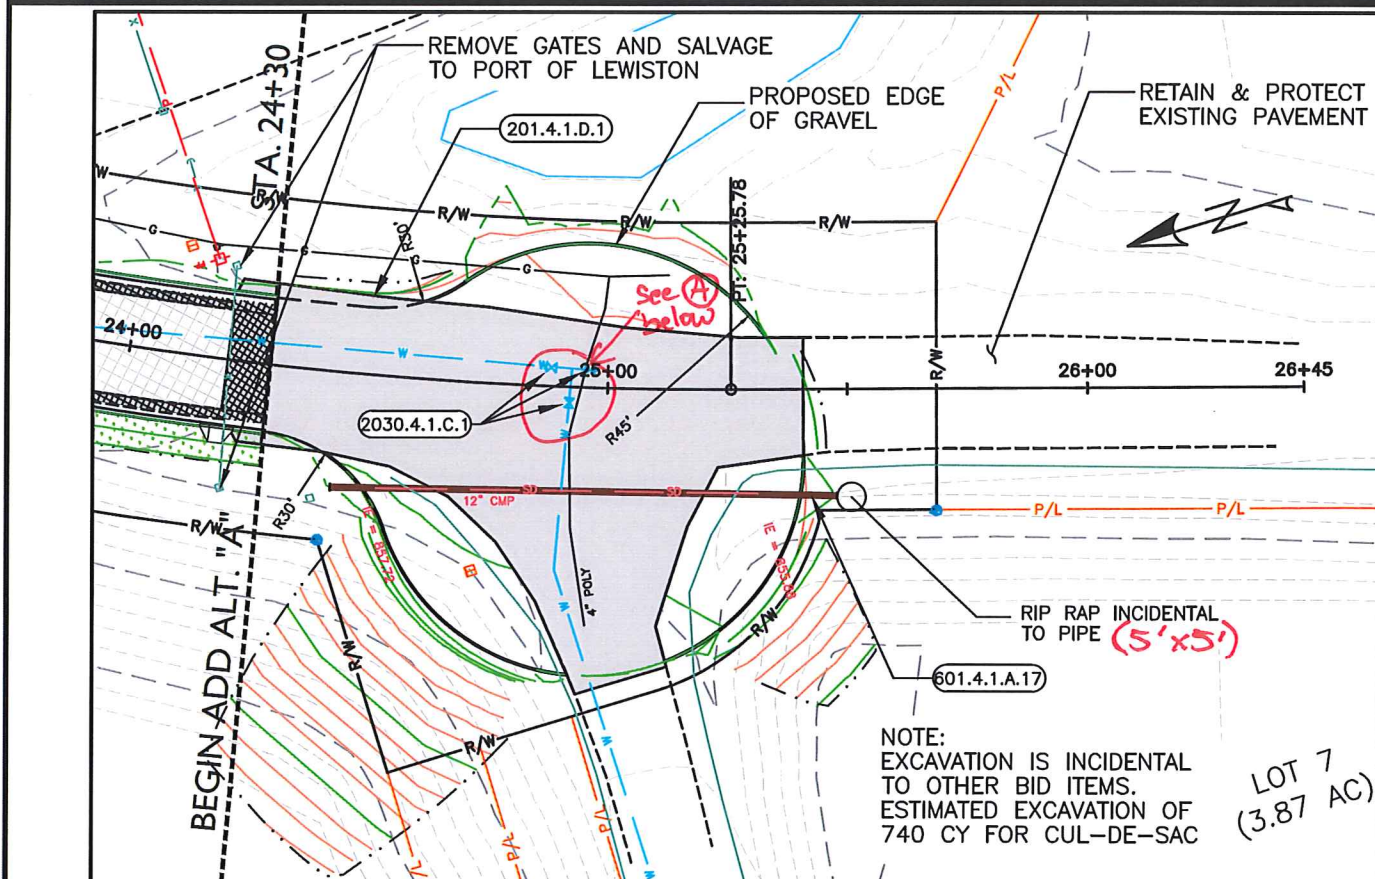

CUL-DE-SAC GRADING DETAIL

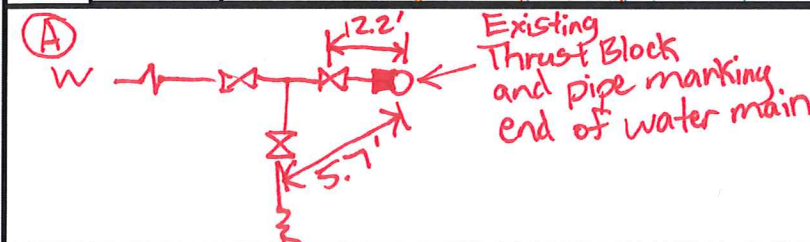

REVISIONS			
NO.	DATE	DESCRIPTION	BY


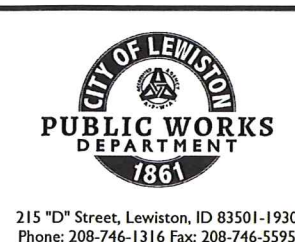


COLONEL WRIGHT WAY STREET IMPROVEMENTS

PLAN

SCALE: 1"=40'
DESIGNED BY: A. BAILEY
DRAWN BY: B. STEWART
CHECKED BY: S. STUBBERS
SHEET SET: CW-WAY
DATE: 11-01-2017
DRAWING NO.: C-2
SHEET 7 OF 13

File Name: j:\CAPITAL\Streets\TR043 TransferStation_Access Rd-Col Wright Way\dwg\Production Drawings\PLAN & PROFILE.dwg Printed 11/1/2017 11:30 AM By Bruce Stewart

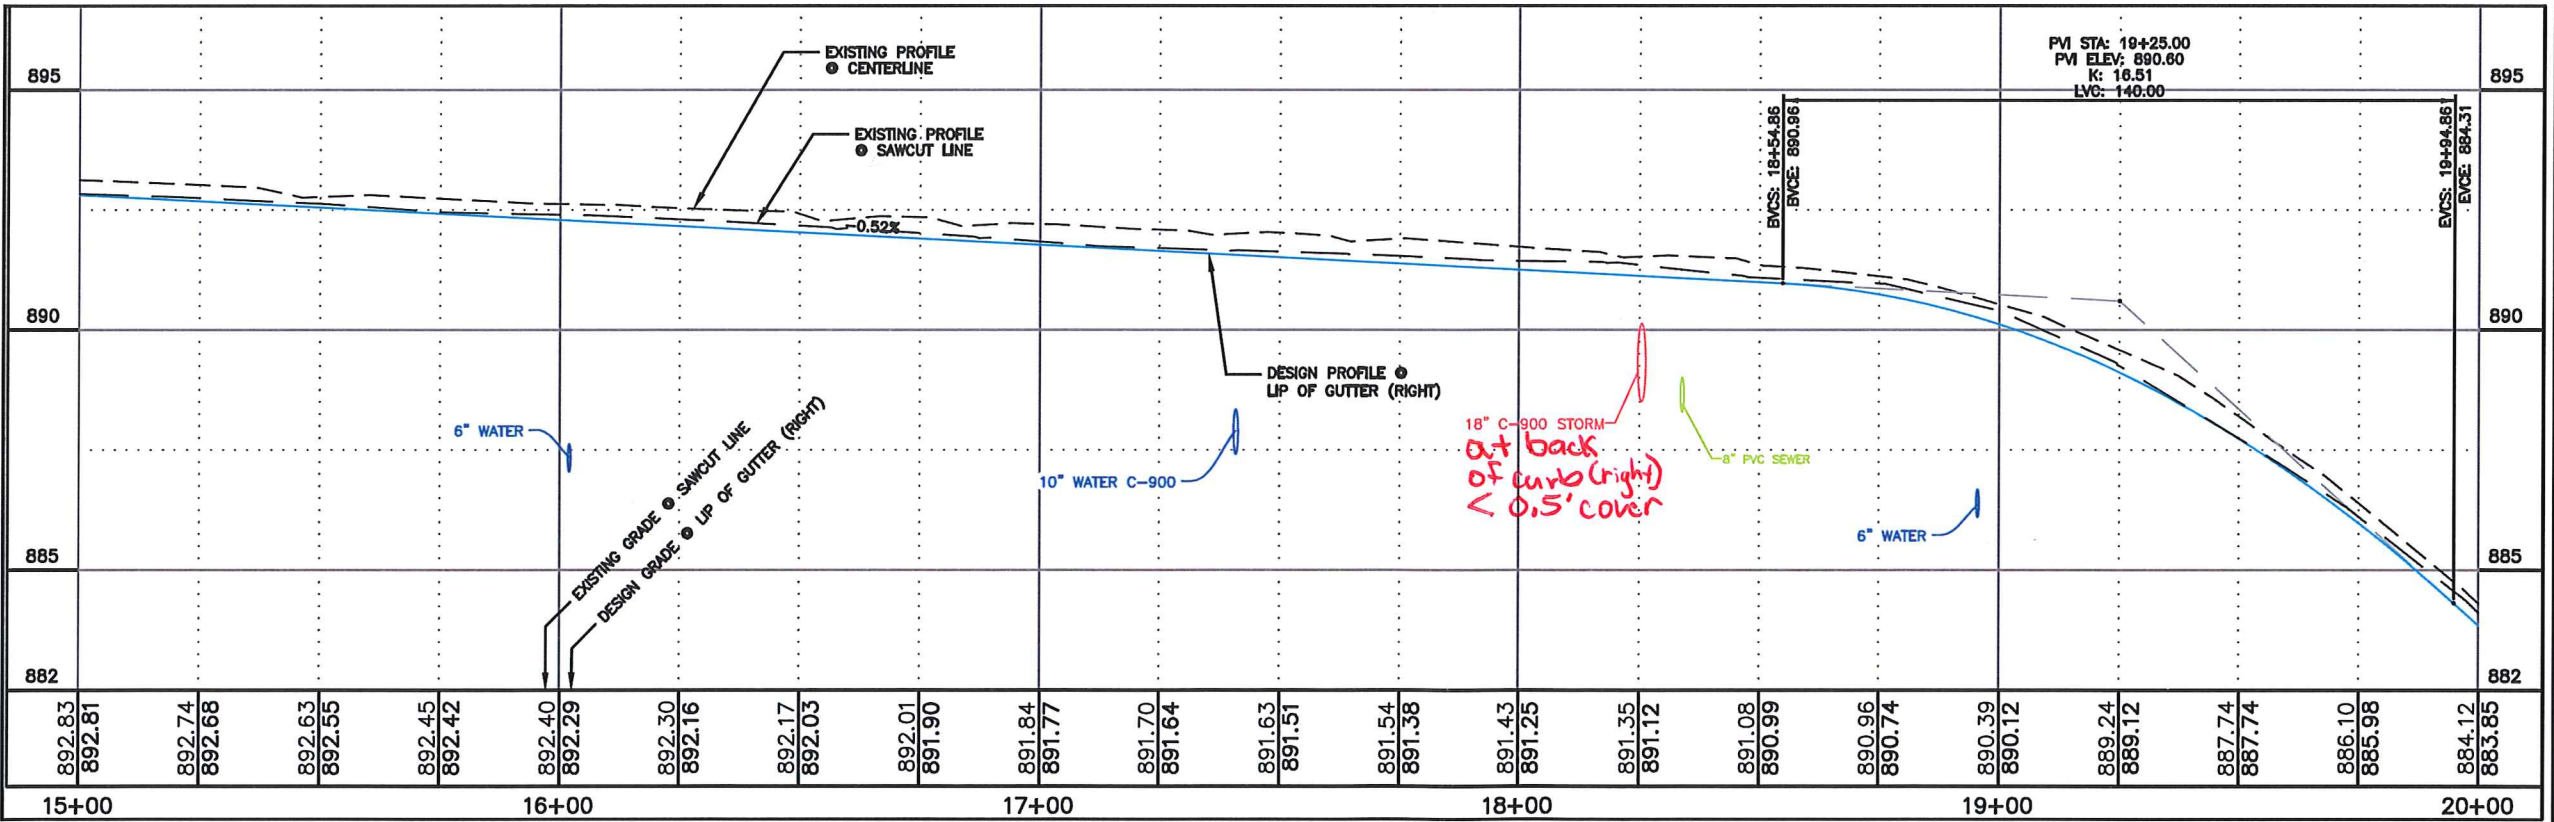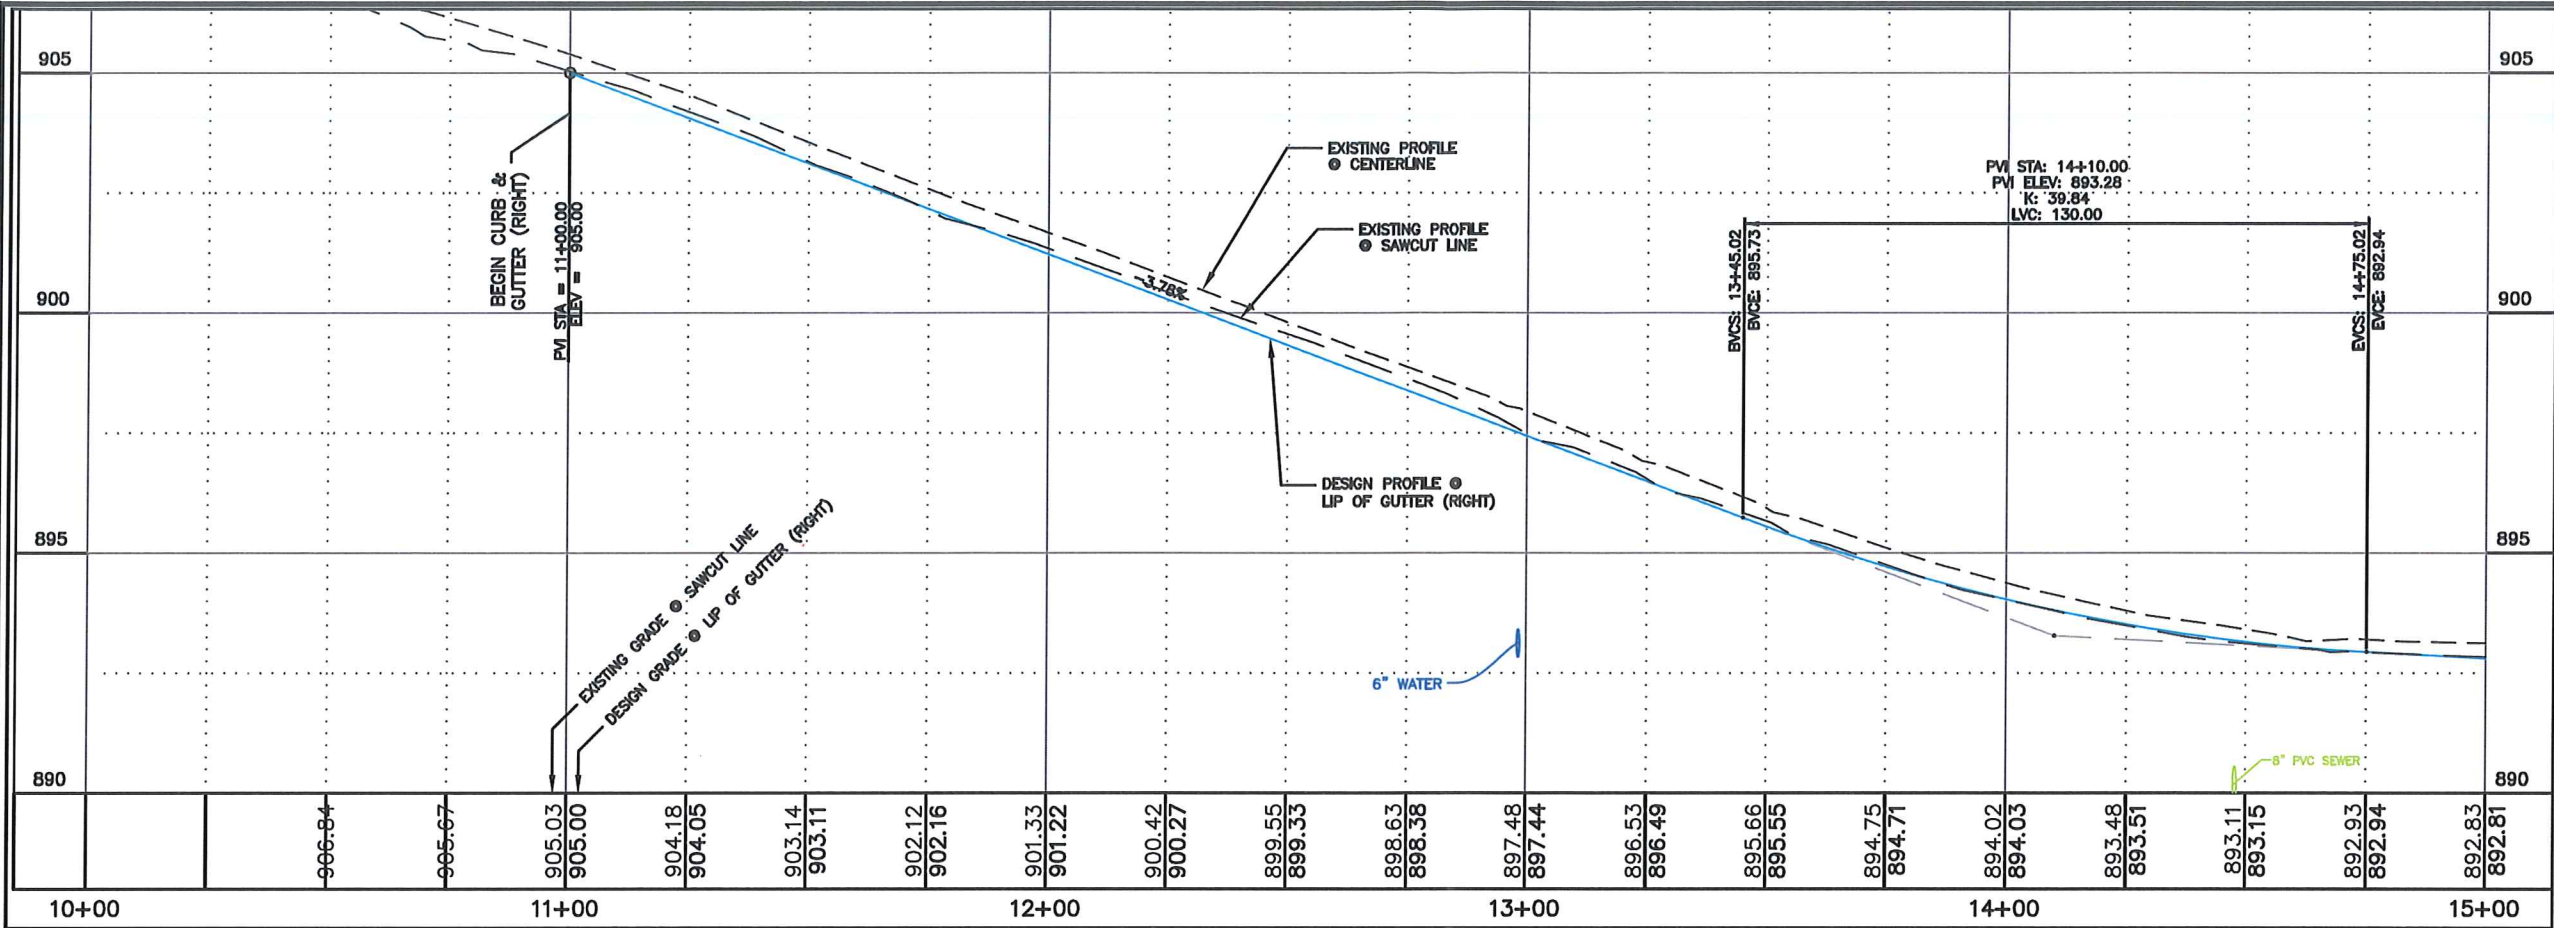

REVISIONS			
NO.	DATE	DESCRIPTION	BY




215 "D" Street, Lewiston, ID 83501-1930
Phone: 208-746-1316 Fax: 208-746-5595

COLONEL WRIGHT WAY STREET IMPROVEMENTS

PROFILE CURB & GUTTER RIGHT

SCALE: 1" = 40'
DESIGNED BY: A. BAILEY
DRAWN BY: B. STEWART
CHECKED BY: S. STUBBERS
SHEET SET: CW-WAY
DATE: 11-01-2017
DRAWING NO.: C-3
SHEET 8 OF 13

File Name: j:\CAPITAL\Streets\TR043 TransferStation_Access Rd-Col Wright Way\dwg\Production Drawings\PLAN & PROFILE.dwg Printed 11/1/2017 11:31 AM By Bruce Stewart

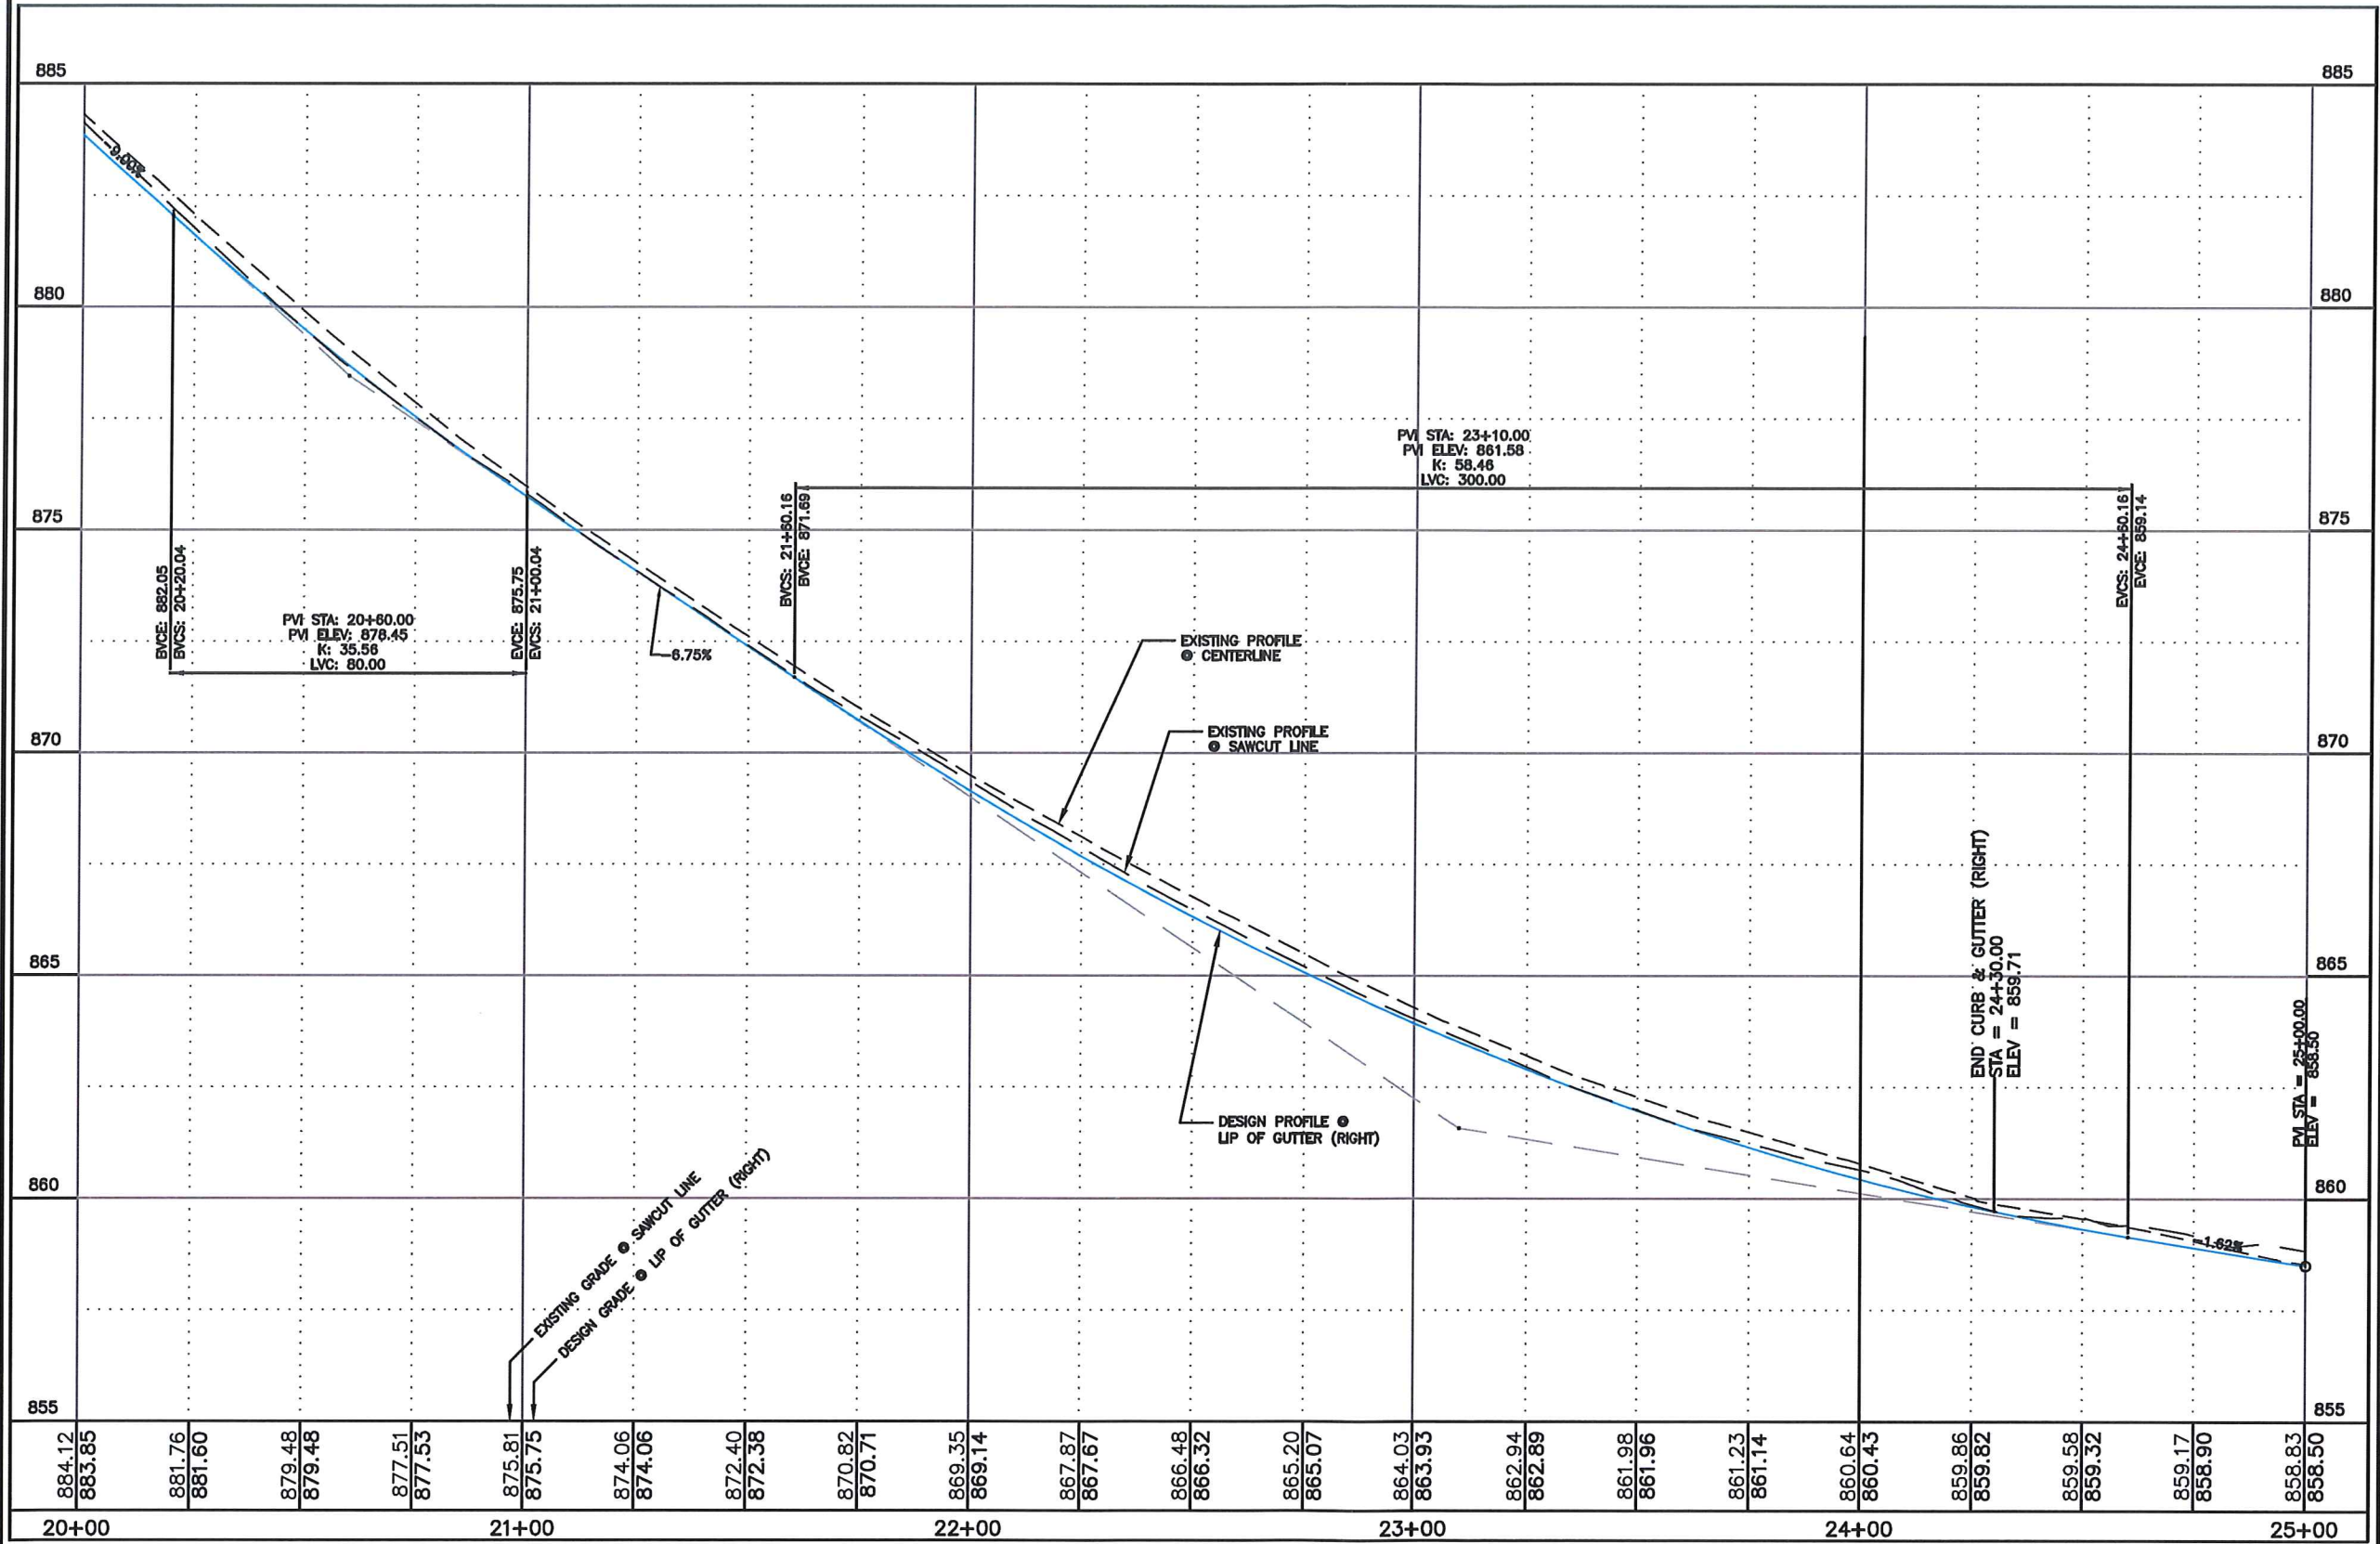

REVISIONS			
NO.	DATE	DESCRIPTION	BY





215 "D" Street, Lewiston, ID 83501-1930
Phone: 208-746-1316 Fax: 208-746-5595

**COLONEL WRIGHT WAY
STREET IMPROVEMENTS**

PROFILE CURB & GUTTER RIGHT

SCALE: 1" = 40'
DESIGNED BY: A. BAILEY
DRAWN BY: B. STEWART
CHECKED BY: S. STUBBERS
SHEET SET: CW-WAY
DATE: 11-01-2017
DRAWING NO.: C-4
SHEET 9 OF 13

File Name J:\CAPITAL\Streets\TR043 TransferStation_Access Rd-Col\Wright Way\dwg\Production Drawings\PLAN & PROFILE.dwg Printed 11/11/2017 11:31 AM By Bruce Stewart

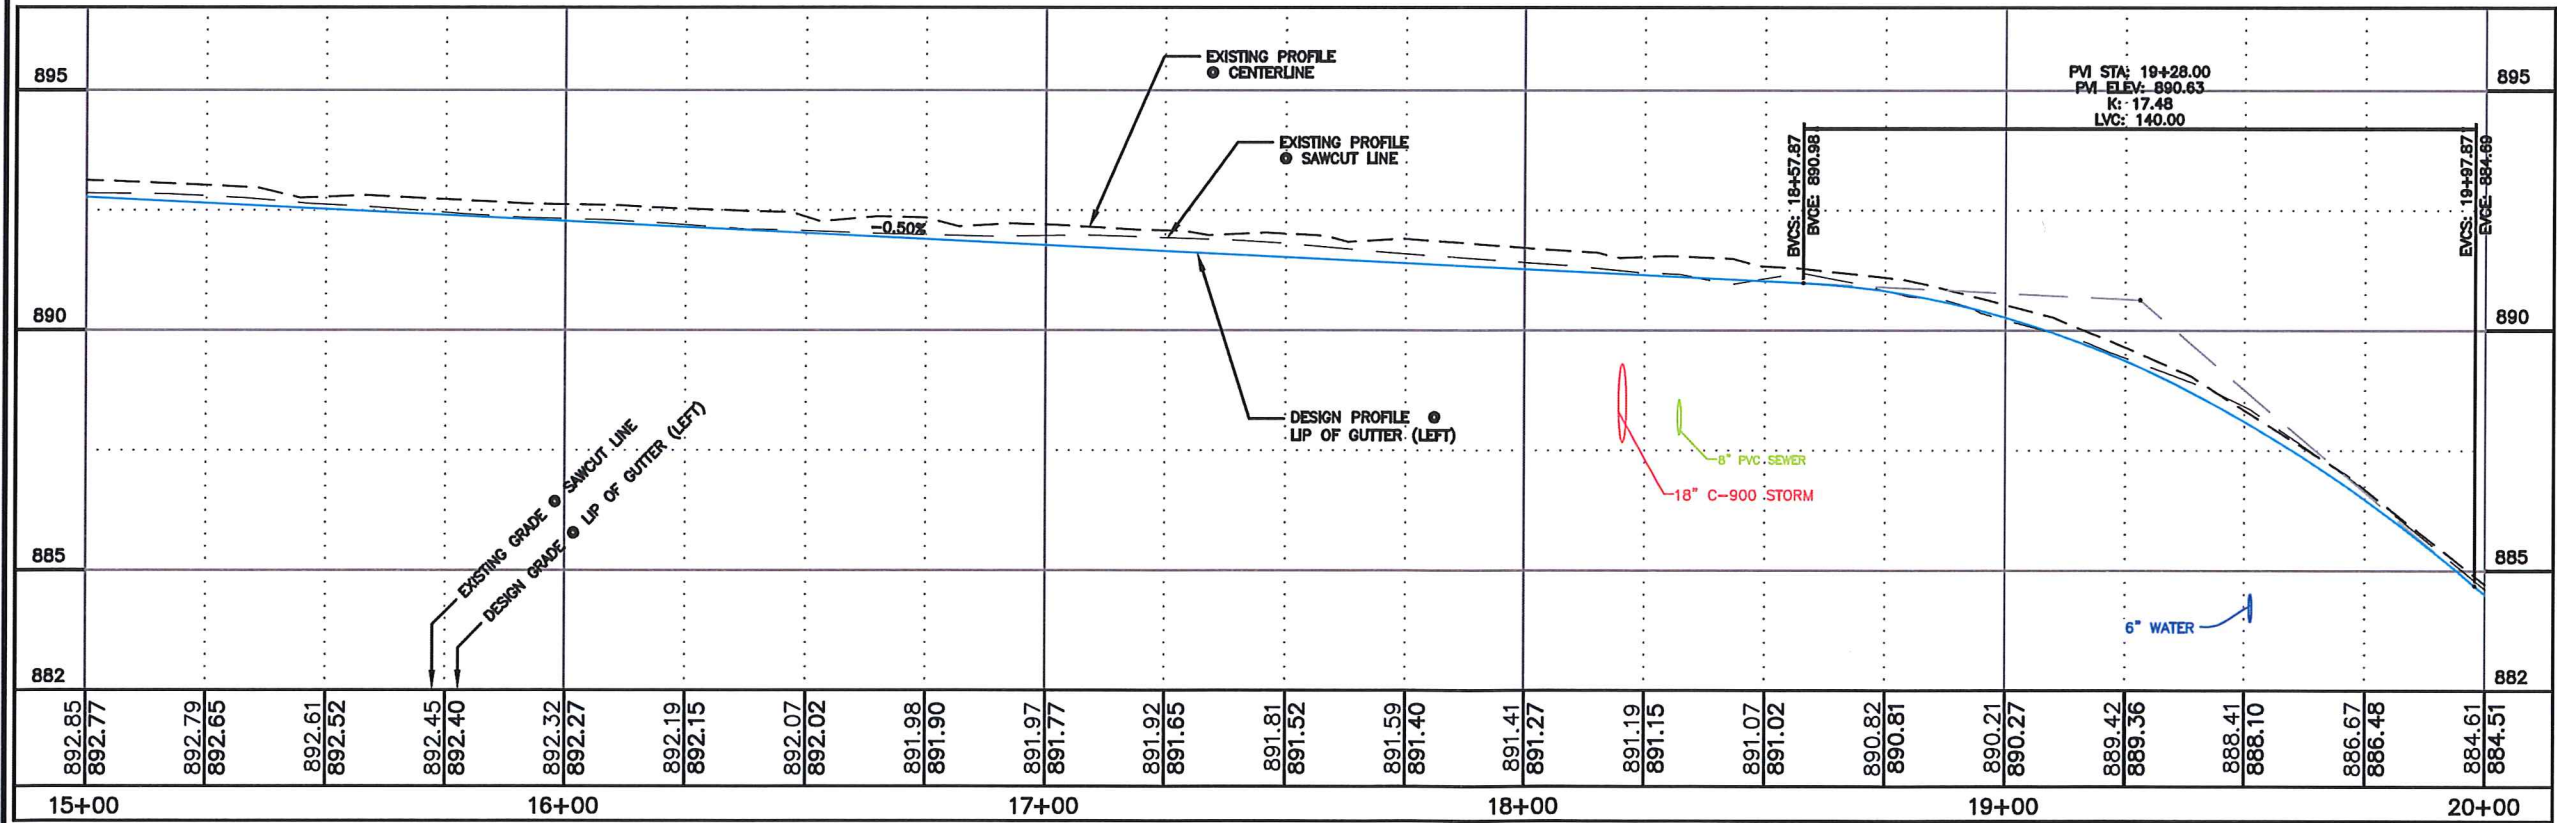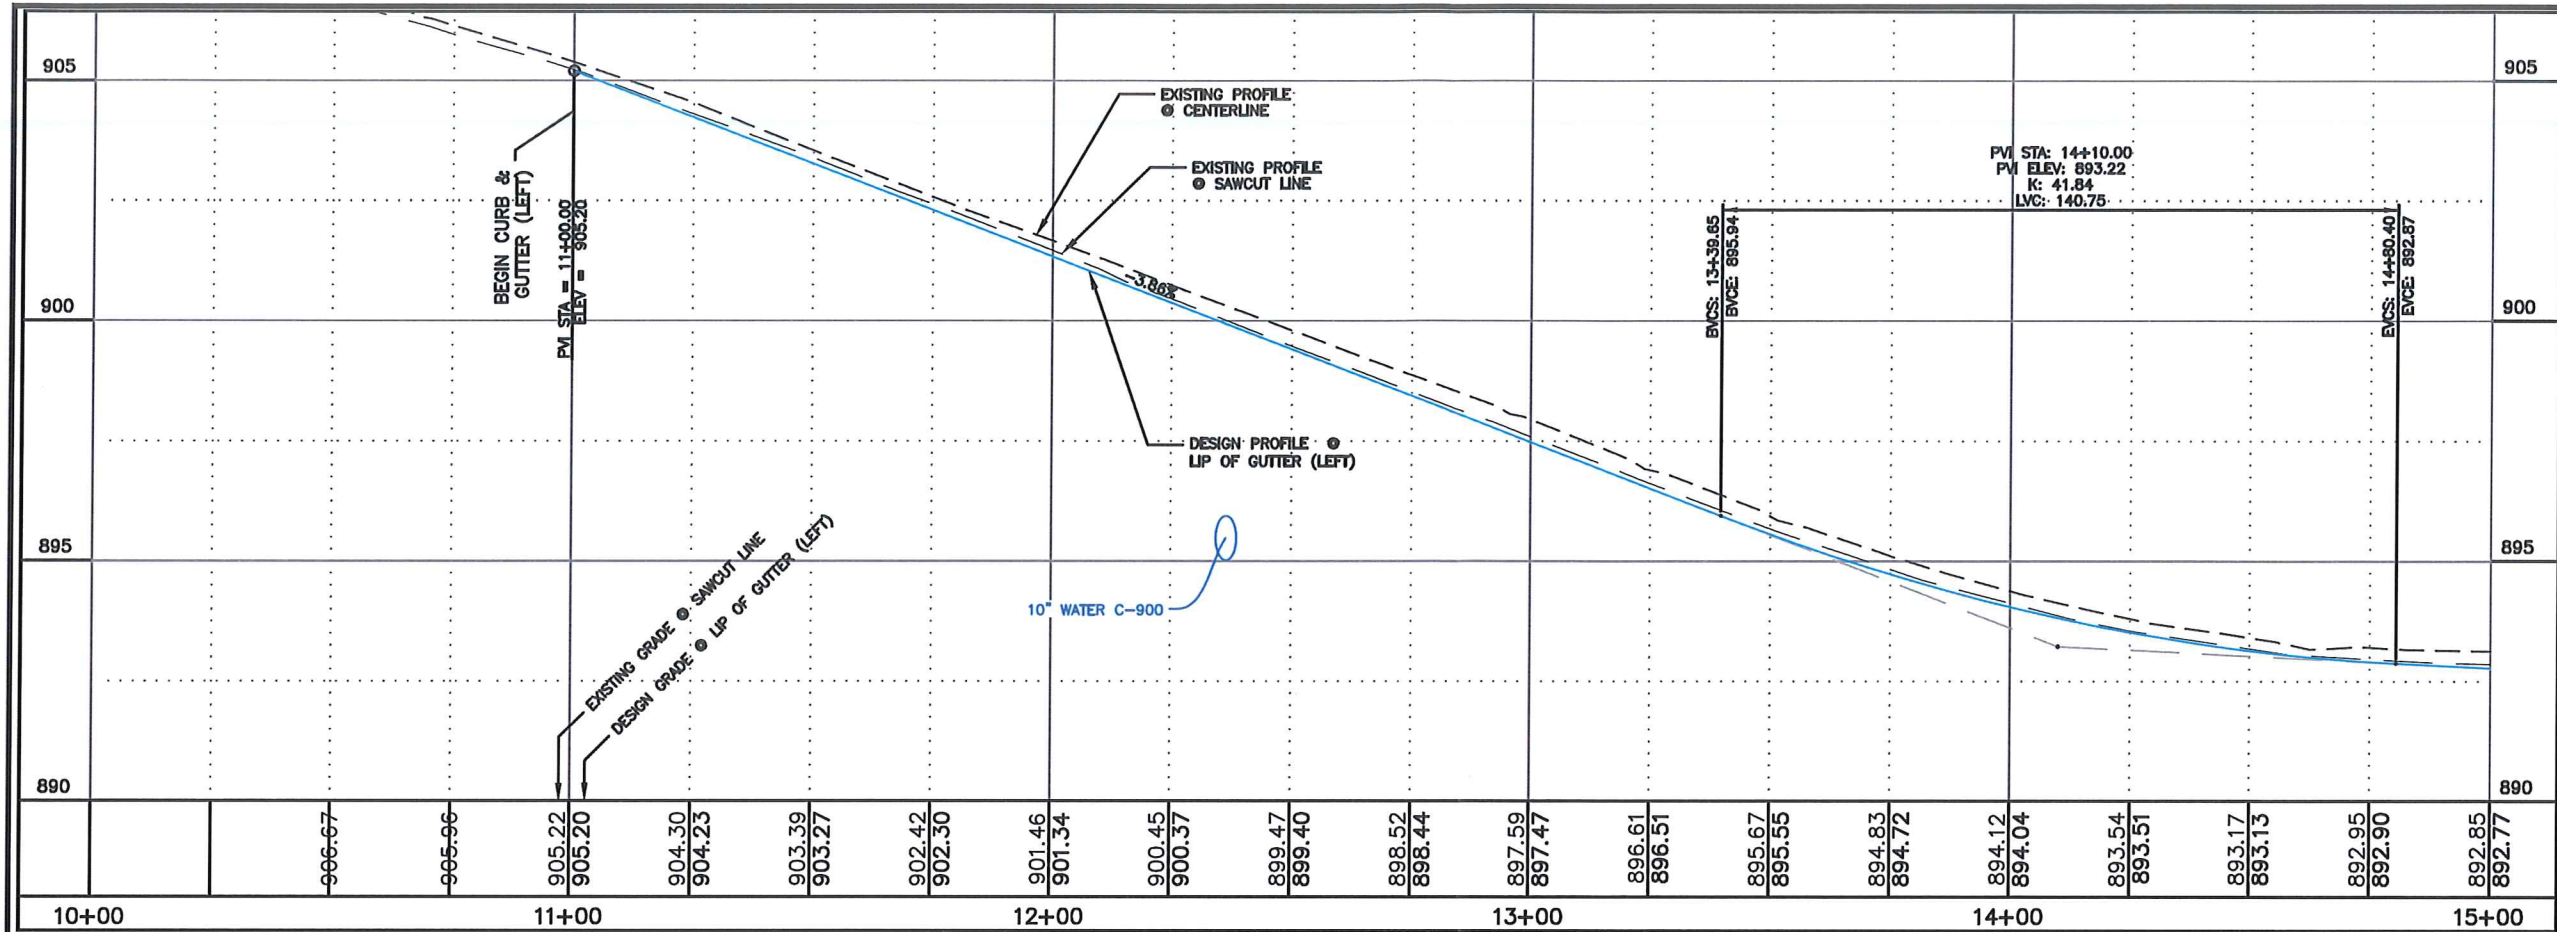

REVISIONS			
NO.	DATE	DESCRIPTION	BY




215 "D" Street, Lewiston, ID 83501-1930
Phone: 208-746-1316 Fax: 208-746-5595

COLONEL WRIGHT WAY
STREET IMPROVEMENTS

PROFILE CURB & GUTTER LEFT

SCALE: 1" = 40'
DESIGNED BY: A. BAILEY
DRAWN BY: B. STEWART
CHECKED BY: S. STUBBERS
SHEET SET: CW-WAY
DATE: 11-01-2017
DRAWING NO.: C-5
SHEET 10 OF 13

File Name: J:\CAPITAL\Streets\TR043 TransferStation_Access Rd-Col Wright Way\dwg\Production Drawings\PLAN & PROFILE.dwg Printed 11/1/2017 11:31 AM By: Bruce Stewart

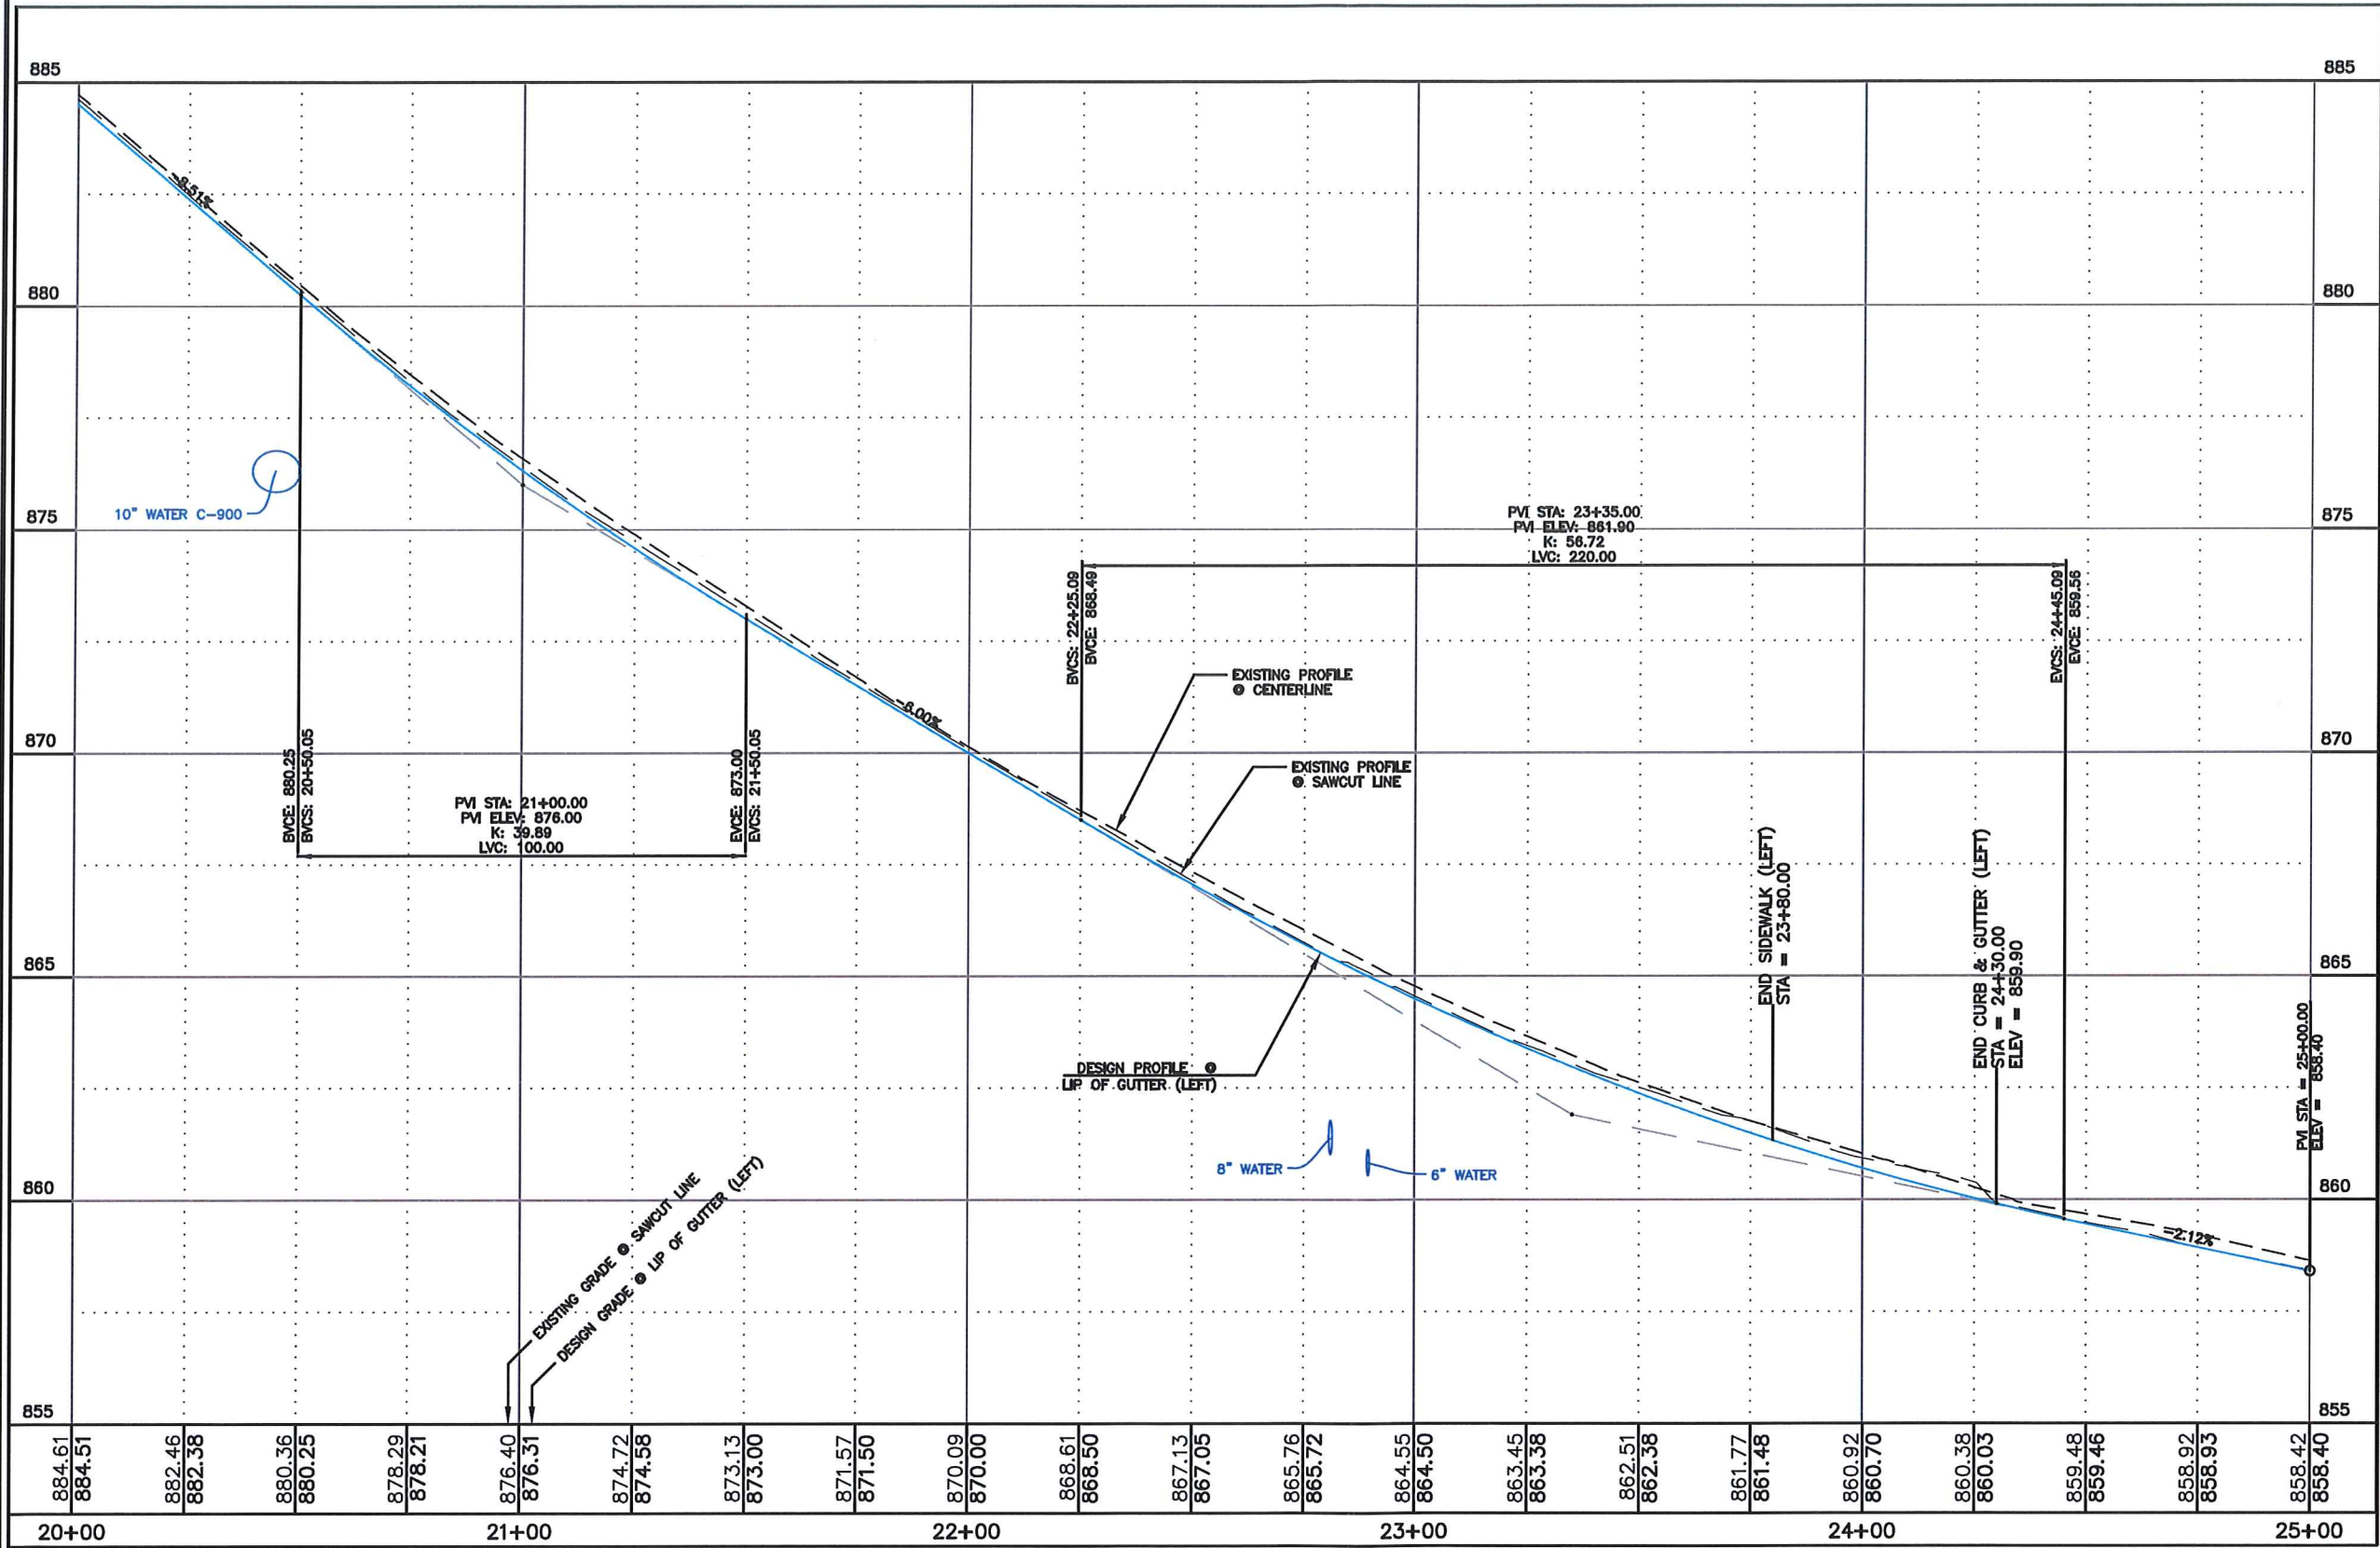

REVISIONS			
NO.	DATE	DESCRIPTION	BY




215 "D" Street, Lewiston, ID 83501-1930
Phone: 208-746-1316 Fax: 208-746-5595

COLONEL WRIGHT WAY
STREET IMPROVEMENTS

PROFILE CURB & GUTTER LEFT

SCALE: 1" = 40'
DESIGNED BY: A. BAILEY
DRAWN BY: B. STEWART
CHECKED BY: S. STUBBERS
SHEET SET: CW-WAY
DATE: 11-01-2017
DRAWING NO.: C-6
SHEET 11 OF 13

File Name: j:\CAPITAL\Streets\TR043 Transfer Station_Access Rd.Col Wright Way.dwg\Production Drawings\TRAFFIC.dwg Printed 11/1/2017 11:34 AM By Bruce Stewart

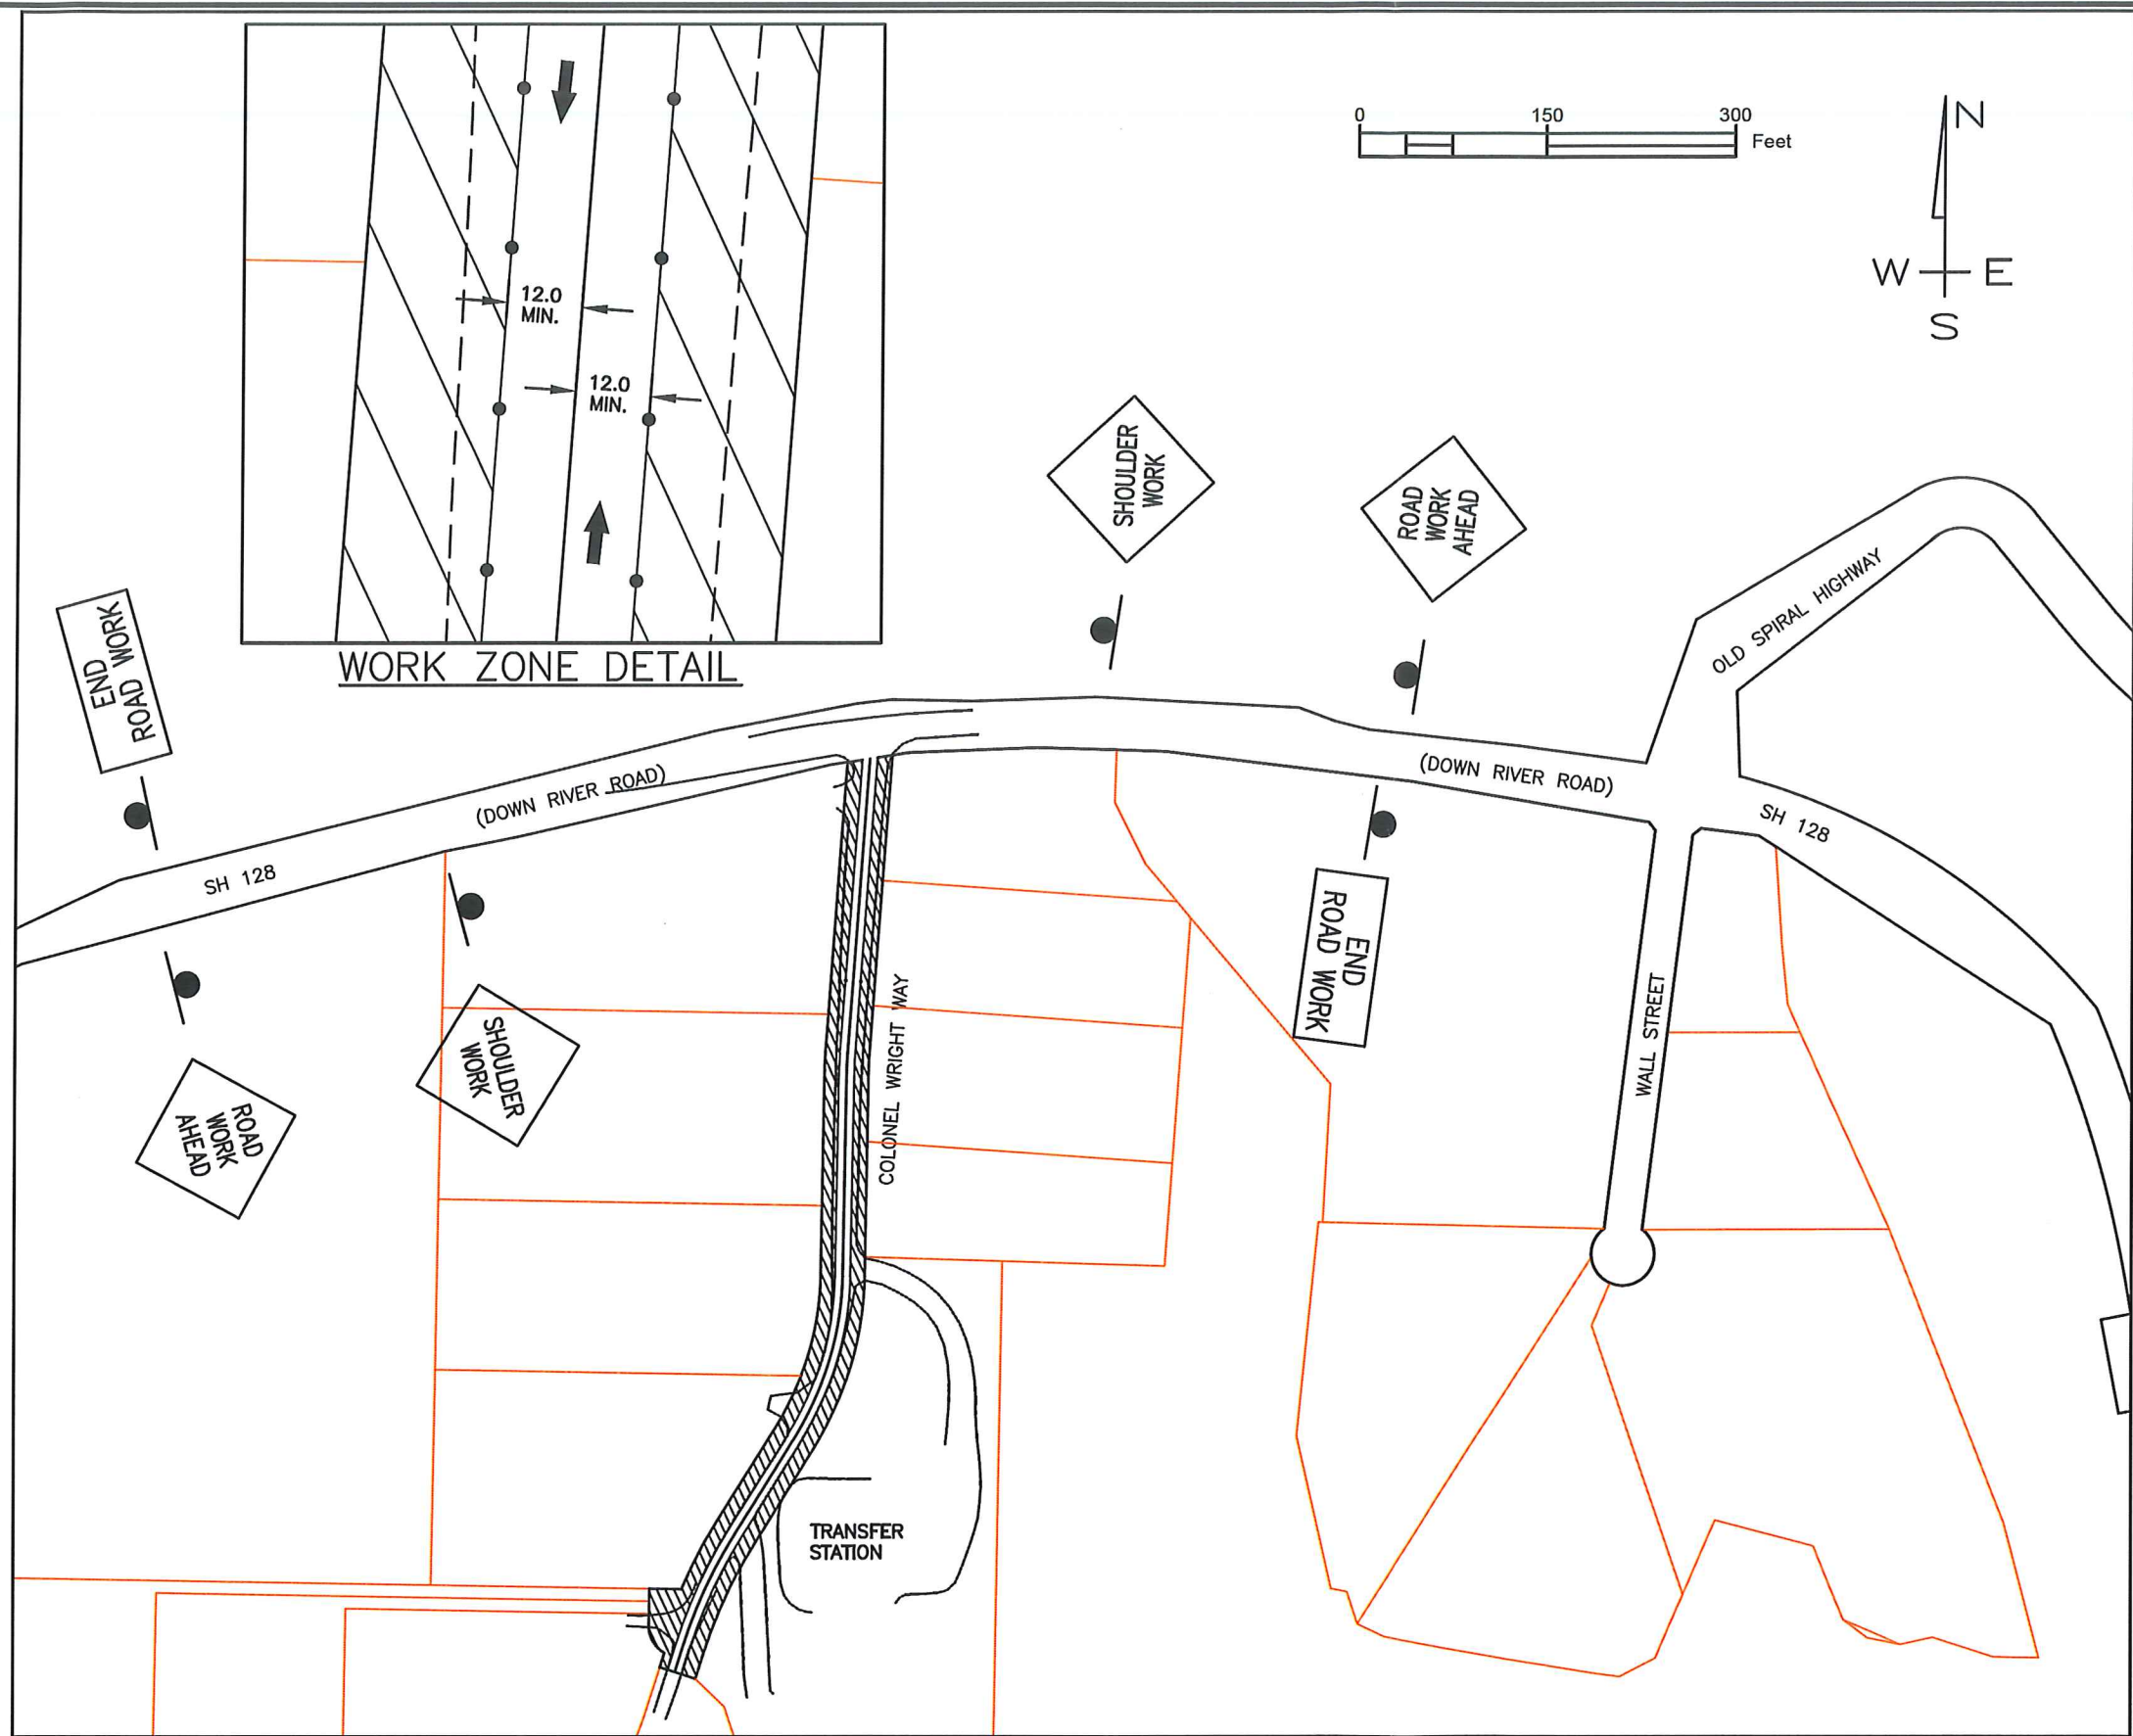

NOTES:


1. CONSTRUCTION SHALL BE PHASED TO PROVIDE ACCESS TO ACTIVE PARCELS. ACCESS TO BOTH ENTRANCES TO THE TRANSFER STATION SHALL BE MAINTAINED AT ALL TIMES.

LEGEND

- WORK ZONE
- SIGN
- CHANNELIZING DEVICE
- TYPE III BARRICADES

TRAFFIC CONTROL SIGNS

- ROAD WORK AHEAD W20-1 48" x 48"
- SHOULDER WORK W21-5a 48" x 48"
- END ROAD WORK G20-2 48" x 24"

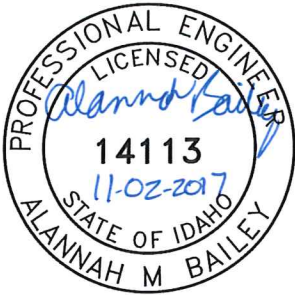

REVISIONS			
NO.	DATE	DESCRIPTION	BY



215 "D" Street, Lewiston, ID 83501-1930
Phone: 208-746-1316 Fax: 208-746-5595

COLONEL WRIGHT WAY
STREET IMPROVEMENTS

TEMPORARY TRAFFIC CONTROL PLAN

SCALE: AS SHOWN
DESIGNED BY: A. BAILEY
DRAWN BY: B. STEWART
CHECKED BY: S. STUBBERS
SHEET SET: CW-WAY
DATE: 11-01-2017
DRAWING NO.: C-7
SHEET 12 OF 13

			REVISIONS		 215 "D" Street, Lewiston, ID 83501-1930 Phone: 208-746-1316 Fax: 208-746-5595	COLONEL WRIGHT WAY STREET IMPROVEMENTS	SCALE: 1" = 60'
							DESIGNED BY: A. BAILEY
							DRAWN BY: B. STEWART
							CHECKED BY: S. STUBBERS
							SHEET SET: CW-WAY
							DATE: 11-01-2017
							DRAWING NO.: C-8
	NO.	DATE	DESCRIPTION	BY		SIGNING & MARKING PLAN	SHEET 13 OF 13