


- DESIGN NOTES:**
1. THE CONTRACTOR SHALL GRADE THE SITE AS SHOWN BY THE DRAINAGE ARROWS (SEE NOTE 2) IN ORDER TO PROVIDE DRAINAGE TO THE PROPOSED STORM DRAIN STRUCTURES AND CAPTURE RUNOFF.
 2. THE CONTRACTOR SHALL FIELD VERIFY THE LOCATION AND DEPTH OF THE EXISTING 12\"/>

GENERAL NOTES:

1. A TOPOGRAPHIC OR BOUNDARY SURVEY WAS NOT COMPLETED FOR THIS PROJECT. THE SITE BASEMAP WAS OBTAINED FROM GOOGLE MAPS AND NEIGHBORHOOD ASSESSOR PARCEL MAP. SCALE IS APPROXIMATE.
2. THE CONTRACTOR SHALL INVESTIGATE ON SITE AND VERIFY ALL CONDITIONS AND DIMENSIONS OF THE PROJECT AND SHALL NOTIFY THE ENGINEER OF ANY DISCREPANCY REQUIRING MODIFICATION PRIOR TO PROCEEDING.
3. THE CONTRACTOR SHALL COORDINATE THE WORK SCHEDULE SO AS TO HAVE A MINIMAL IMPACT ON THE EXISTING TRAFFIC.
4. THE CONTRACTOR SHALL TAKE ALL NECESSARY PREVENTATIVE MEASURES TO PROTECT THE EXISTING IMPROVEMENTS. ANY DAMAGE SHALL BE REPLACED AT NO COST TO THE OWNER.
5. A RIGHT-OF-WAY PERMIT SHALL BE OBTAINED BY THE CITY OF LEWISTON PUBLIC WORKS DEPARTMENT PRIOR TO ANY WORK BEGINNING WITHIN PUBLIC RIGHT-OF-WAY.
6. THE CONTRACTOR SHALL PAY FOR AND SECURE ALL NECESSARY PERMITS AND FEES.
7. ALL WORK SHALL CONFORM TO STATE AND LOCAL CODES AND CONFORM TO THE CITY OF LEWISTON STANDARD DRAWINGS AND IDAHO STANDARDS FOR PUBLIC WORKS CONSTRUCTION (ISPW) EXCEPT AS OTHERWISE SPECIFIED OR APPROVED BY THE ENGINEER. ALL CONSTRUCTION NOT SPECIFICALLY MENTIONED OR SHOWN SHALL CONFORM TO CITY LEWISTON ORDINANCES AND STANDARDS.

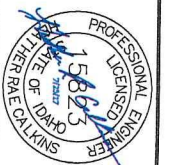

REV	DATE	REVISION

DRAWN BY: HRC
DESIGNED BY: HRC
DATE: 07/25/17
QUALITY CHECK: L14-046
JOB NO.
FIELDBOOK

BOYER STORAGE - STORMWATER MANAGEMENT PLAN
1724 IDAHO STREET - LEWISTON, ID

SITE PLAN