
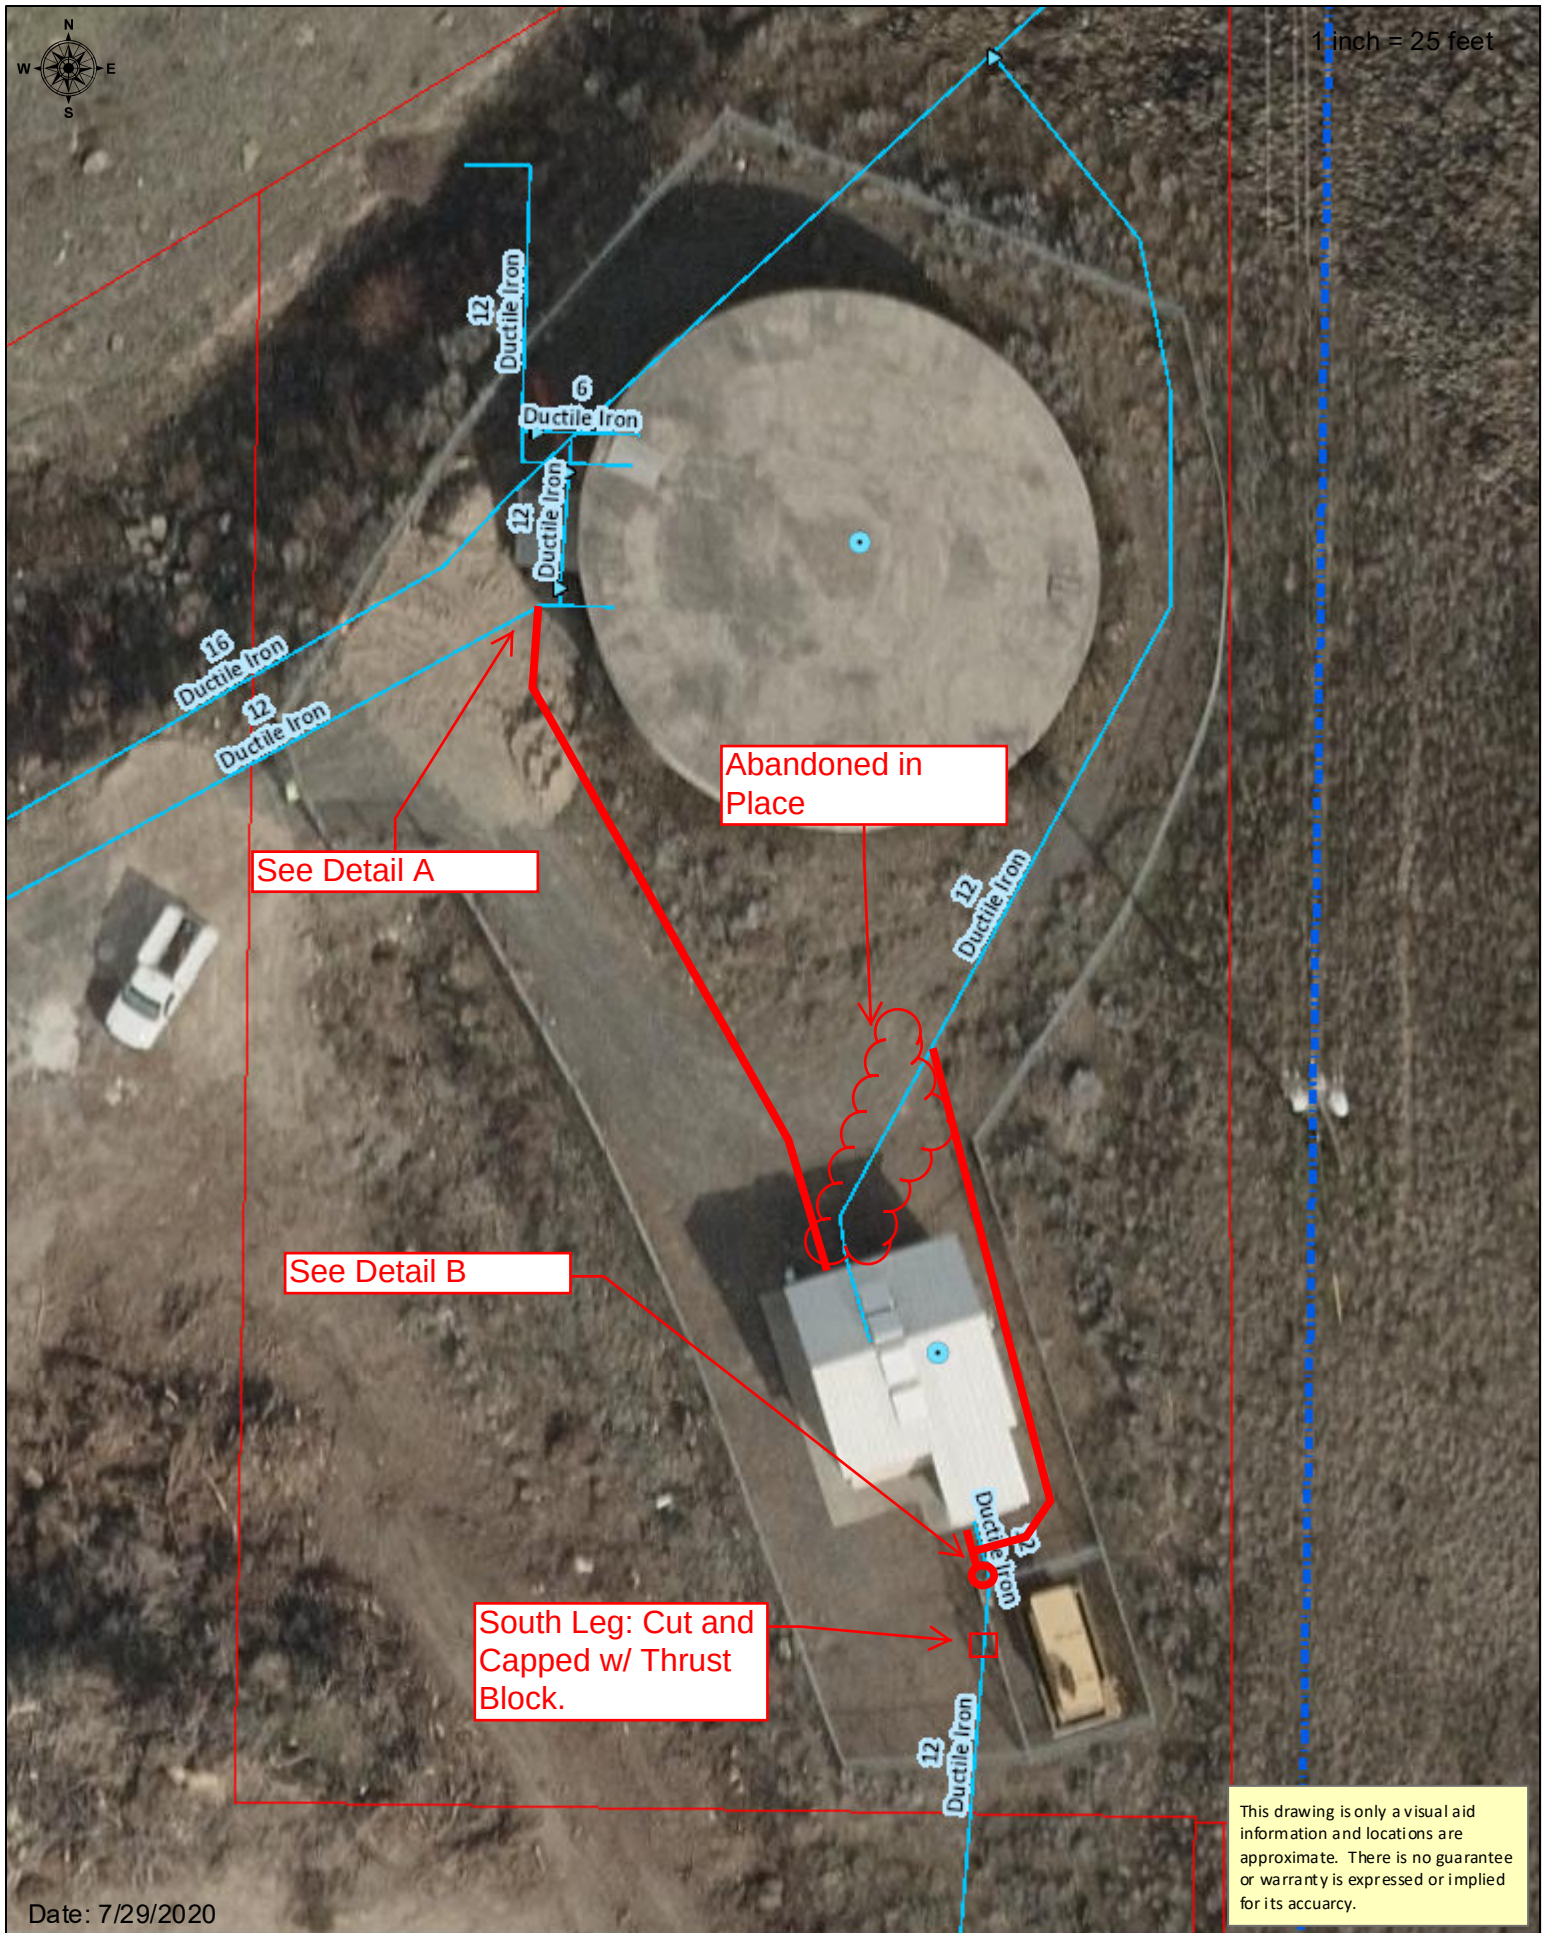


City of Lewiston

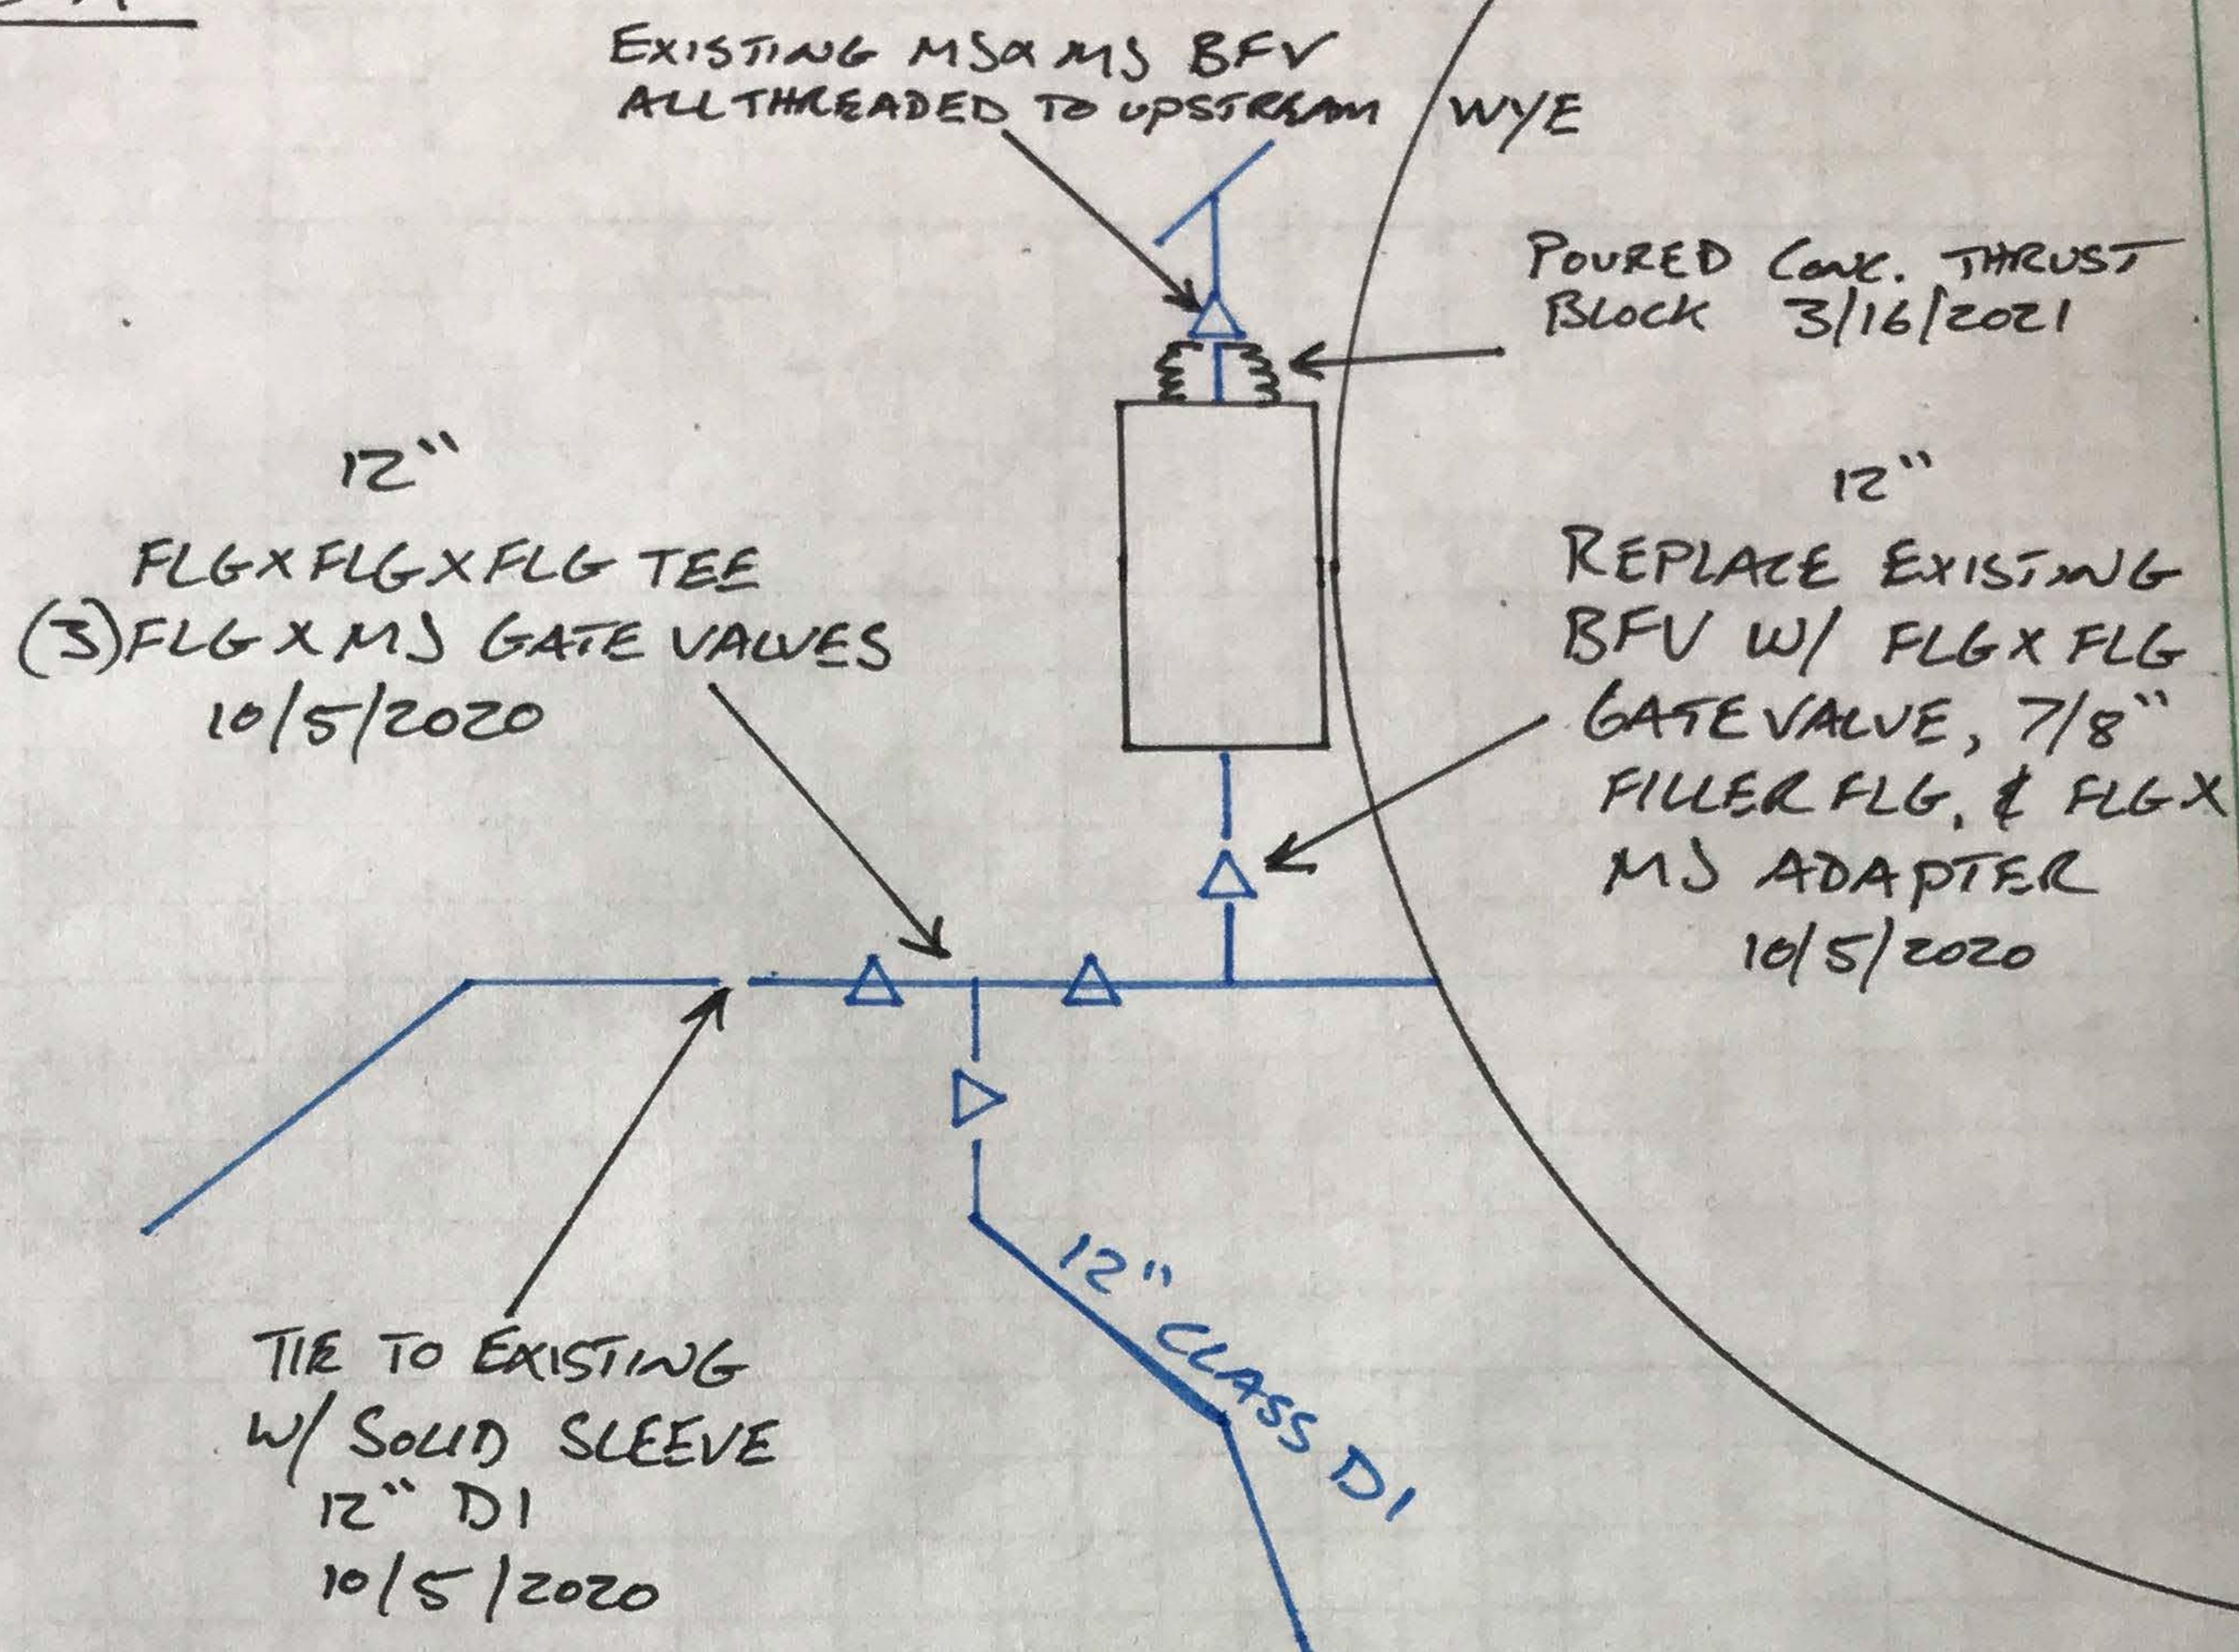

DETAIL ADETAIL B