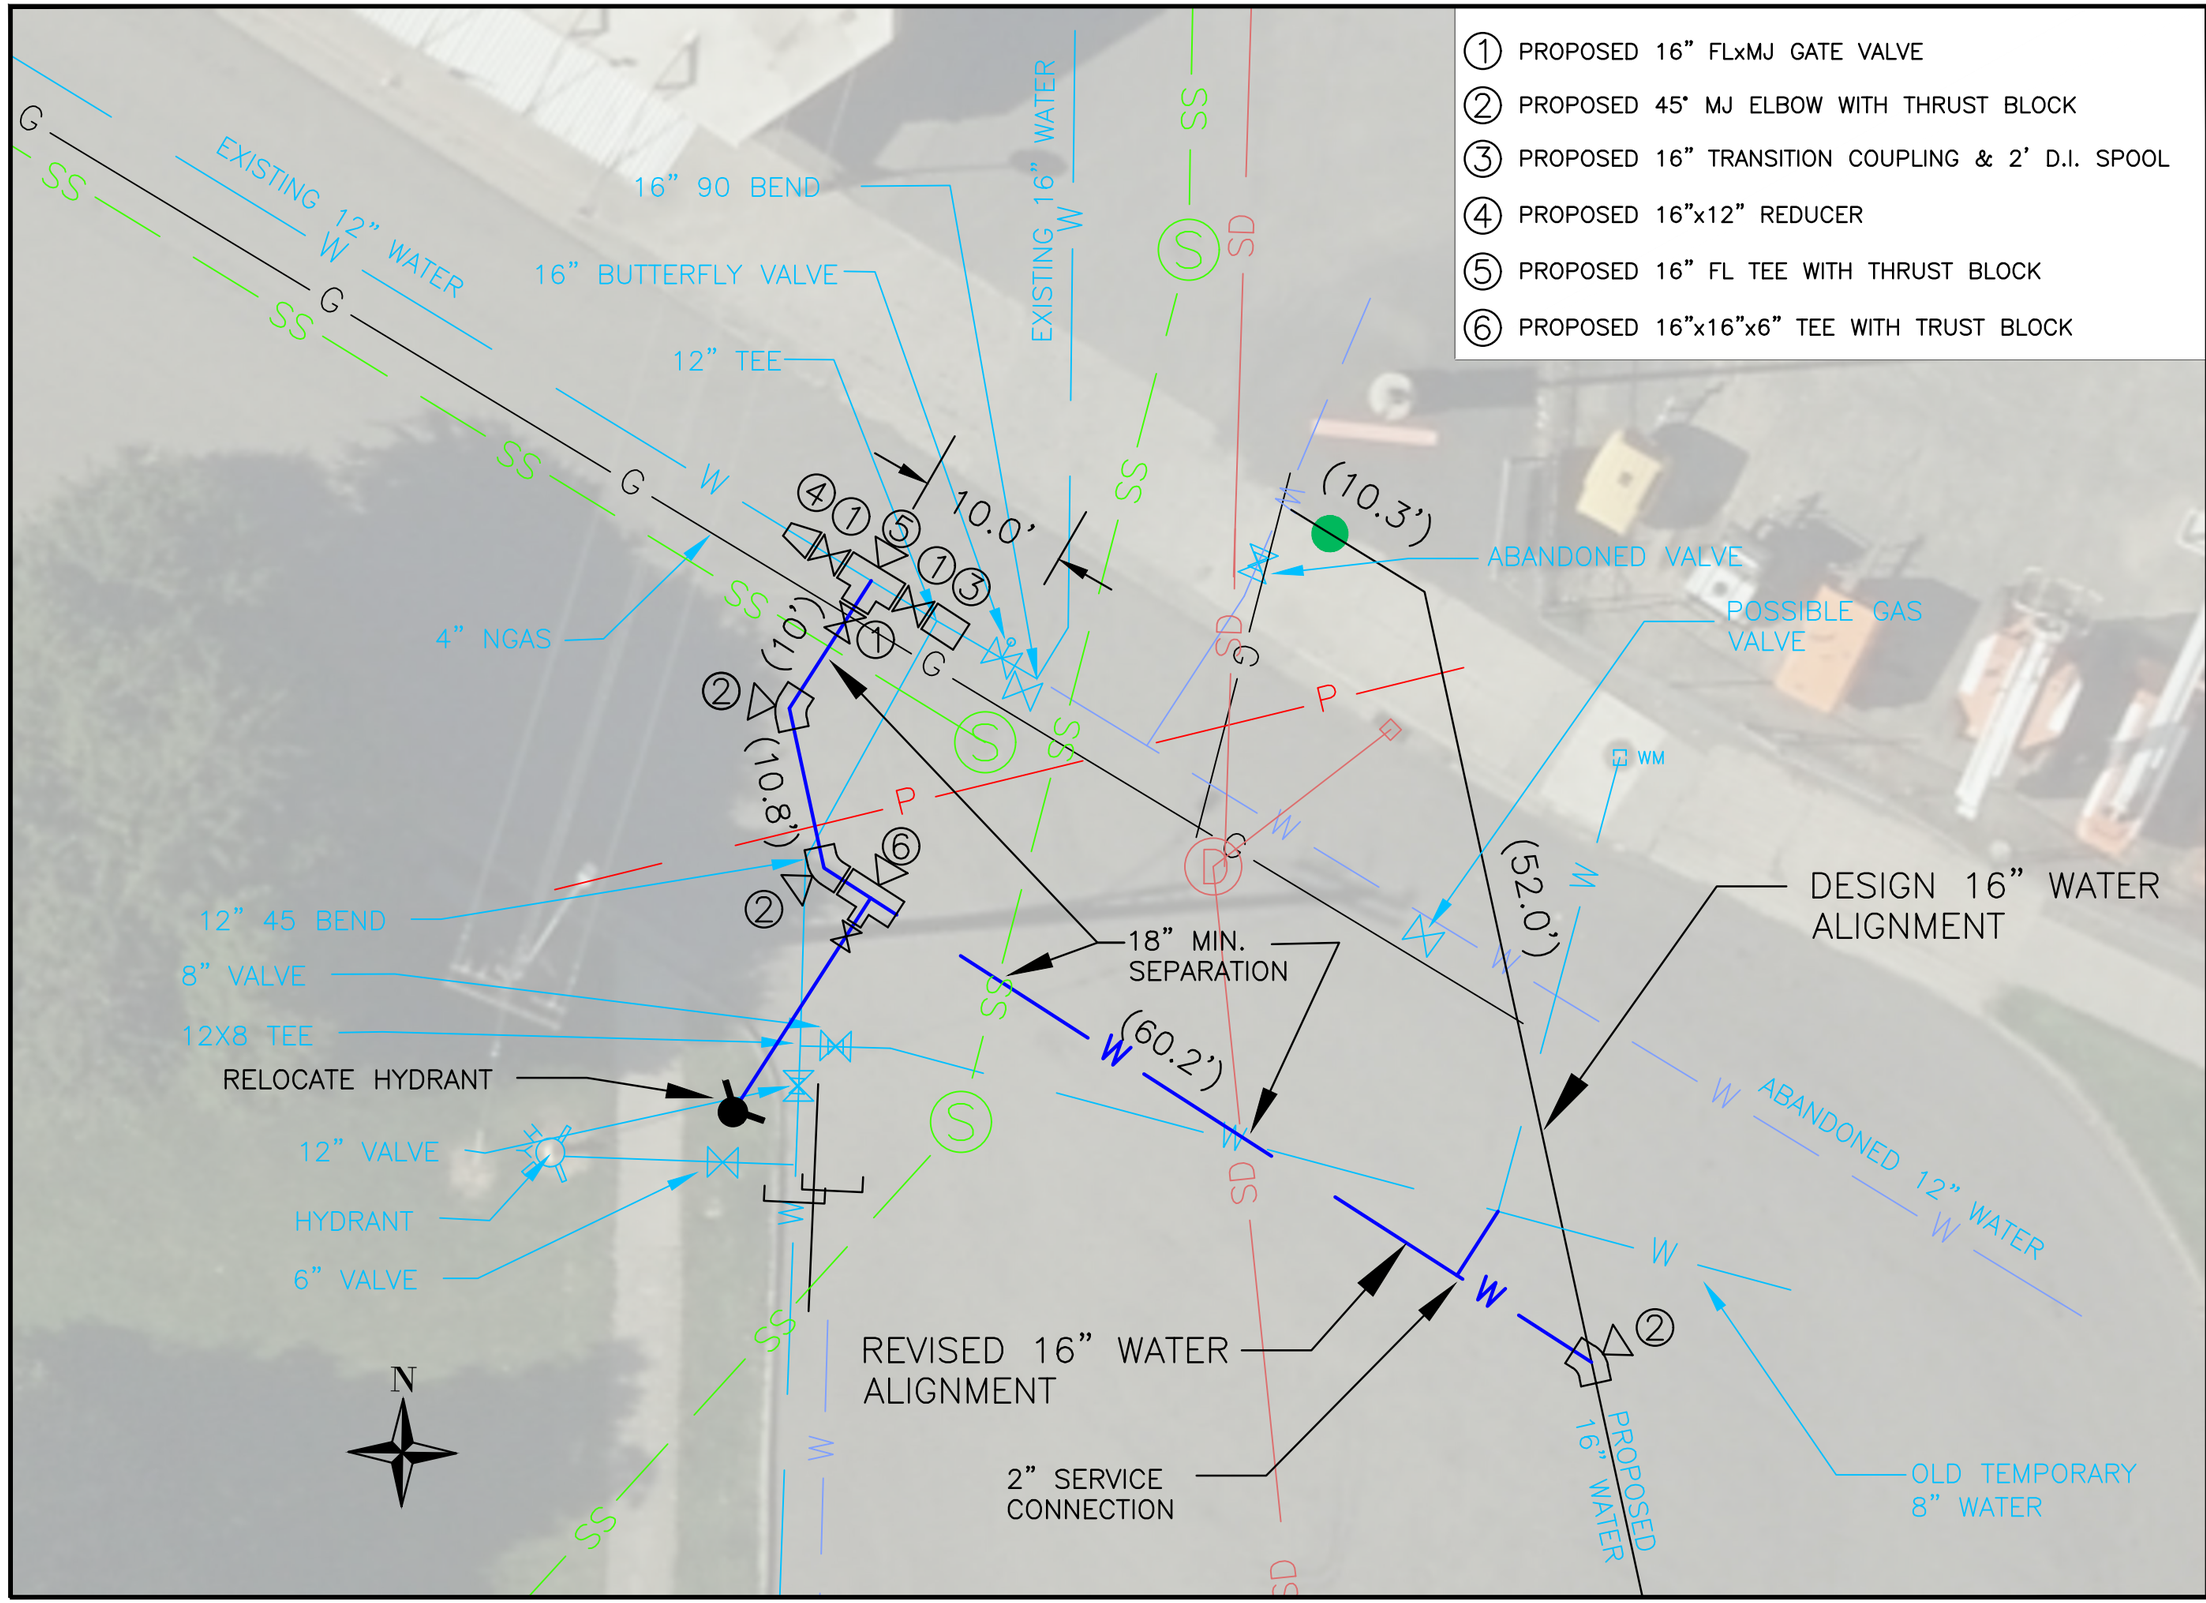

1. PROPOSED 16" FLxMJ GATE VALVE
2. PROPOSED 45° MJ ELBOW WITH THRUST BLOCK
3. PROPOSED 16" TRANSITION COUPLING & 2' D.I. SPOOL
4. PROPOSED 16"x12" REDUCER
5. PROPOSED 16" FL TEE WITH THRUST BLOCK
6. PROPOSED 16"x16"x6" TEE WITH TRUST BLOCK

CITY OF LEWISTON
PUBLIC WORKS DEPARTMENT
1861
215 "D" Street, Lewiston, ID 83501-1930
Phone: 208-746-1316 Fax: 208-746-5595

REVISIONS			
NO.	DATE	DESCRIPTION	BY

US 12 - 21STREET INTERSECTION
WATER CONNECTION DETAIL
REVISION FOR SHEET 53 OF 146

REVISED 16" WATERLINE TIE-IN

SCALE:	1" = 10'
DESIGNED BY:	AMB
DRAWN BY:	BDS
CHECKED BY:	
SHEET SET:	NONE
DATE:	3-18-2019
DRAWING NO.:	
SHEET	1 OF 1