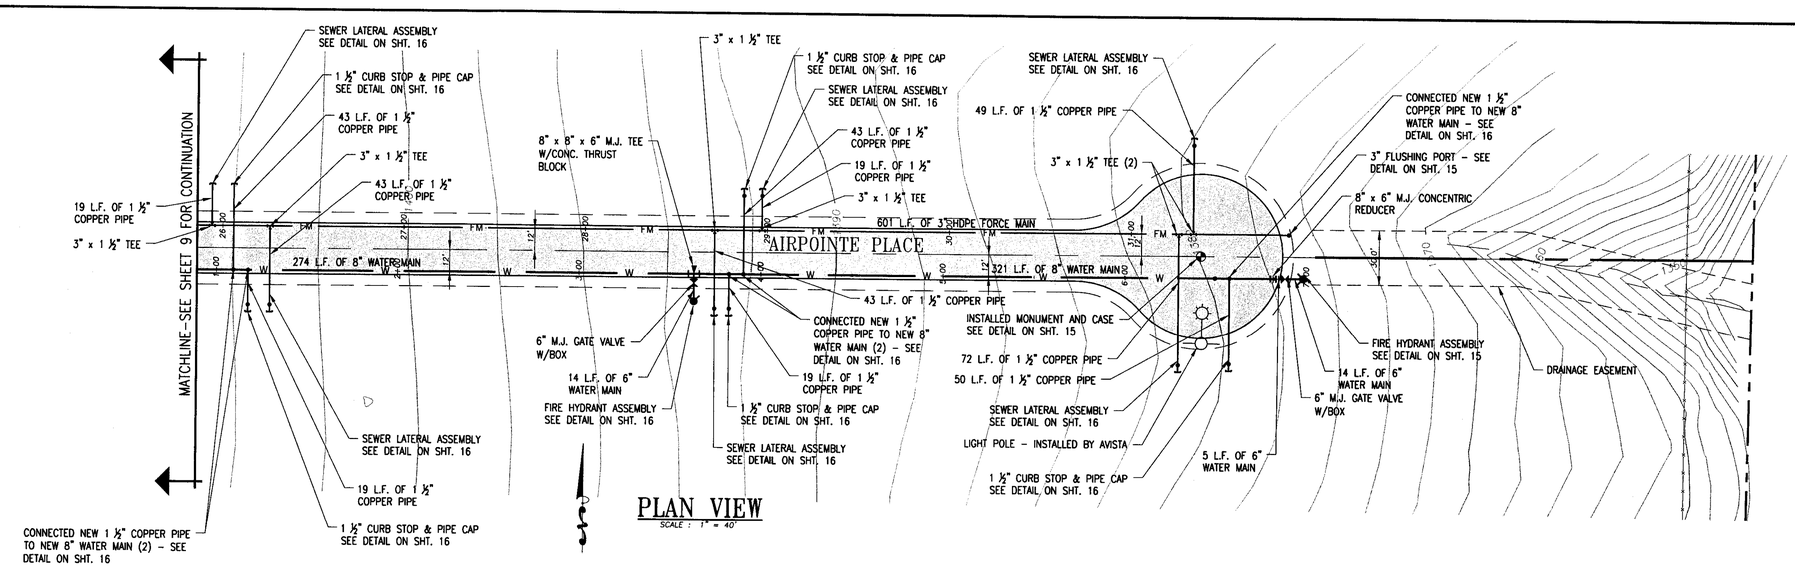

PLAN VIEW
SCALE : 1" = 40'

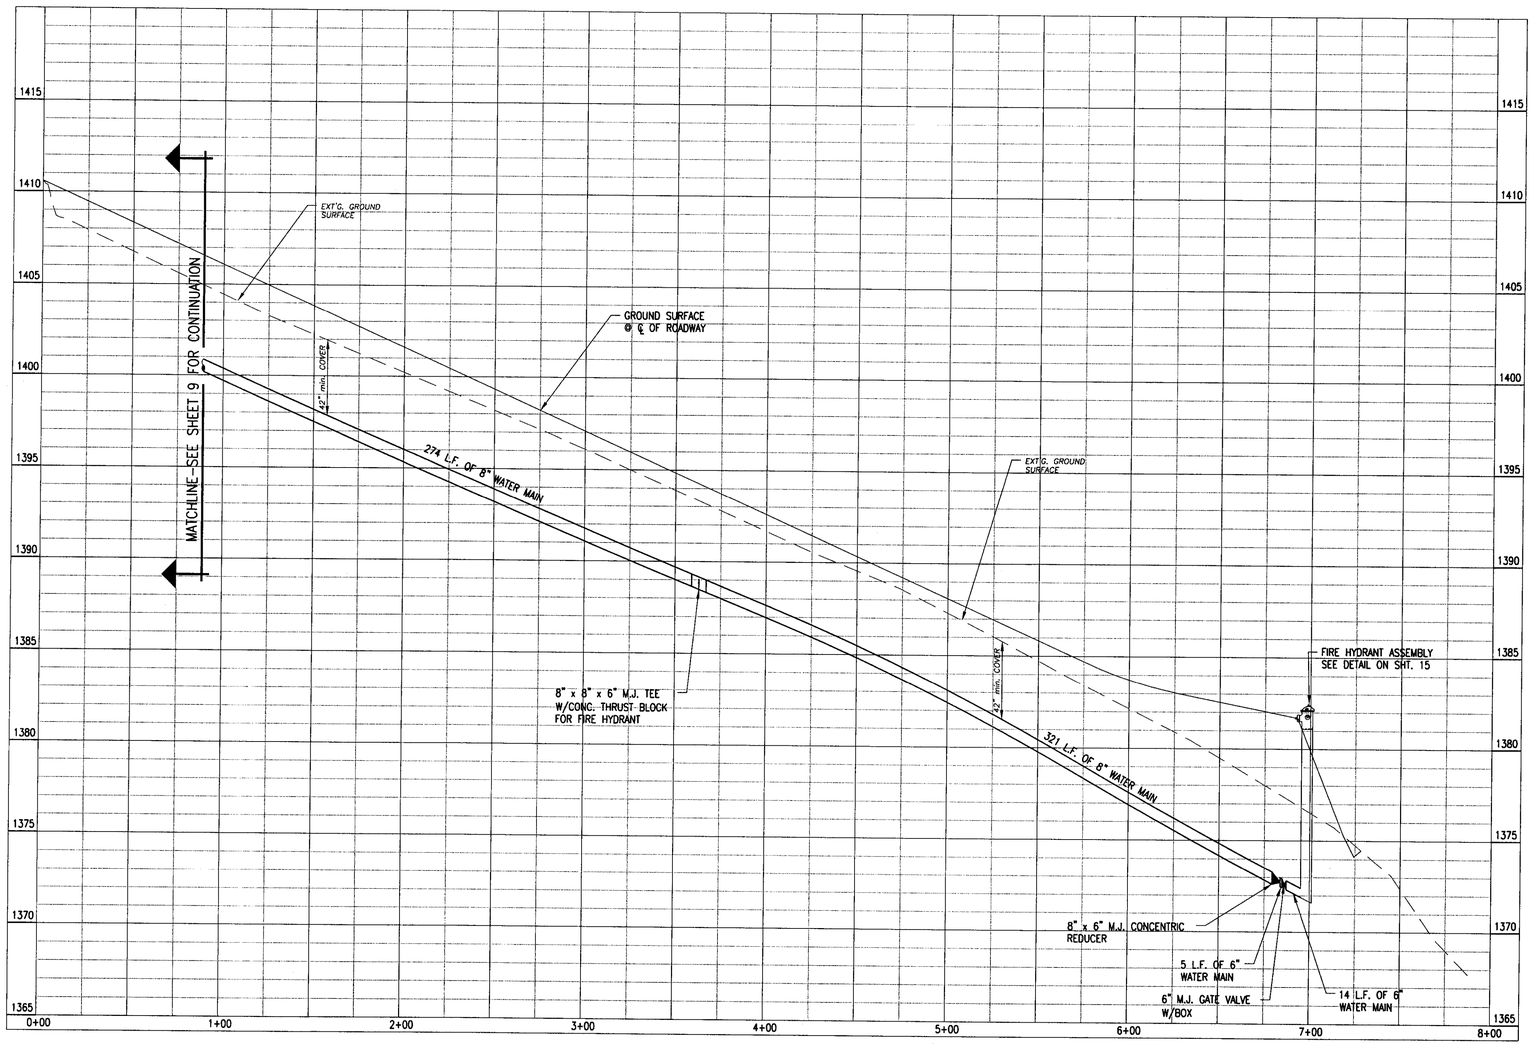

PROFILE VIEW
SCALE: HORZ. 1" = 40'
VERT. 1" = 4'

RECORD DRAWING 06/21/12

No.	DATE	BY	REVISIONS
1			
2			
3			

PROFESSIONAL ENGINEER REGISTERED STATE OF IDAHO 6978 TERRY W. NAU July 23, 2012

PROGRESSIVE ENGINEERING GROUP, INC
PLANNING ◬ DESIGN + CONSTRUCTION MANAGEMENT
1208 IDAHO STREET
LEWISTON, IDAHO 83501
PH (208) 746-5406 FAX (208) 746-9732

D 2 J, INC.
SOUTHPORT WATER MAIN EXTENSION
AIRPOINTE BUSINESS PARK
STA. 0+89 TO STA. 13+64
LEWISTON, IDAHO 83501

DRAWN BY: WRE	CHECKED BY: TWN
DESIGNED BY: TWN	
DATE: 06/21/12	
LAST REV:	
PROJECT NO.: 08-005	
SHEET 10 OF 17	