
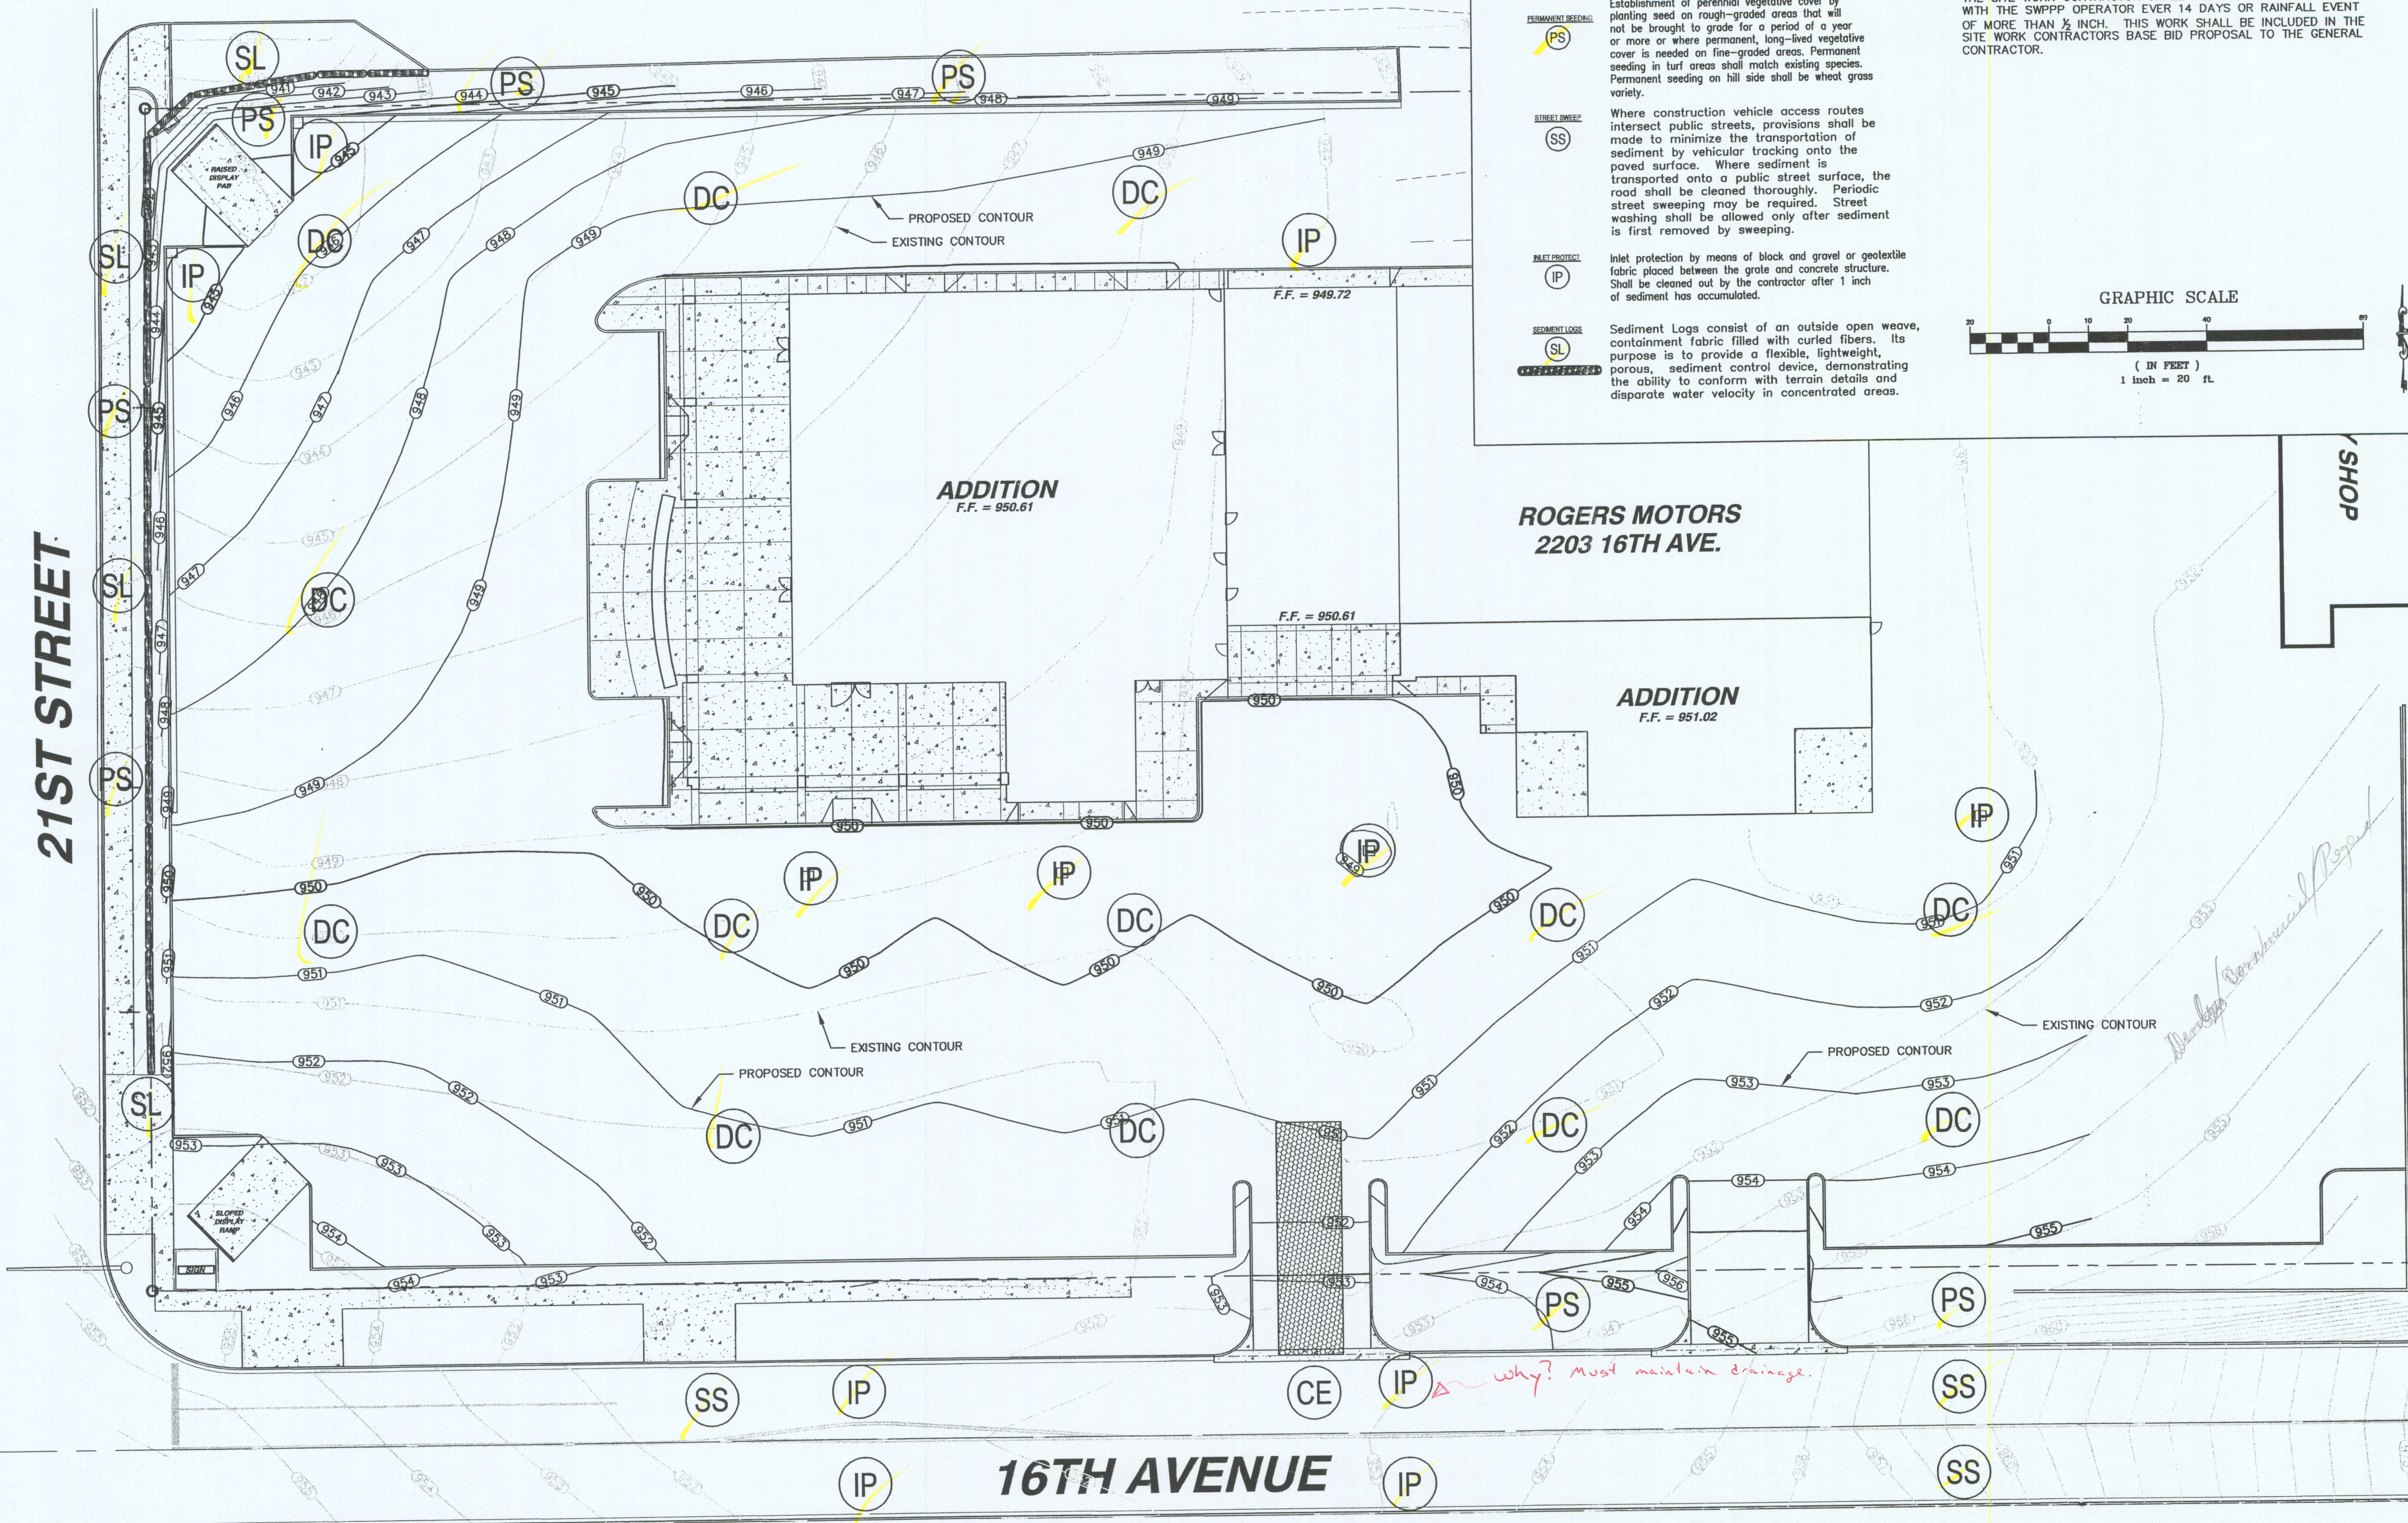


**21ST STREET.**

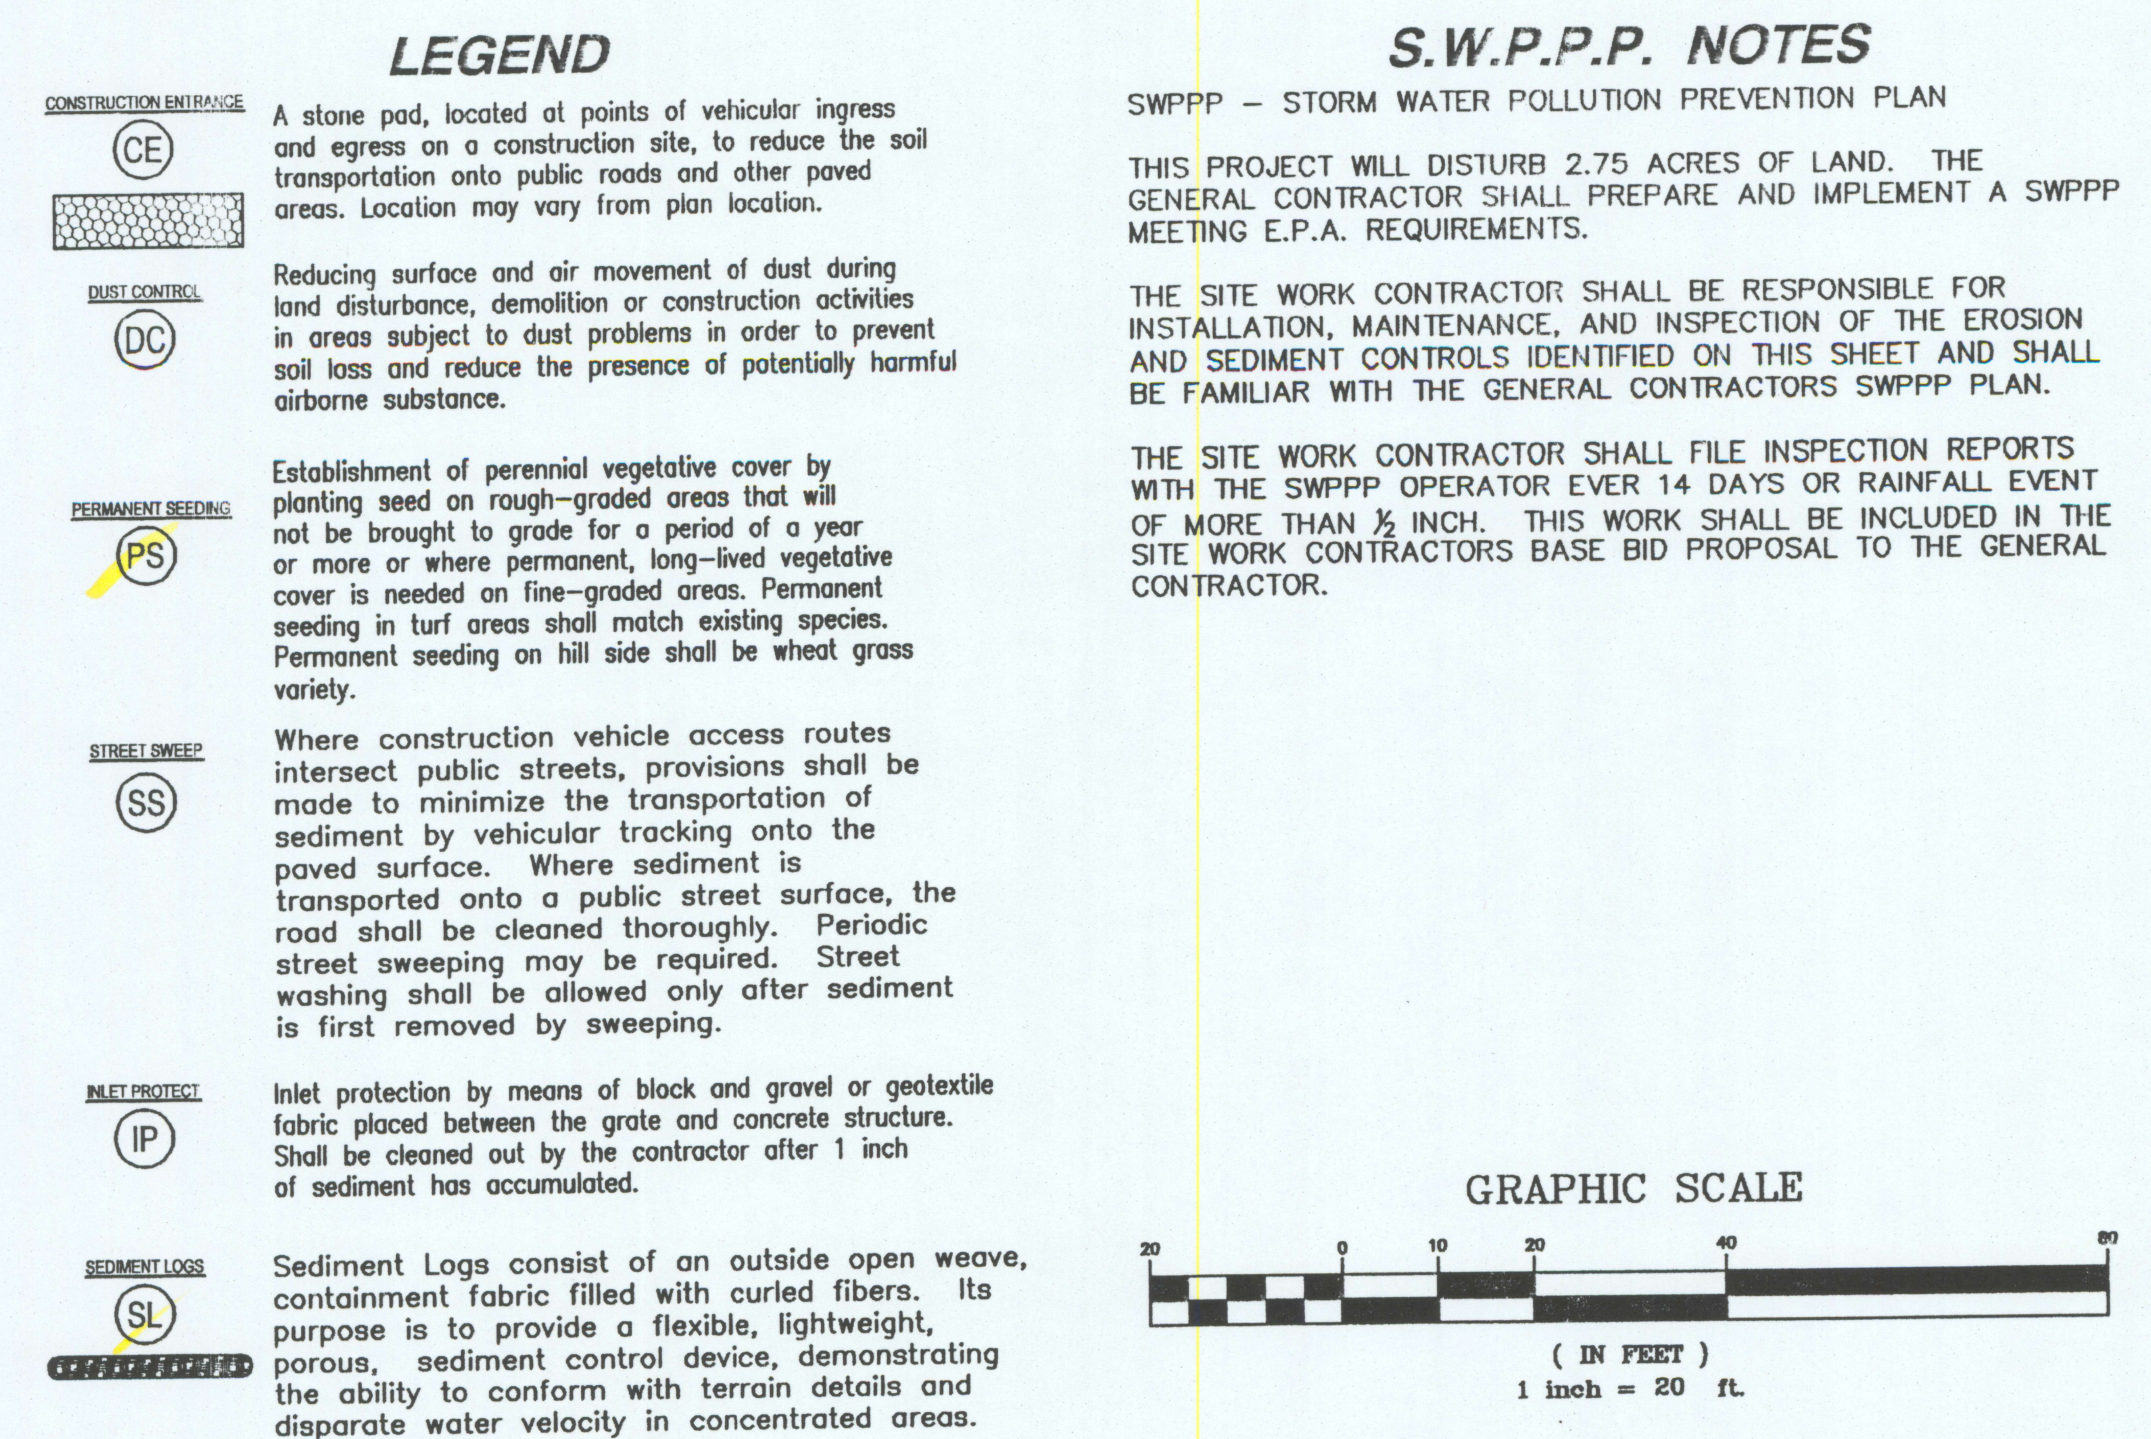

<p><b>ROGER MOTORS</b></p> <p><b>LEWISTON, IDAHO</b></p>		<p><b>EROSION &amp; SEDIMENT</b></p> <p><b>CONTROL PLAN</b></p>	
<p>DRAWN BY: CRF</p> <p>DESIGNED BY: CRF</p> <p>SCALE: 1" = 20'</p> <p>DATE: 10/22/07</p> <p>PROJECT NO.: 00077</p>		<p>CHECKED BY: CRF</p>	
<p><b>SHEET C2 OF 10</b></p>			