


GRAPHIC SCALE

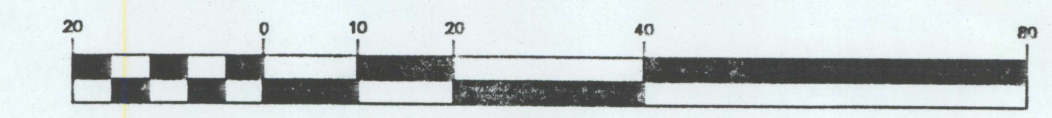


(IN FEET)
1 inch = 20 ft.

21ST STREET


16TH AVENUE

ROGERS MOTORS
2203 16TH AVE.

AUTO BODY SHOP

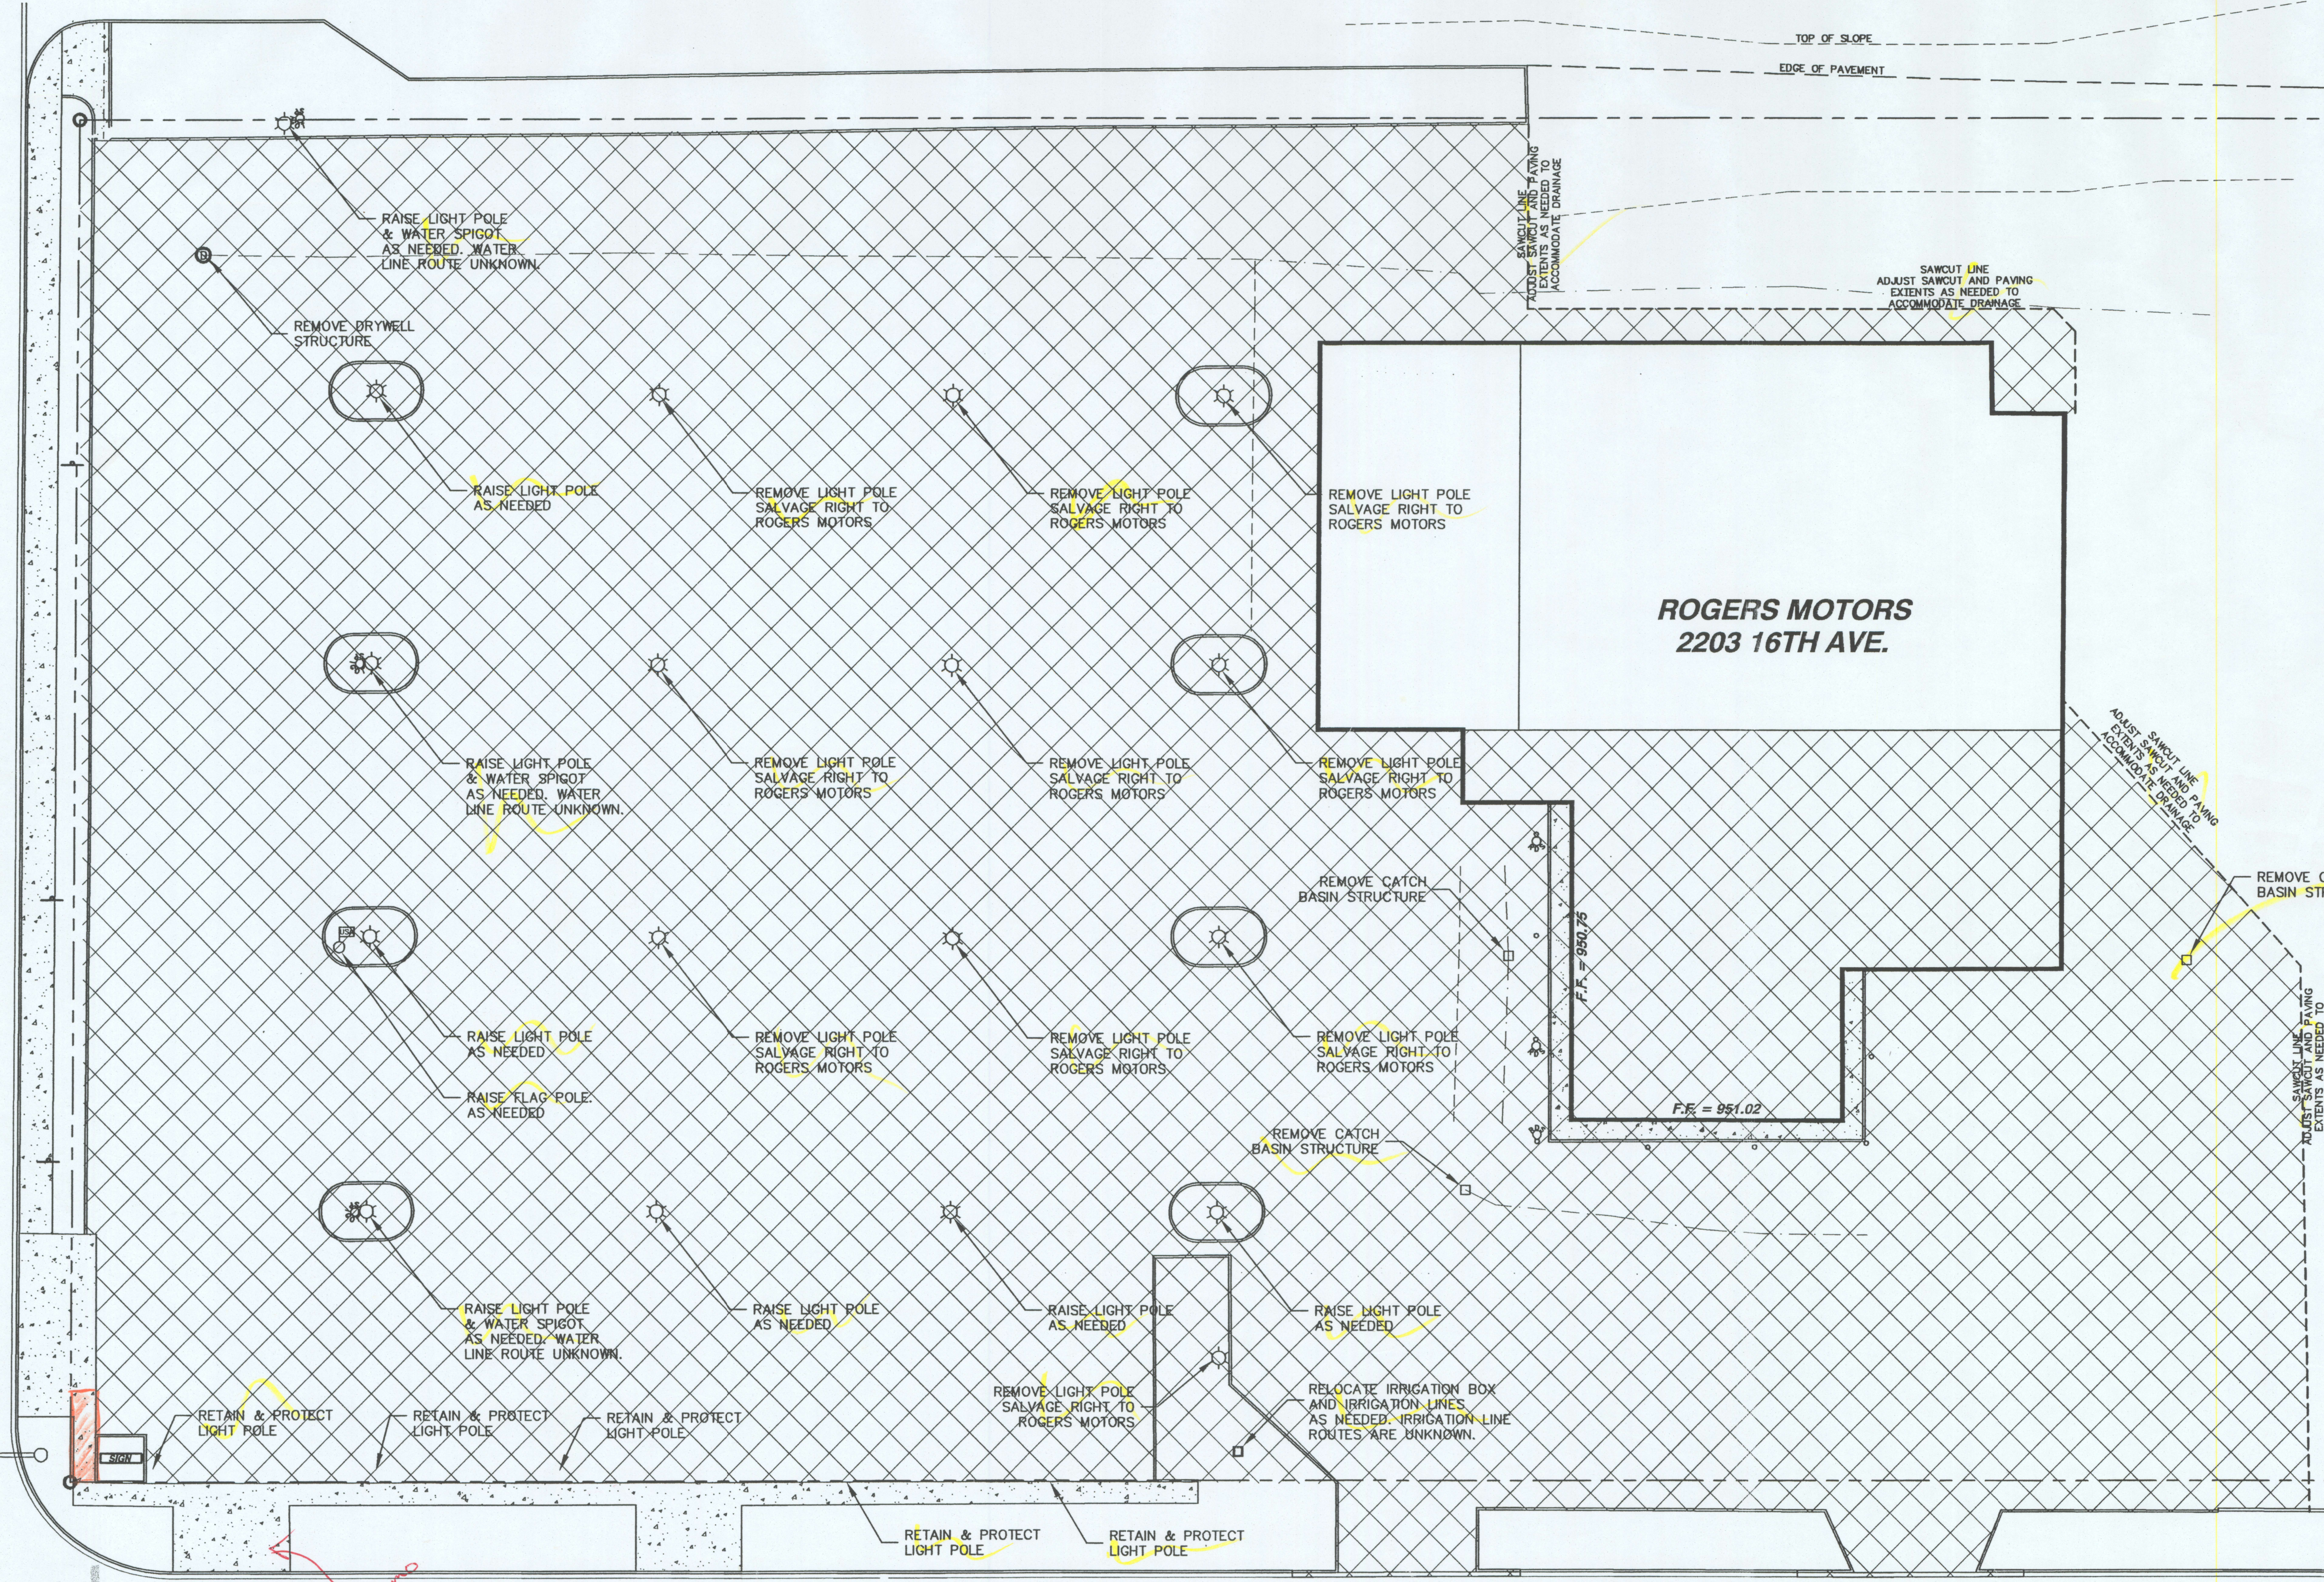

NO.	DATE	BY	FILENAME	REVISIONS
0				

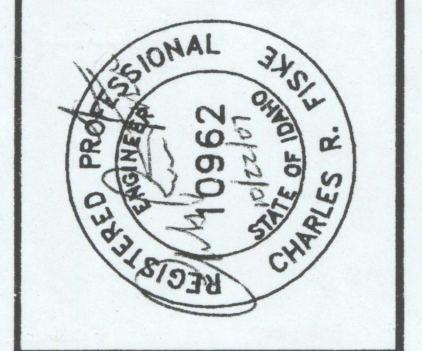

4025 EAGLE COURT
LEWISTON, IDAHO 83501
FAX (208) 756-1082
(208) 741-0825

MAGLINE
ENGINEERING & DRAFTING
"an affordable alternative"

ROGER MOTORS
LEWISTON, IDAHO
DEMOLITION PLAN

DRAWN BY: CRF	CHECKED BY: CRF
DESIGNED BY: CRF	
SCALE: 1" = 20'	
DATE: 10/22/07	
PROJECT NO.: 00077	
SHEET C3 OF 10	

ORIGINAL DRAWING

00077