S17-000022 Sign Permit – Updated Site Plan changes to pylon placement; see layout below

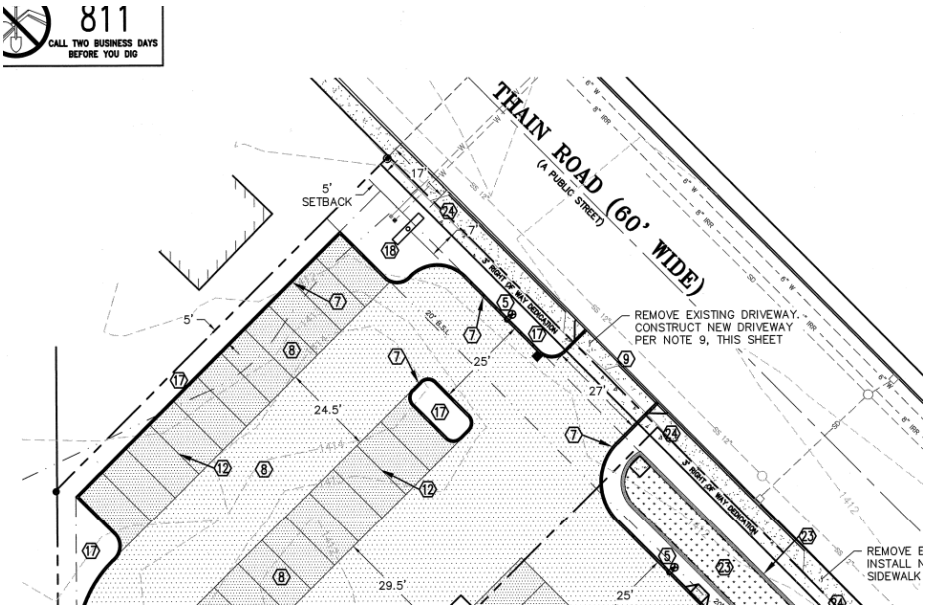

From B17-000140 Resub #1 – **Sheet C1.0**

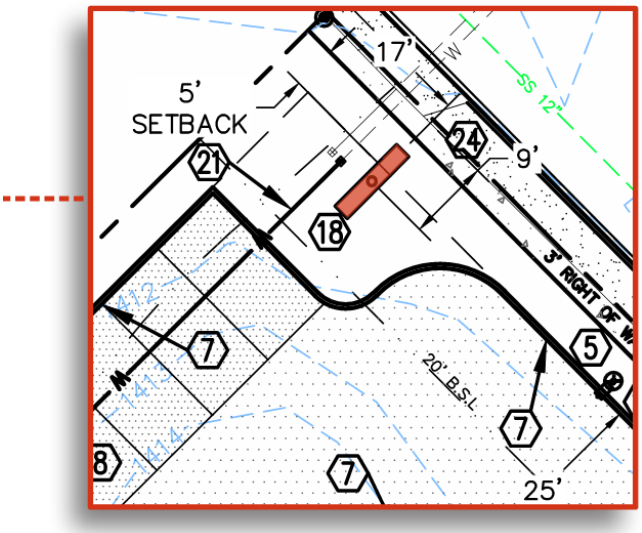

PYLON PLACEMENT DETAIL
SCALE: 1" = 20'-0"

Sheet 2 of 7 from S17-000022