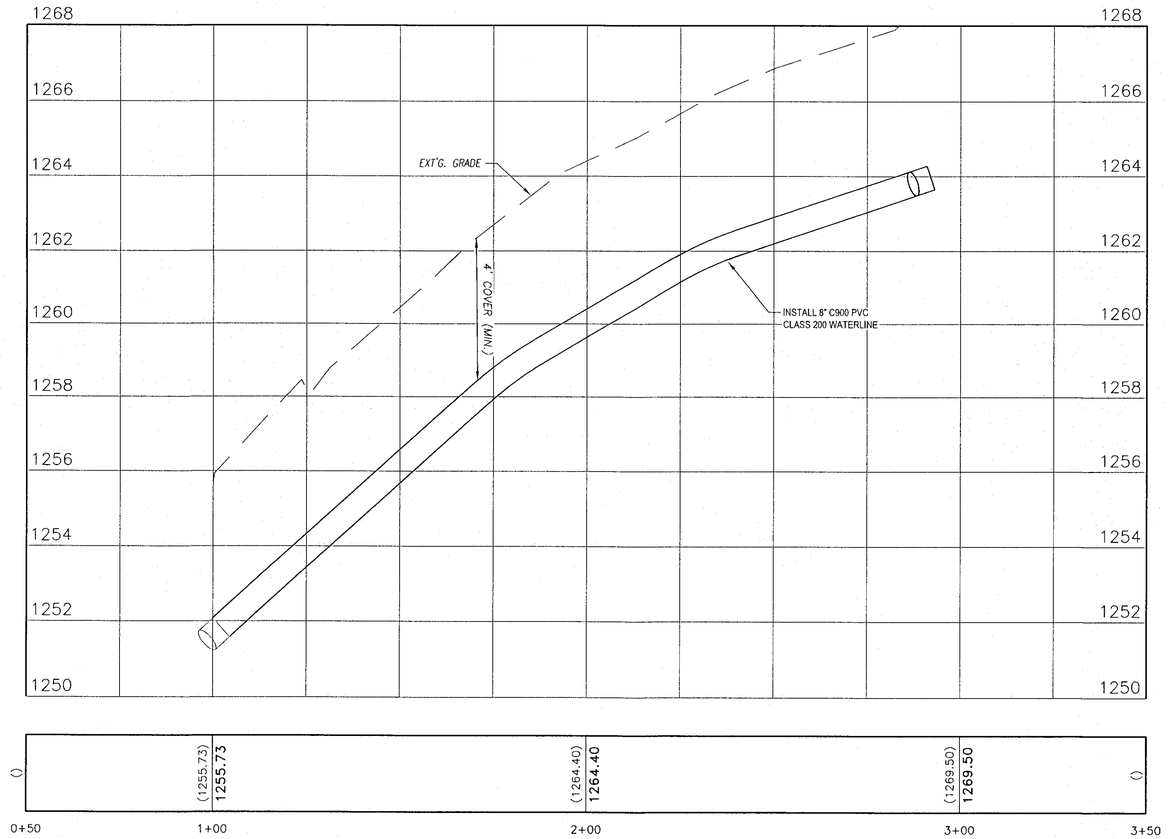

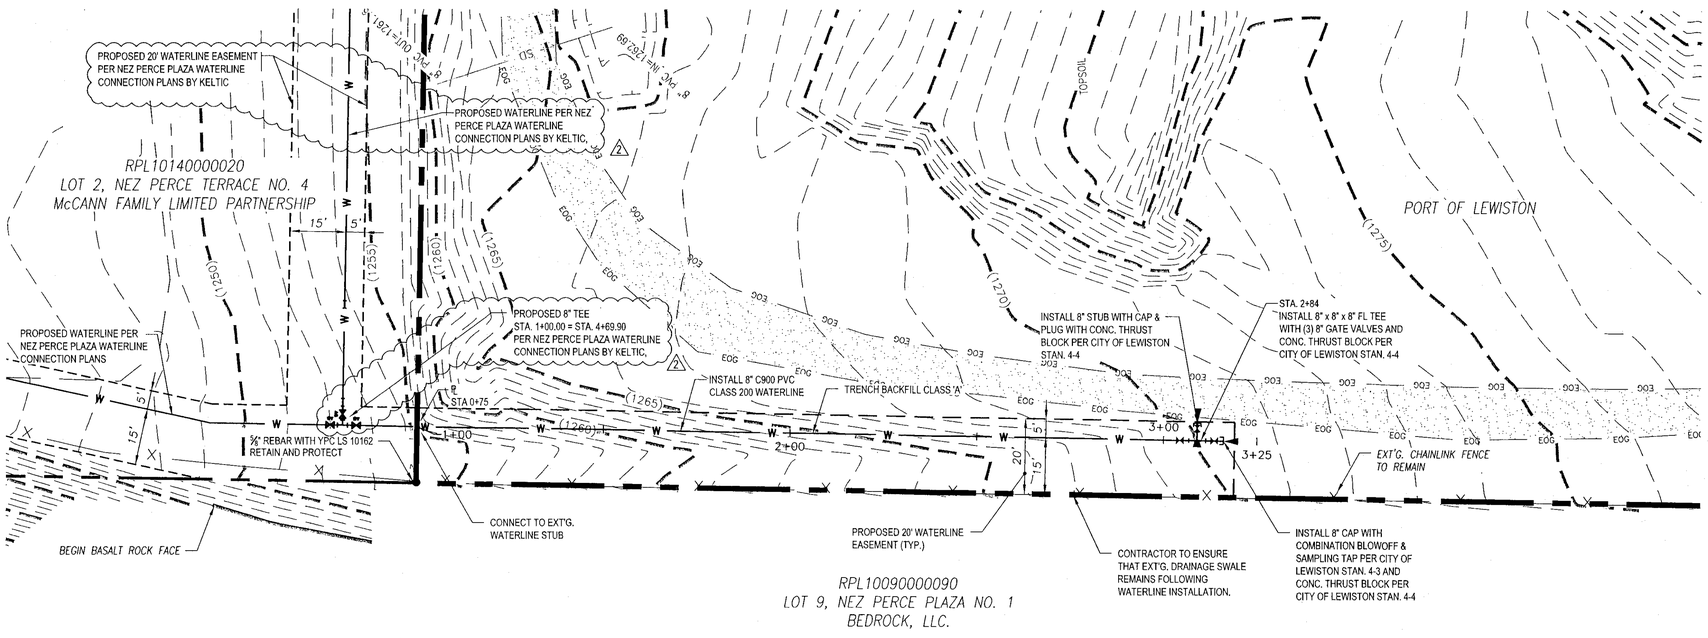

WATERLINE STA. 1+00 TO 2+90

20 0 20 40
Scale: 1" = 20'

811
Know what's **below.**
Call before you dig.

CALL 2 BUSINESS DAYS IN ADVANCE BEFORE YOU DIG, GRADE, OR EXCAVATE FOR THE MARKING OF UNDERGROUND MEMBER UTILITIES

No.	DATE	BY	DESCRIPTION
1	2/12/14	JDM	CITY OF LEWISTON REVIEW COMMENTS - 02-05-14
2	12/19/14	JDM	OWNER CHANGE

WATERLINE PLAN & PROFILE

PORT OF LEWISTON
1626 6TH AVE. NORTH
LEWISTON, ID. 83501

KELTIC ENGINEERING, INC.
315 Adams Lane ◊ Lewiston, Idaho 83501 ◊ (208) 743-2135 ◊ (208) 743-2136 fax
9425 North Nevada Street, Ste 204 ◊ Spokane, WA 99218 ◊ (509) 464-3000 ◊ (509) 464-3005 fax
Development ✦ Planning ✦ Design ✦ Construction Management

PROFESSIONAL ENGINEER REGISTERED 6064 STATE OF IDAHO ERIC HASENOEHRL 12/19/14

DRAWN BY: RGW	CHECKED BY: EFH
DESIGNED BY: EFH	
DATE: 12-14-14	
LAST REV.: 12-19-14 (WHII)	
PROJECT NO. 13-1301	
SHEET NO. 5 OF 5	