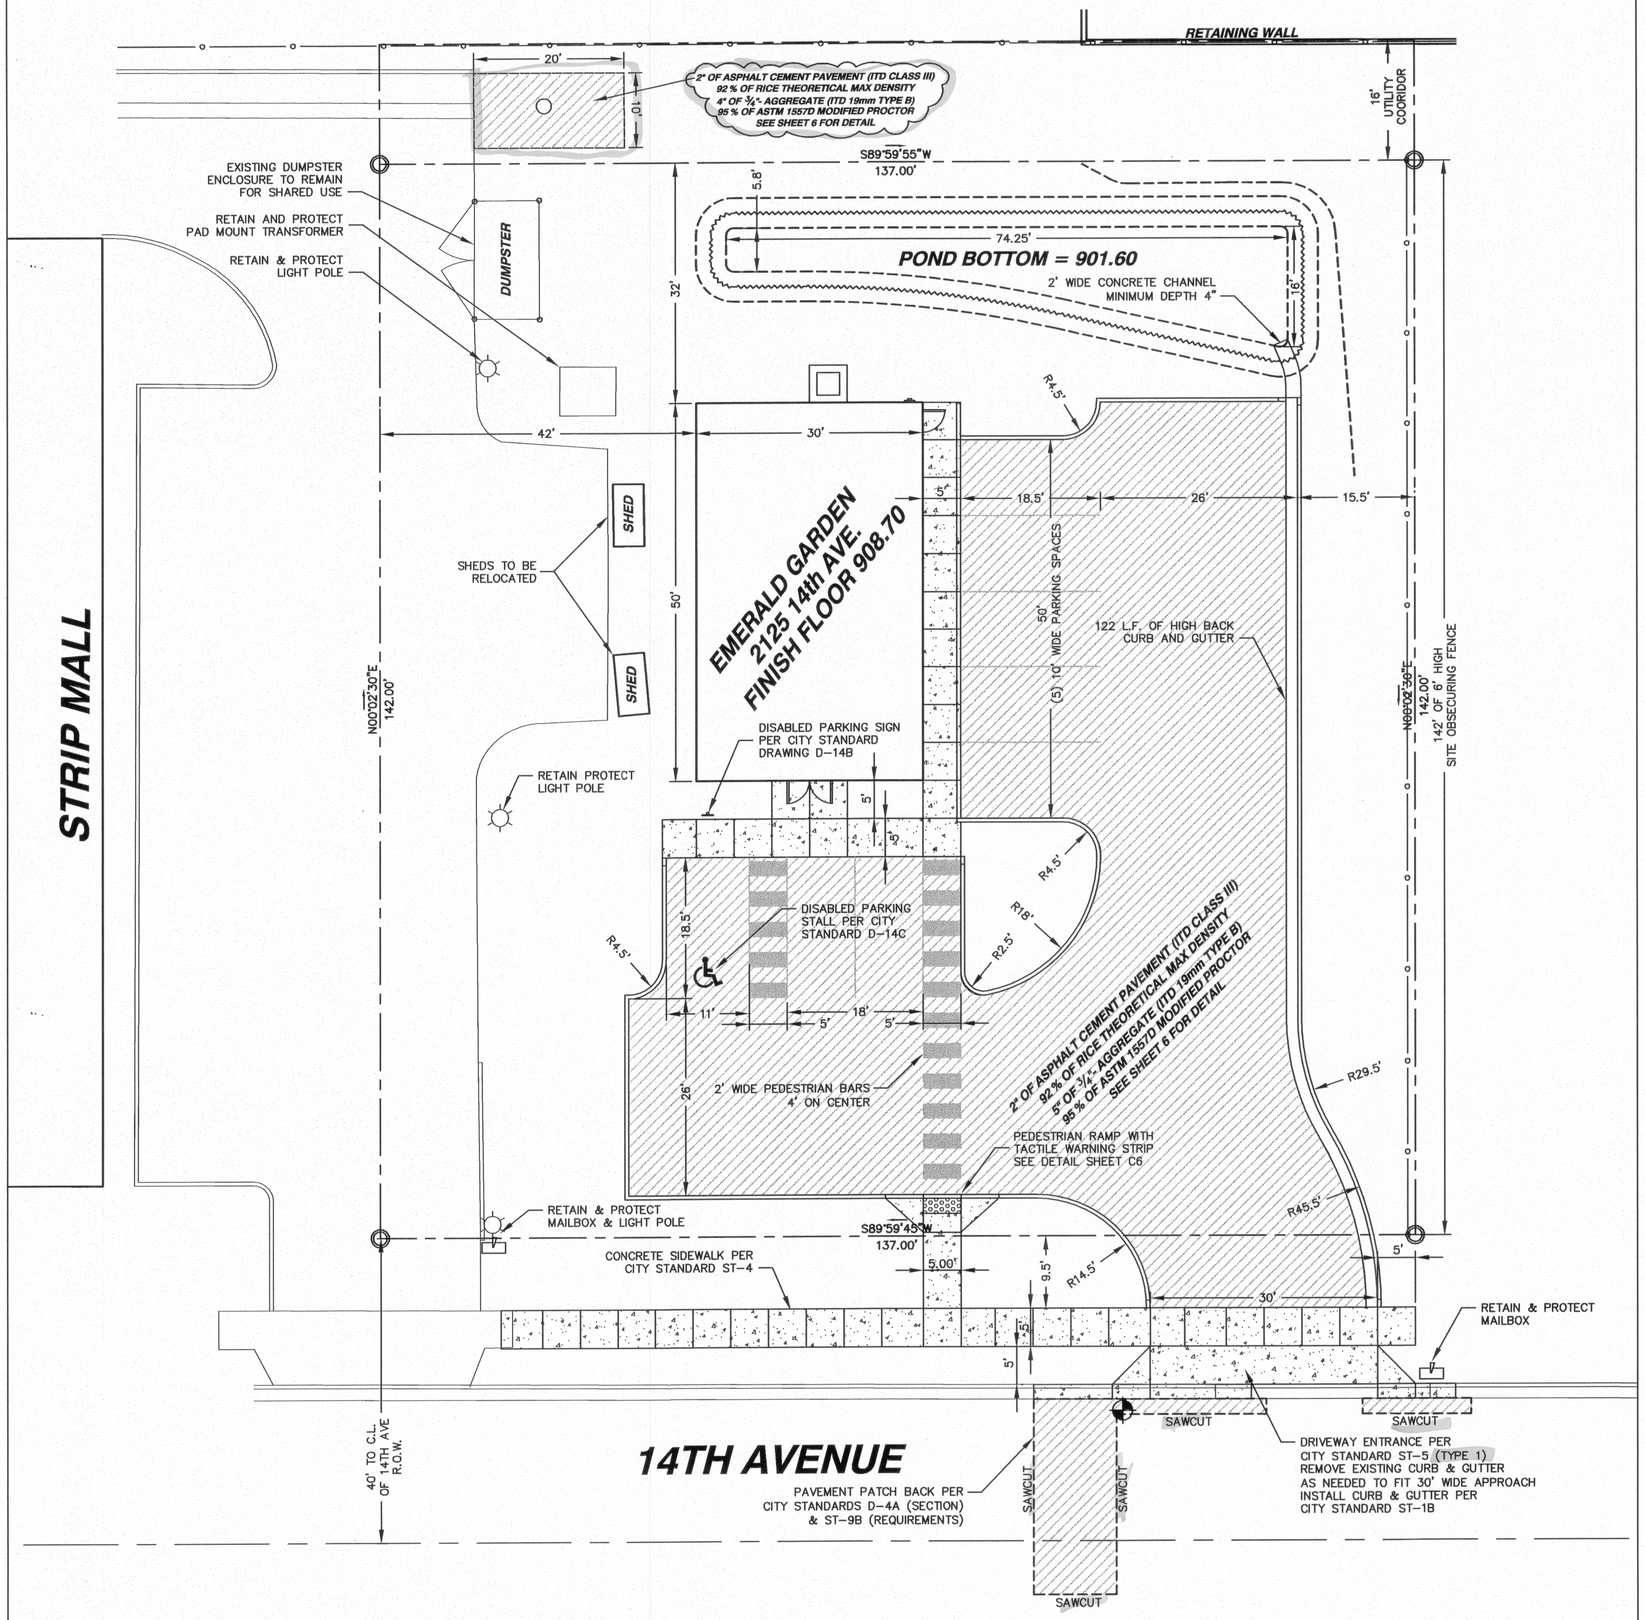

GRAPHIC SCALE

10 0 5 10 20 40

(IN FEET)
1 inch = 10 ft.

NO.	DATE	BY	FILENAME	REVISIONS
1	4/8/08	CRF		ADDED SAWCUT NOTES AND PAVEMENT AROUND MANHOLE
0			00132	ORIGINAL DRAWING

REGISTERED PROFESSIONAL ENGINEER
10962
STATE OF IDAHO
CHARLES R. FISKE

4025 EAGLE COURT
LEWISTON, IDAHO 83501
FAX (208) 750-1082
(208) 791-8035

NACLINE
ENGINEERING & DRAFTING
"an affordable alternative"

EMERALD GARDEN
LEWISTON, IDAHO
CIVIL PLAN

DRAWN BY: CRF	CHECKED BY: CRF
DESIGNED BY: CRF	
SCALE: 1" = 10'	
DATE: 3/3/08	
PROJECT NO.: 00132	
SHEET 5 OF 8	