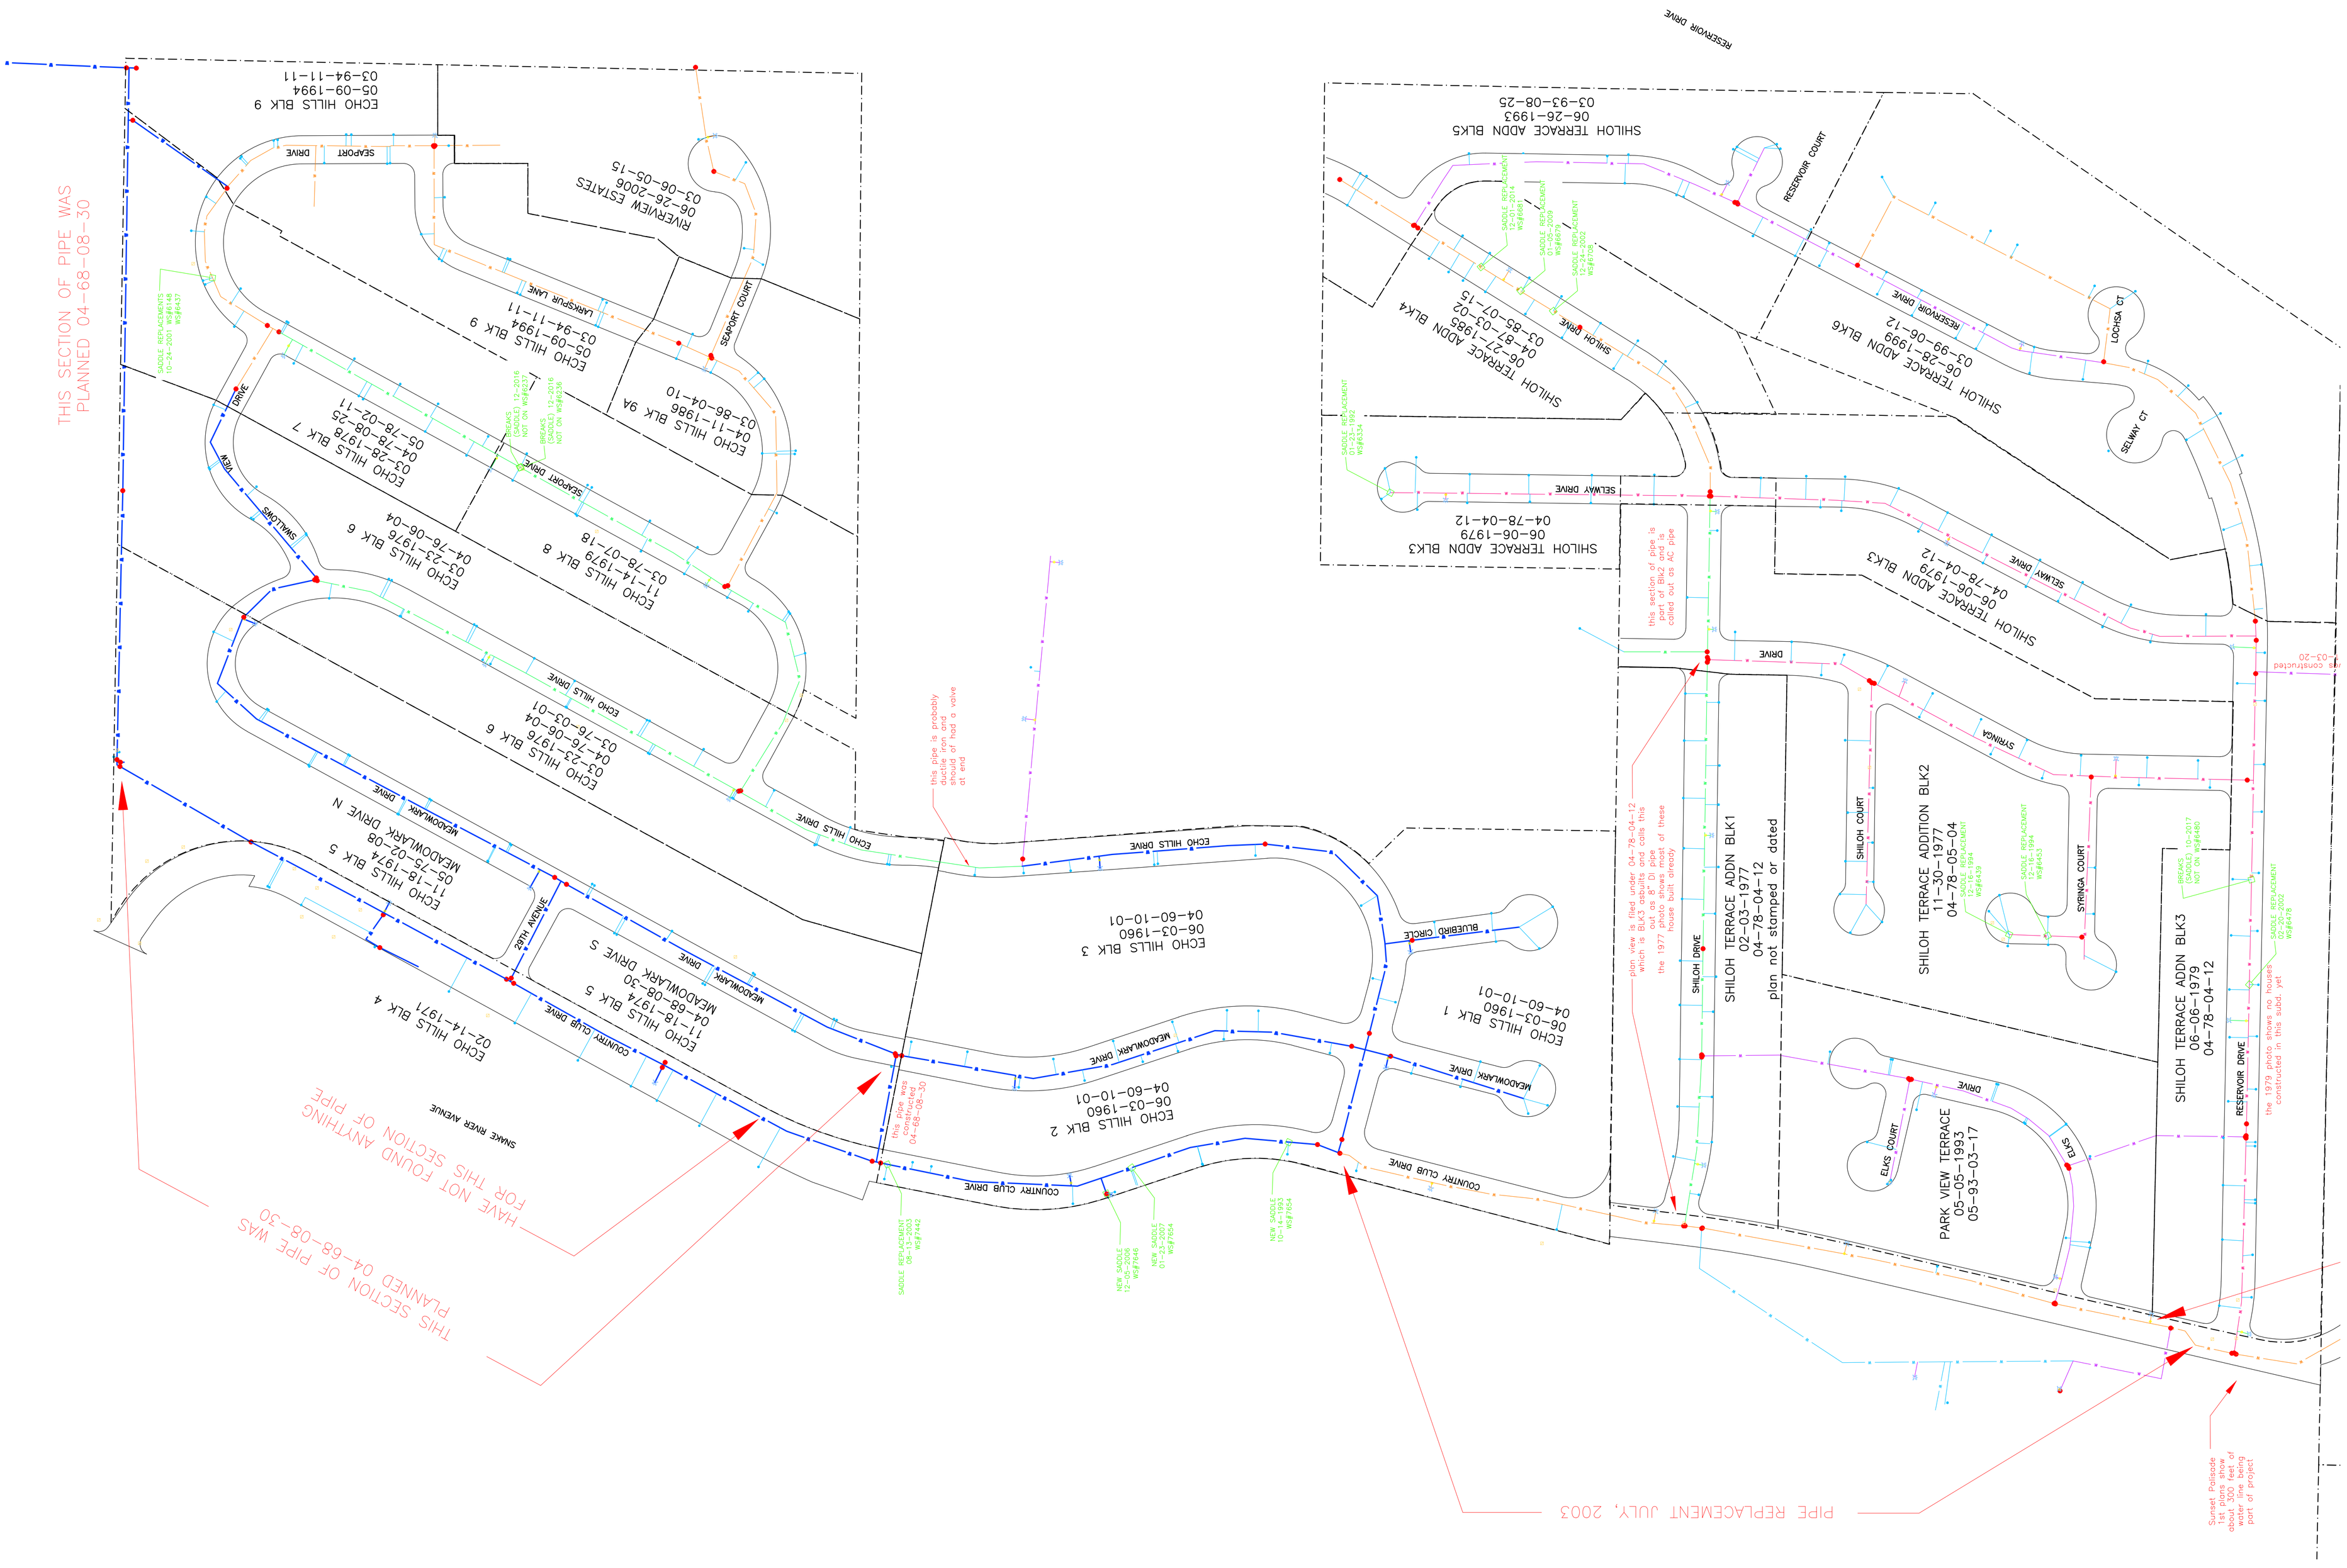
RESERVOIR DRIVE
SHILOH TERRACE ADDN BLK5
06-26-1993
03-93-08-25
RESERVOIR COURT
SADDLE REPLACEMENT
12-01-2014
WS#6685
SADDLE REPLACEMENT
01-02-2009
WS#6673
SADDLE REPLACEMENT
12-12-2002
WS#6705
SHILOH DRIVE
SHILOH TERRACE ADDN BLK4
06-21-1985
04-87-03-02
03-85-07-15
SADDLE REPLACEMENT
01-23-1992
WS#6334
SHILOH TERRACE ADDN BLK6
06-28-1999
03-99-06-12
RESERVOIR DRIVE
LOCHSA CT
SELWAY CT
SELWAY DRIVE
SHILOH TERRACE ADDN BLK3
06-06-1979
04-78-04-12
this section of pipe is marked out in BLK3 and is called out as AC pipe
SHILOH TERRACE ADDN BLK3
06-06-1979
04-78-04-12
DRIVE
SYRINGA
SHILOH COURT
SHILOH TERRACE ADDITION BLK2
11-30-1977
04-78-05-04
SADDLE REPLACEMENT
12-16-1994
WS#6433
SADDLE REPLACEMENT
12-16-1994
WS#6453
SYRINGA COURT
BREAKS
(SADDLE) 12-20-2017
NOT ON WS#6480
SADDLE REPLACEMENT
12-12-2002
WS#6478
the 1979 photo shows no houses constructed in this subd. yet
RESERVOIR DRIVE
plan view is filed under 04-78-04-12 which is BLK3 asbuilts and calls this out as 8" DI pipe
the 1977 photo shows none of these house built already
SHILOH DRIVE
SHILOH TERRACE ADDN BLK1
02-03-1977
04-78-04-12
plan not stamped or dated
PARK VIEW TERRACE
05-05-1993
05-93-03-17
ELKS COURT
EYE
this pipe is probably ductile iron and should of had a valve at end
ECHO HILLS BLK 2
06-03-1960
04-60-10-01
ECHO HILLS BLK 3
06-03-1960
04-60-10-01
ECHO HILLS BLK 1
06-03-1960
04-60-10-01
BLUEBIRD CIRCLE
MEADOWLARK DRIVE
COUNTRY CLUB DRIVE
this pipe was constructed 04-68-08-30
SADDLE REPLACEMENT
08-15-2001
WS#7442
NEW SADDLE
12-05-2006
WS#7646
NEW SADDLE
01-25-2007
WS#7664
NEW SADDLE
10-14-1993
WS#7004
PIPE REPLACEMENT JULY, 2003
Sunset Palisade
1st plans show about 100 feet of water line being part of project
ECHO HILLS BLK 4
02-14-1971
SNAKE RIVER AVENUE
ECHO HILLS BLK 5
11-18-1974
05-75-02-08
MEADOWLARK DRIVE N
ECHO HILLS BLK 5
11-18-1974
04-68-08-30
MEADOWLARK DRIVE S
29TH AVENUE
ECHO HILLS BLK 6
03-23-1976
04-76-06-04
03-76-03-01
ECHO HILLS BLK 6
03-23-1976
04-76-06-04
ECHO HILLS BLK 7
03-28-1978
04-78-08-25
05-78-02-11
ECHO HILLS BLK 8
11-14-1979
03-78-07-18
ECHO HILLS BLK 9A
04-11-1986
03-86-04-10
ECHO HILLS BLK 9
05-09-1994
03-94-11-11
ECHO HILLS BLK 9
05-09-1994
03-94-11-11
RIVERVIEW ESTATES
06-26-2006
03-06-05-15
SEAPORT COURT
LARKSPUR LANE
SEAPORT DRIVE
BREAKS
(SADDLE) 12-2016
NOT ON WS#6573
BREAKS
(SADDLE) 12-2016
NOT ON WS#6526
SADDLE REPLACEMENTS
10-24-2001
WS#6433
DRIVE
VIEW
SWALLOWS
ECHO HILLS DRIVE
THIS SECTION OF PIPE WAS PLANNED 04-68-08-30
HAVE NOT FOUND ANYTHING FOR THIS SECTION OF PIPE
THIS SECTION OF PIPE WAS PLANNED 04-68-08-30