NOTE:
* STREET LIGHTING LAYOUT AND INSTALLATION WILL BE DONE BY AVISTA UTILITIES PER CITY REQUIREMENTS.

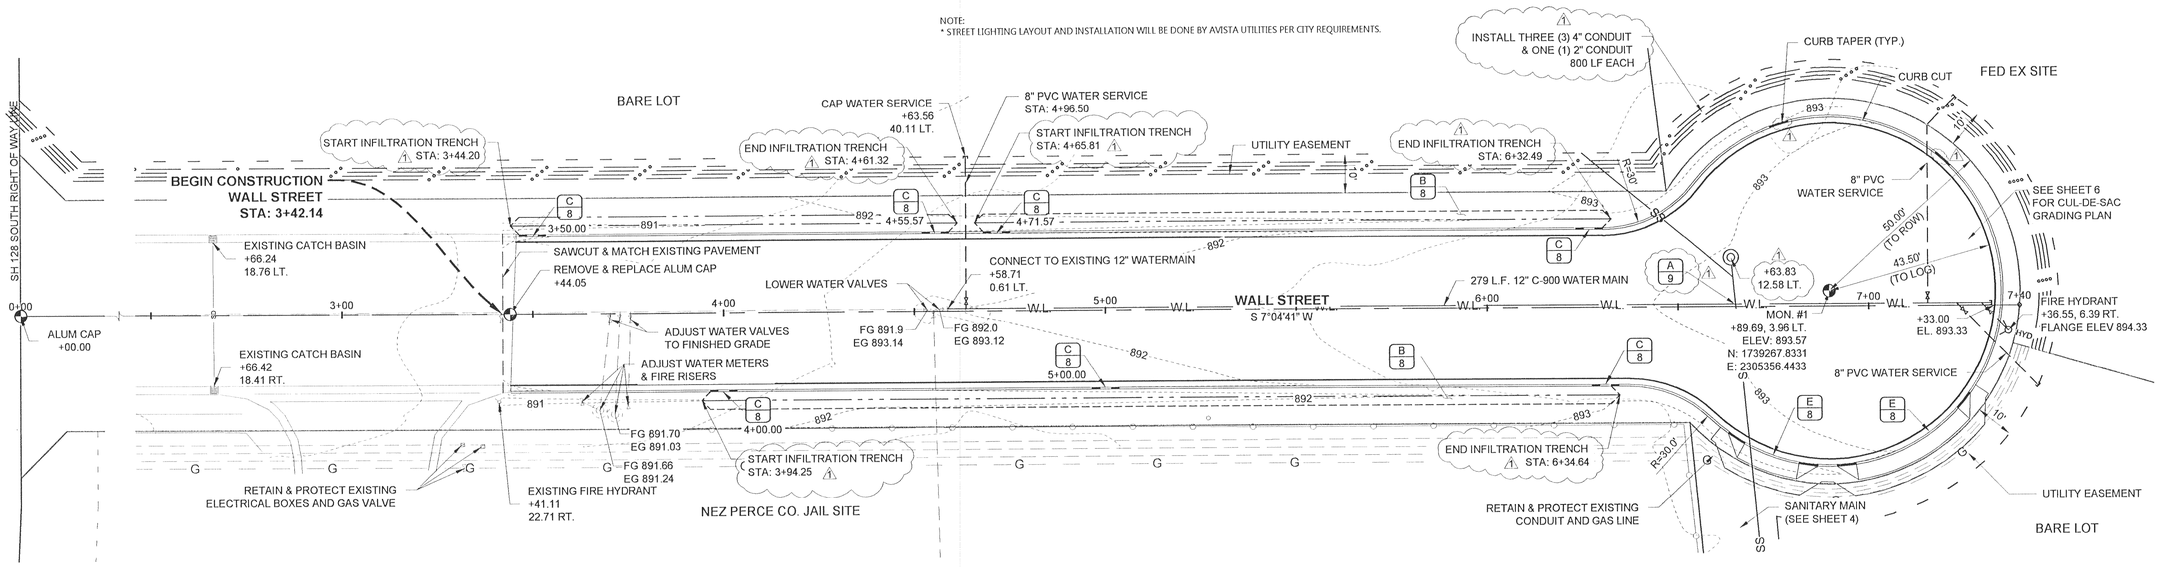

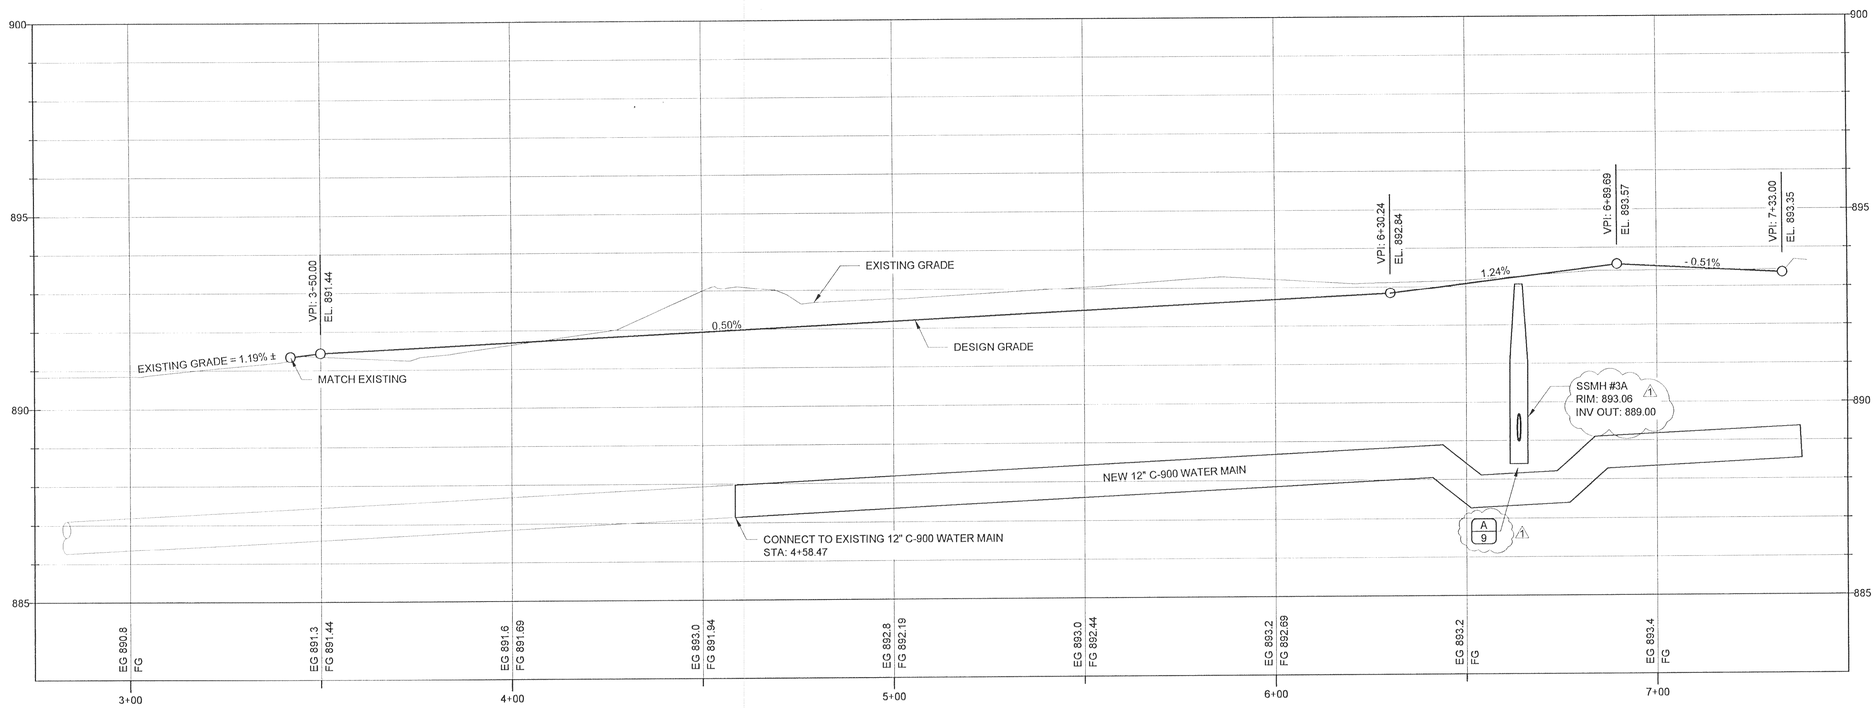

WALL STREET CENTERLINE PROFILE STA: 2+75 - 7+50

0 10 20 40
HORIZONTAL (FT)

77 Southway, Suite C
Lewiston, Id. 83501
Phone: (208) 743-3818
Fax: (208) 743-3819

RIEDESEL Engineering

THIS DOCUMENT, AND THE IDEAS AND DESIGNS INCORPORATED HEREIN, IS AN INSTRUMENT OF PROFESSIONAL SERVICES. THE PROPERTY OF RIEDESEL ENGINEERING, INC. AND SHALL NOT BE USED FOR ANY PURPOSE NOT SPECIFICALLY PERTAINING TO THIS PROJECT, OR THE EXTENSION OF THIS PROJECT WITHOUT THE WRITTEN AUTHORIZATION OF RIEDESEL ENGINEERING, INC.

REVISIONS

NO.	DATE	BY	DESCRIPTION
1	1-4-12	BJW	REVISED PER CITY COMMENTS
2	—	—	—
3	—	—	—
4	—	—	—
5	—	—	—
6	—	—	—

HARRY WALL INDUSTRIAL PARK
INFRASTRUCTURE EXTENSION PROJECT
2013

WALL ST PLAN_PROFILE

PROFESSIONAL ENGINEER
REGISTERED
13055
01/02/13
STATE OF IDAHO
JOHN P. MORTENSON

DESIGNED	BJW
DESIGN CHECKED	JRW / JPM
DETAILED	BJW
DRAWING CHECKED	JRW / JPM
FILE NAME	2060-PLAN.dwg
DRAWING DATE	1/4/13
DRAWING SCALE	AS SHOWN

SHEET 3 OF 10

PLOT DATE: 1/4/2013
E:\PROJECTS\2060-HARRY WALL INDUSTRIAL SITE EXPANSION\CADD\CIVIL 3D\DRAWINGS\2060-PLAN.DWG