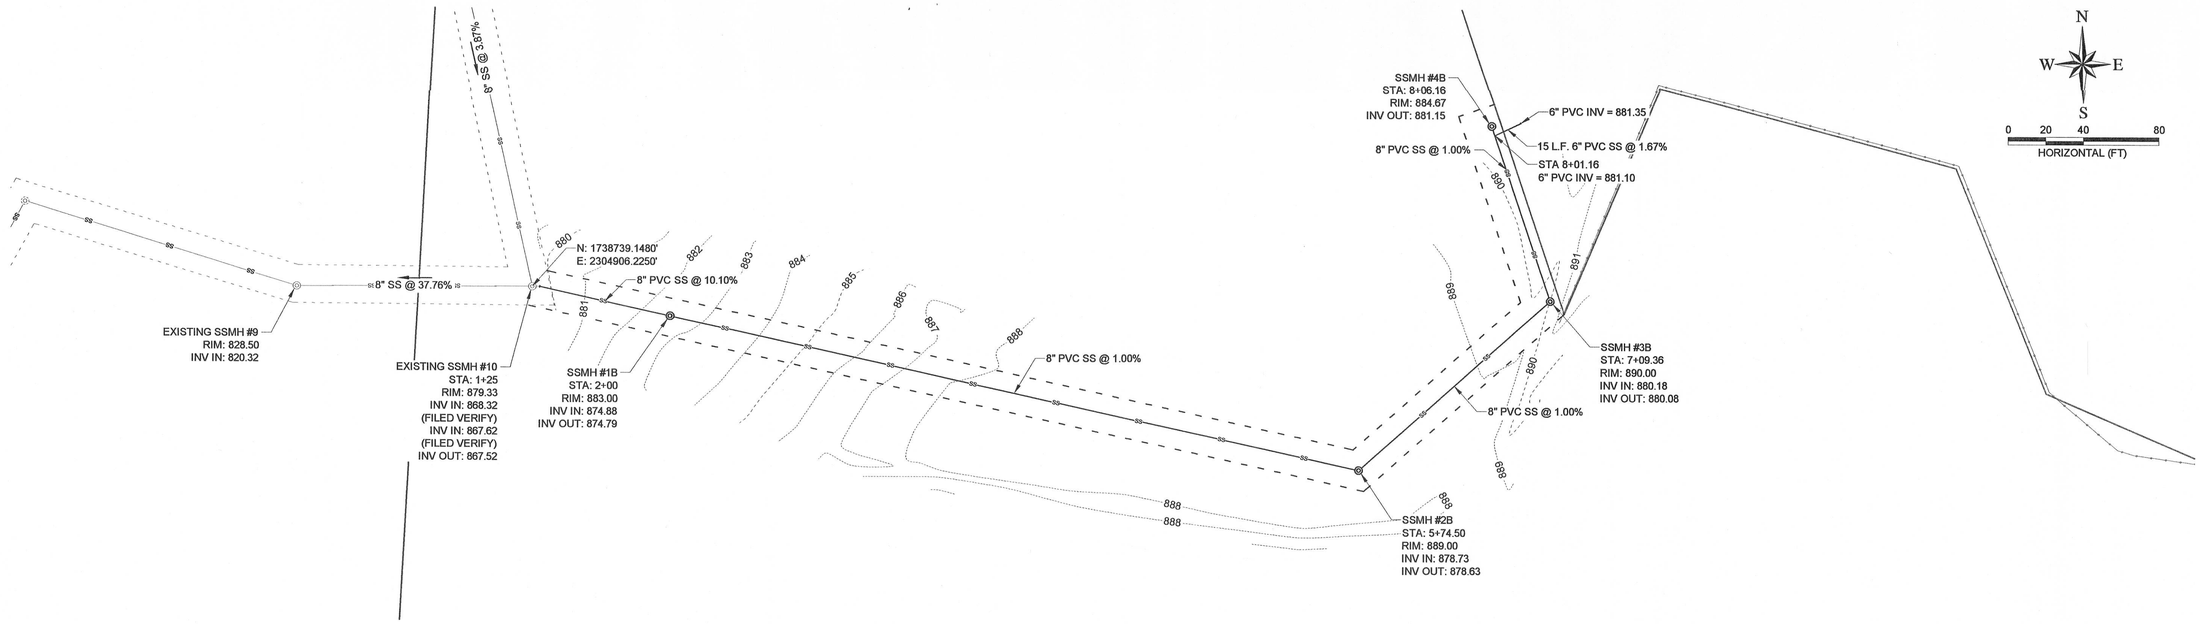

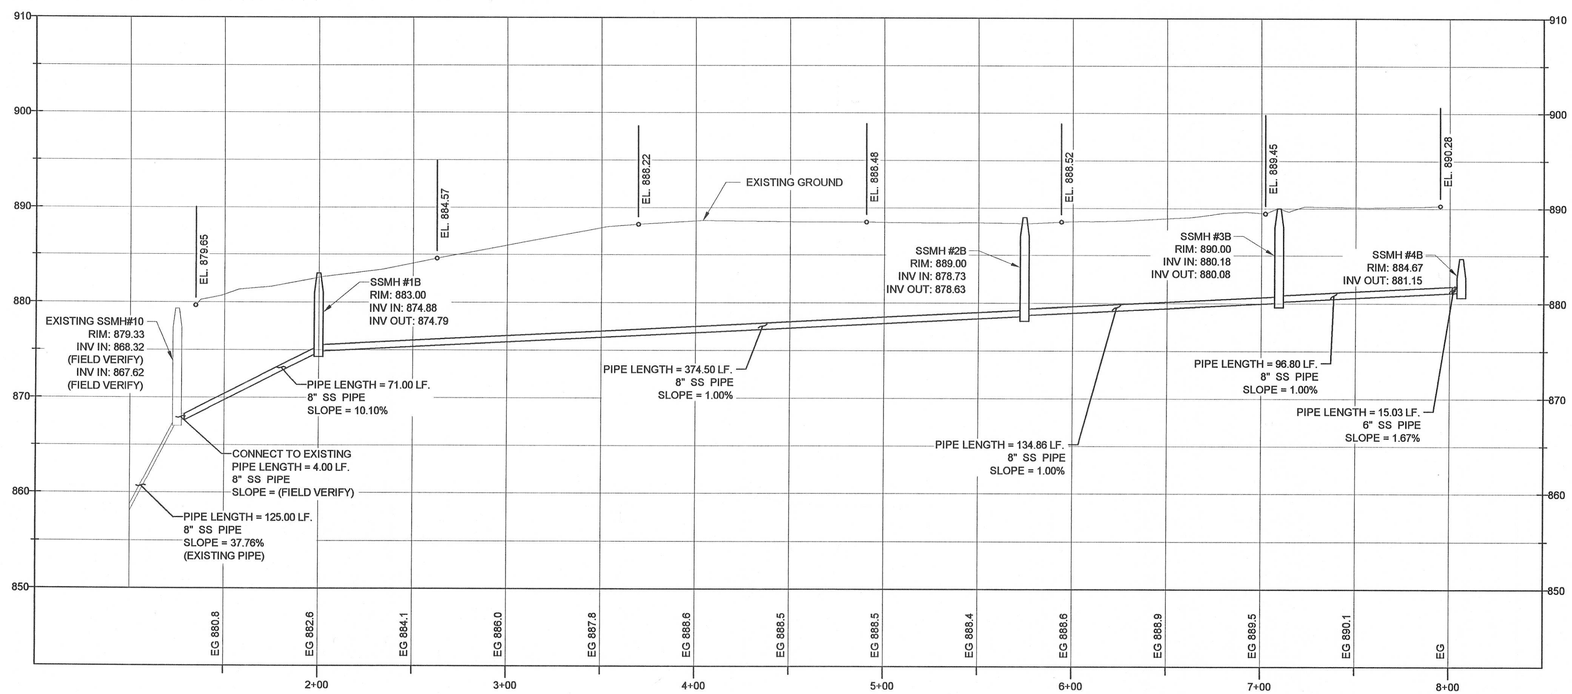

SOUTH SANITARY LINE CENTERLINE PROFILE STA: 0+50 - 8+50

77 Southway, Suite C
Lewiston, Id. 83501
Phone: (208) 743-3818
Fax: (208) 743-3819

RIEDESEL Engineering

THIS DOCUMENT, AND THE IDEAS AND DESIGNS INCORPORATED HEREIN, AS AN INSTRUMENT OF PROFESSIONAL SERVICES, IS THE PROPERTY OF RIEDESEL ENGINEERING, INC. AND IS NOT TO BE USED, IN WHOLE OR IN PART, FOR ANY OTHER PROJECT, OR THE EXTENSION OF THIS PROJECT WITHOUT THE WRITTEN AUTHORIZATION OF RIEDESEL ENGINEERING, INC.

REVISIONS

NO.	DATE	BY	DESCRIPTION
1	—	—	—
2	—	—	—
3	—	—	—
4	—	—	—
5	—	—	—
6	—	—	—

HARRY WALL INDUSTRIAL PARK
INFRASTRUCTURE EXTENSION PROJECT
2013

SOUTH SANITARY LINE

JOHN P. MORTENSON
PROFESSIONAL ENGINEER
REGISTERED
13055
12/14/12
STATE OF IDAHO

DESIGNED	BJW
DESIGN CHECKED	JRW / JPM
DETAILED	BJW
DRAWING CHECKED	JRW / JPM
FILE NAME	2060-PLAN.dwg
DRAWING DATE	12/14/12
DRAWING SCALE	AS SHOWN

SHEET 5 OF 10

PLOT DATE: 12/14/2012
E:\PROJECTS\2060-HARRY WALL INDUSTRIAL SITE EXPANSION\CADD\CIVIL 3D\DRAWINGS\2060-PLAN.DWG