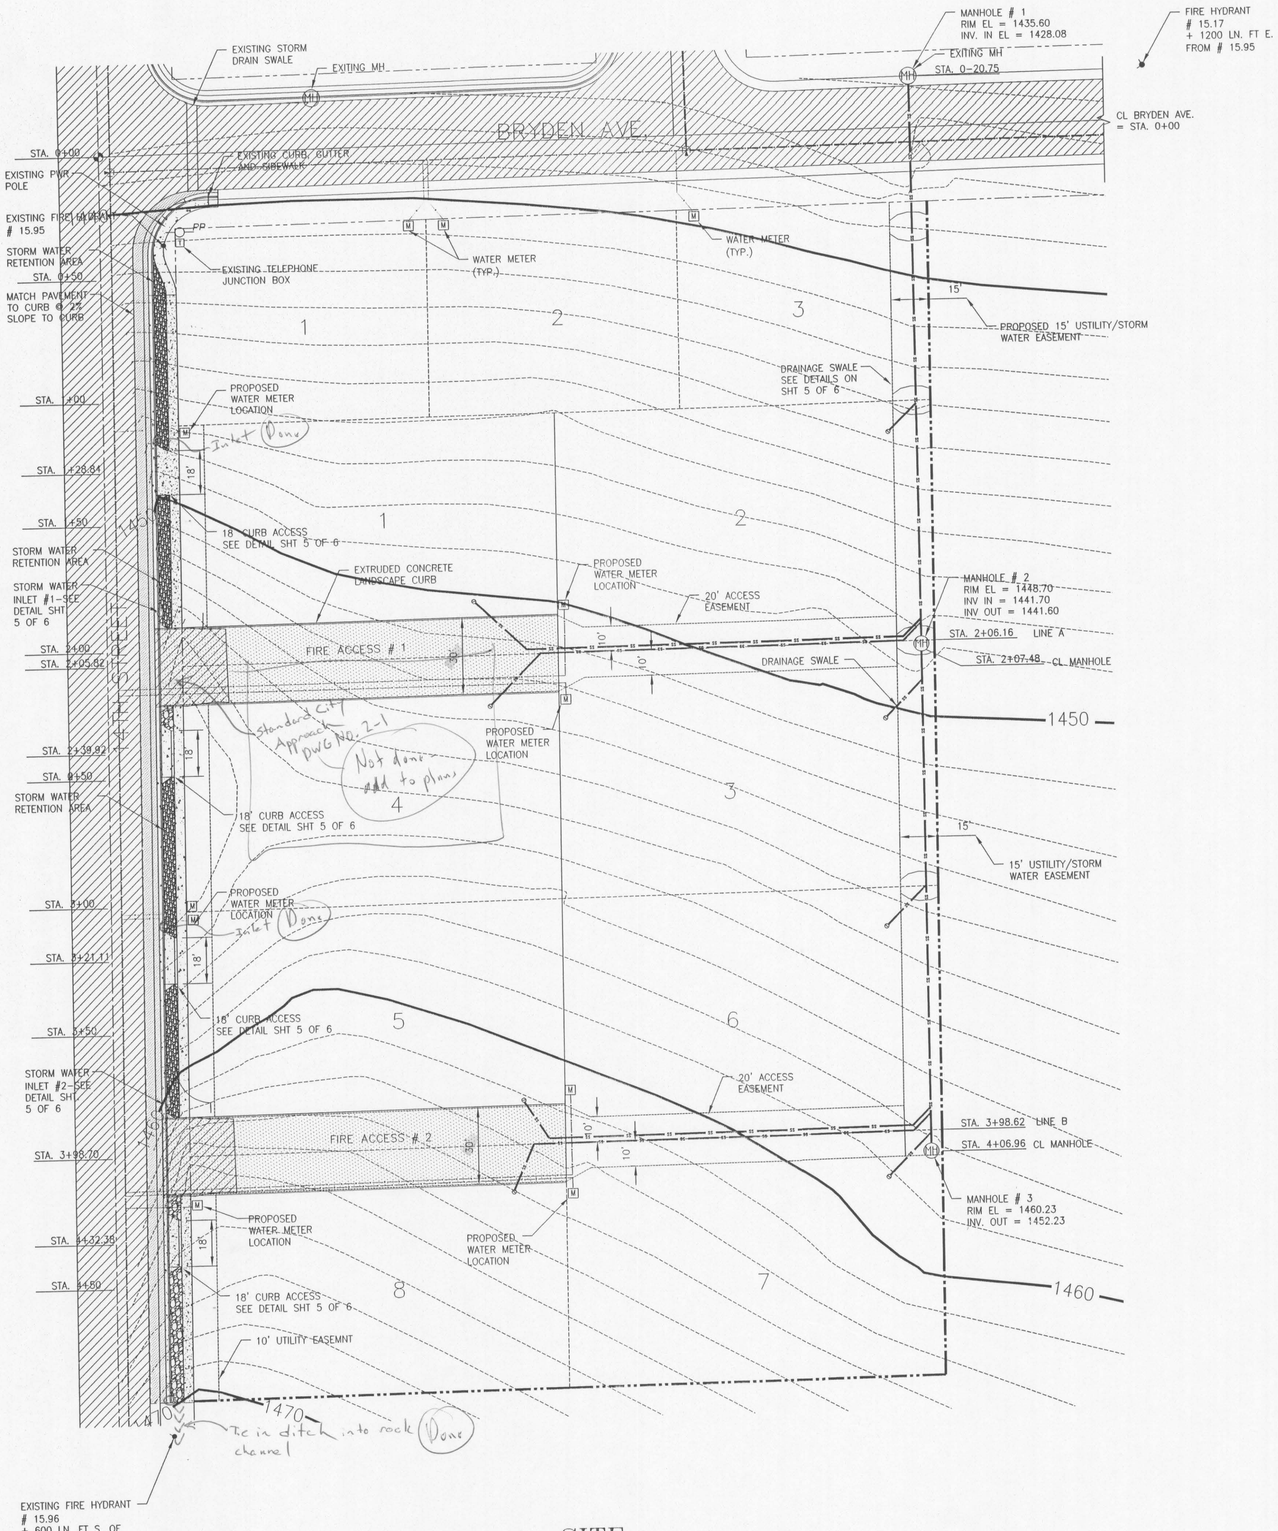

SITE

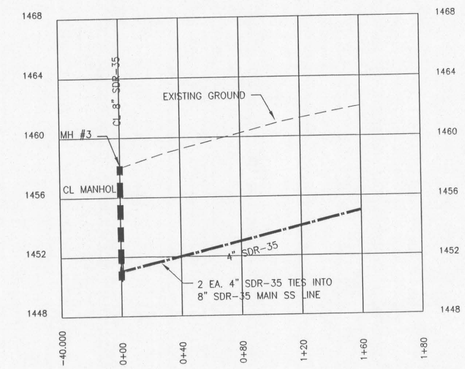

LINE "B" PROFILE

N.T.S.

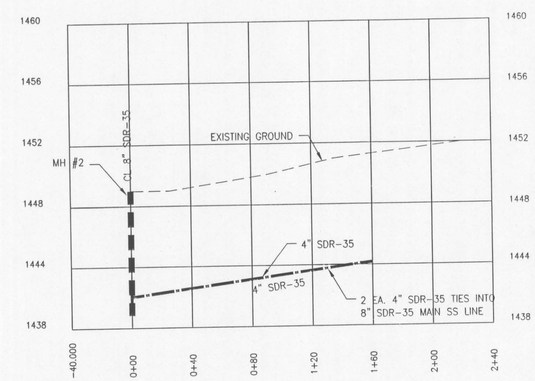

LINE "A" PROFILE

N.T.S.

LEGEND

- EXISTING ASPHALT
- BOUNDARY
- 8" SDR-35
- EASEMENT
- EXISTING LOT LINE
- EXISTING RIGHT-OF-WAY
- 1' CONTOUR
- INDEX CONTOUR
- MANHOLE
- WATER METER
- GATE VALVE
- POWER POLE
- TEE
- REDUCER
- FIRE HYDRANT

ALL WORK SHALL CONFORM TO ISPWC STANDARDS & SPECIFICATIONS

No.	DATE	BY

REVISIONS

PROFESSIONAL ENGINEER REGISTERED 1551 STATE OF IDAHO WARREN S. WATTS

CIVIL ENGINEERING
* PLANNING
* DESIGN
* RESIDENTIAL & COMMERCIAL DEV
* WATER & SEWER SYSTEM DESIGN
* ROAD DESIGN
* ENVIRONMENTAL SERVICES
PHONE (509) 780 9725
WARREN WATTS ENGINEERING

HILLVIEW ADDITION #2
TOM HILL
3525 6TH STREET
LEWISTON, ID 83501
SITE

DRAWN BY: WSW
CHECKED BY: WSW