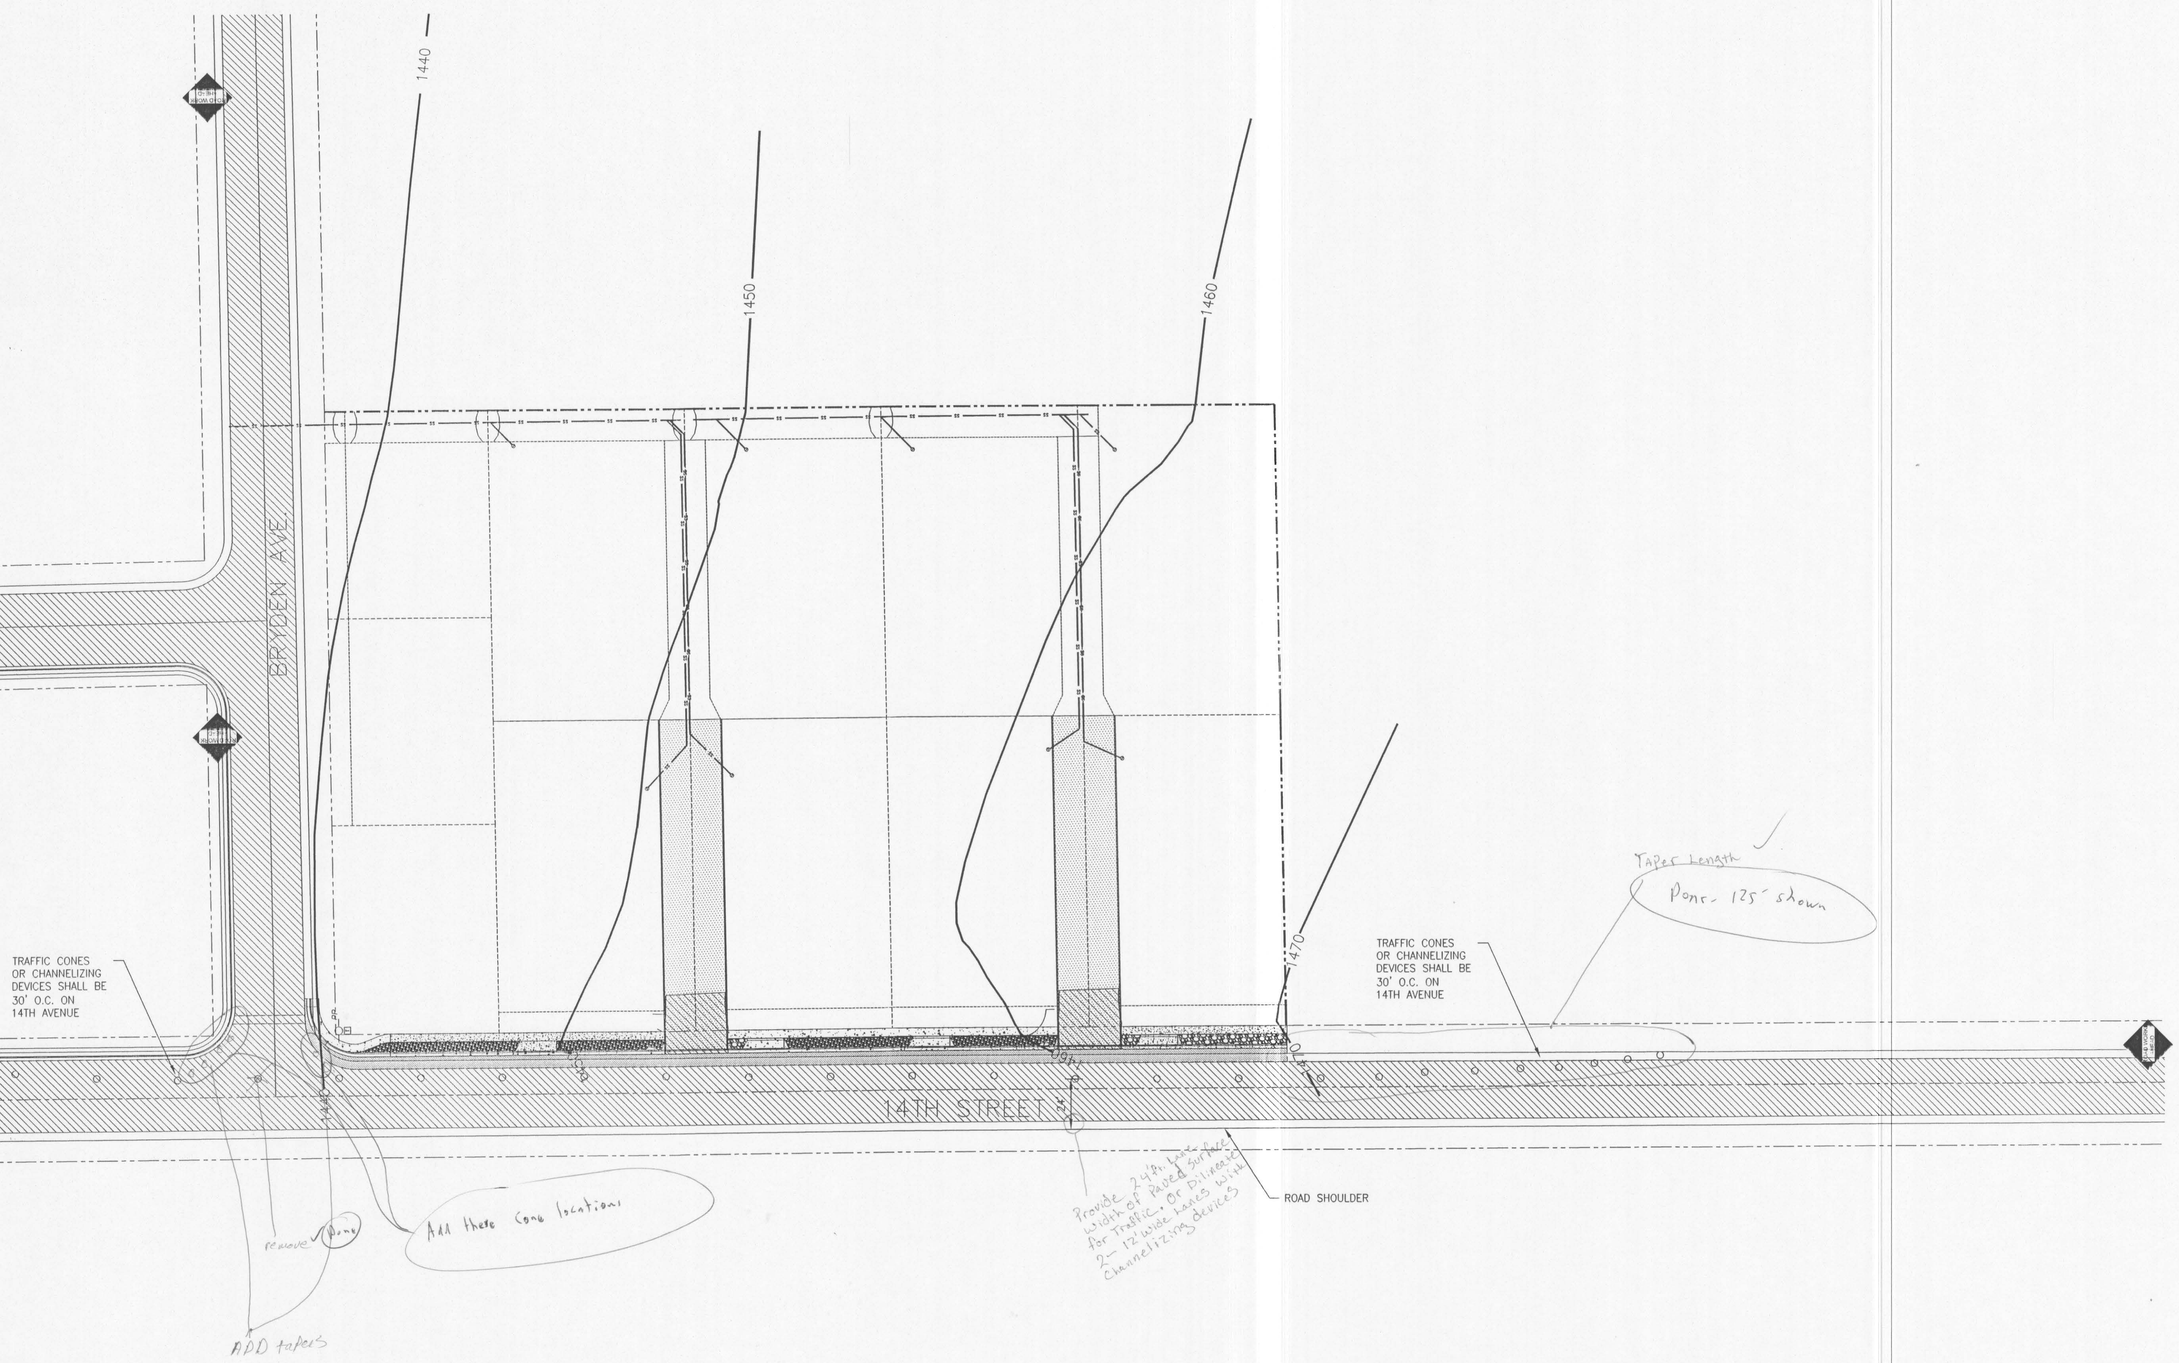

TRAFFIC CONTROL PLAN

N.T.S.

40 0 40 80

Scale: 1" = 40

No.	DATE	BY	REVISIONS

PROFESSIONAL ENGINEER REGISTERED 17551 10/30/08 STATE OF IDAHO WARREN S. WATTS

CIVIL ENGINEERING
* PLANNING
* DESIGN
* RESIDENTIAL & COMMERCIAL DEV
* WATER & SEWER SYSTEM DESIGN
* ROAD DESIGN
* ENVIRONMENTAL SERVICES

PHONE (509) 780 9725

WARREN WATTS ENGINEERING

HILLVIEW ADDITION #2
TOM HILL
3525 6TH STREET
LEWISTON, ID 83501
TRAFFIC CONTROL

DRAWN BY: WRW	CHECKED BY: WSW
DESIGNED BY: WSW	
DATE: 10/20/08	
LAST REV: 10/30/08	
PROJECT NO.: 08-032	
SHEET 6 OF 6	