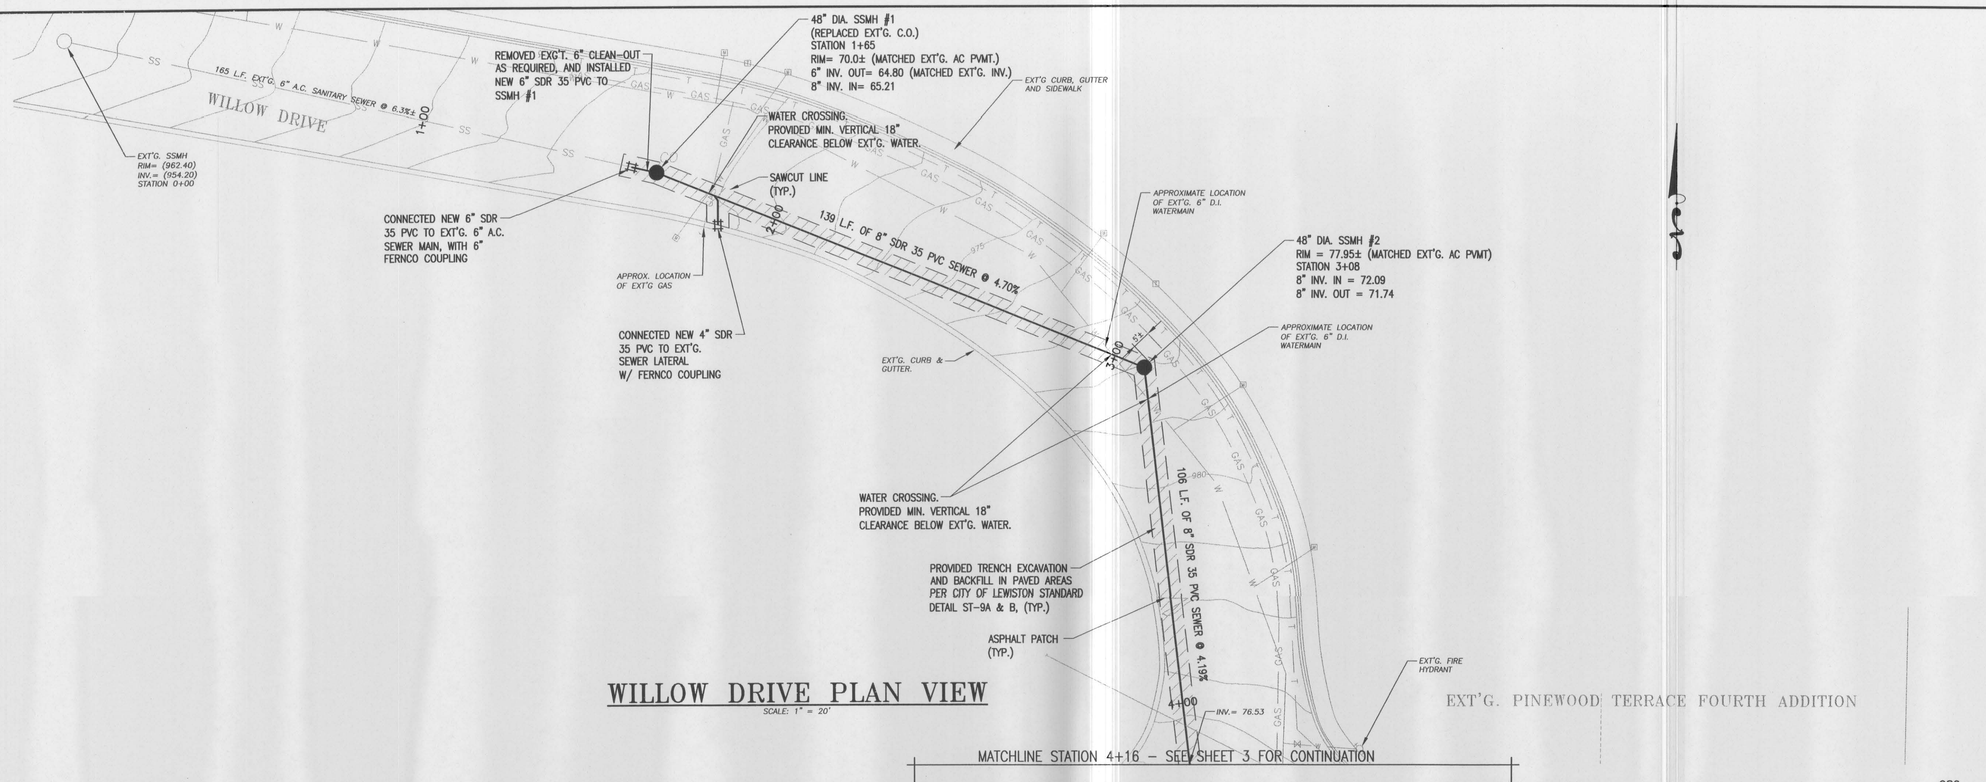

WILLOW DRIVE PLAN VIEW

SCALE: 1" = 20'

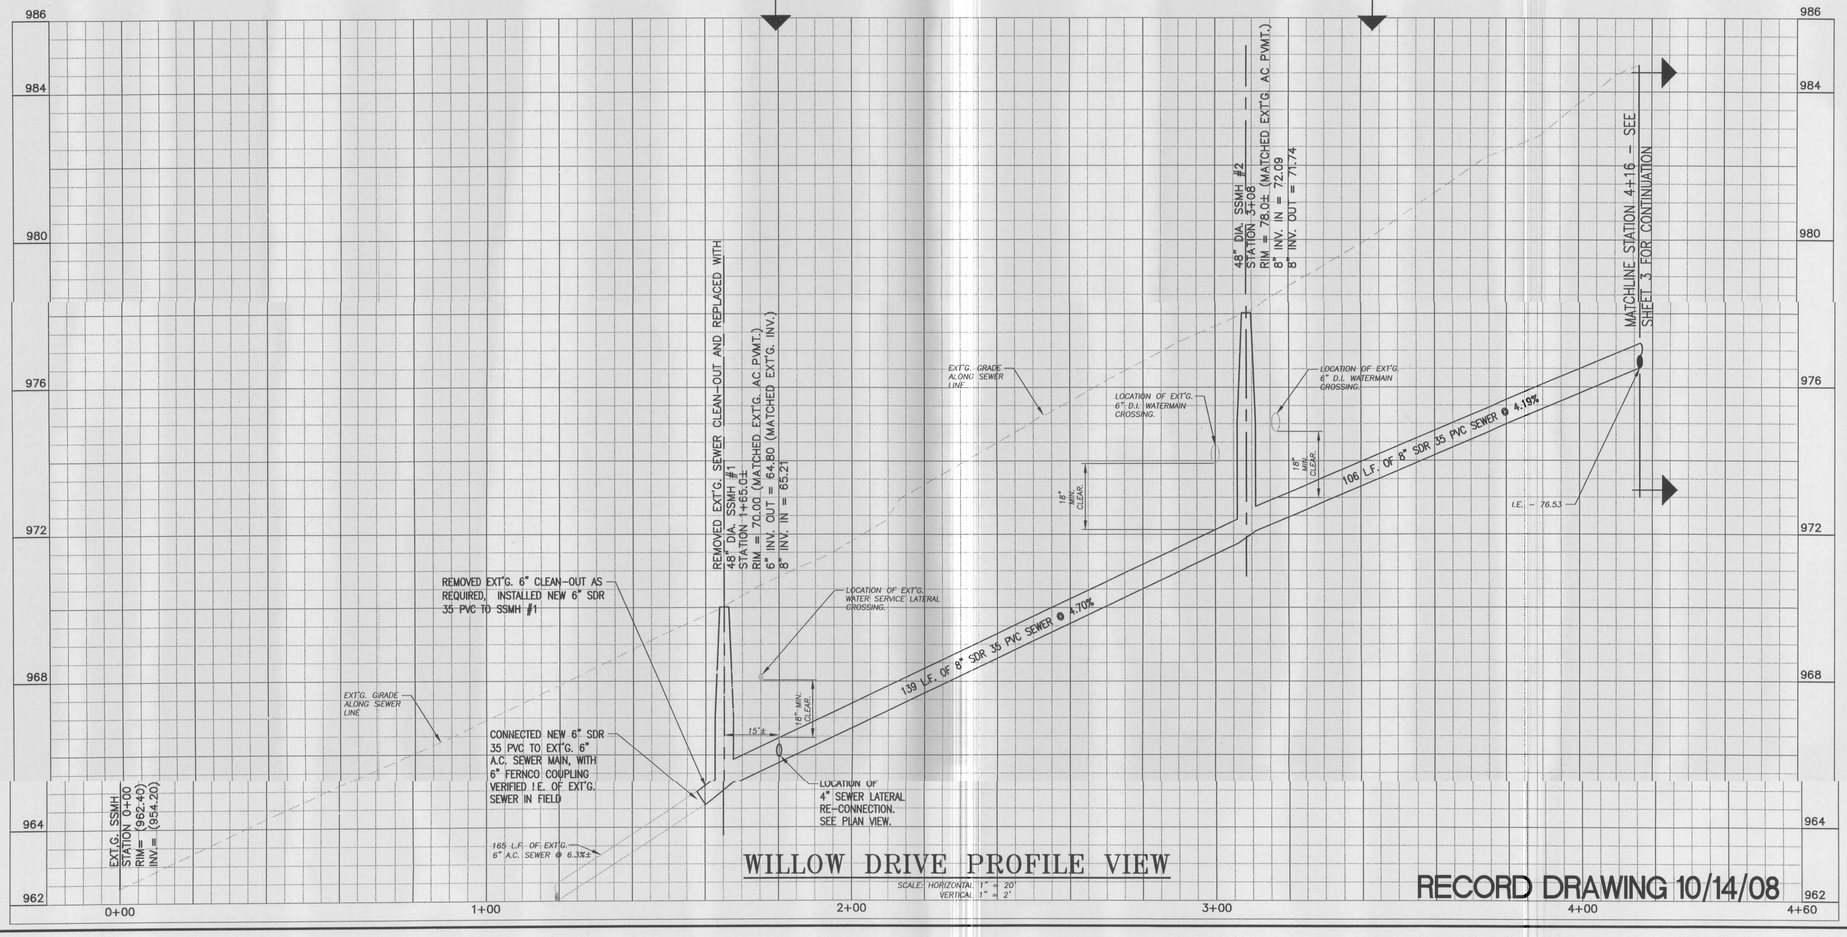

WILLOW DRIVE PROFILE VIEW

SCALE: HORIZONTAL 1" = 20'
VERTICAL 1" = 2'

RECORD DRAWING 10/14/08

No.	DATE	BY	REVISIONS

PROFESSIONAL ENGINEER — 6978 — STATE OF IDAHO — TERRY W. BRAY — Oct. 20, 2008

PROGRESSIVE ENGINEERING GROUP, INC
PLANNING ▲ DESIGN + CONSTRUCTION MANAGEMENT
1208 IDAHO STREET
LEWISTON, IDAHO 83501
PH (208) 748-5406 FAX (208) 748-9732

RICHARD AND ANNA ANDERSON
ITALIANNA GASLITE VILLAGE NO.1
WILLOW DRIVE
UTILITY PLAN & PROFILE
STATION 0+00 TO STATION 4+16.50

DRAWN BY:	CHECKED BY:
MSR	TWN
DESIGNED BY:	RDS
DATE:	02/04/08
LAST REV:	10/14/08
PROJECT NO.:	07-034
SHEET 1	OF 3