


## ELEVENTH AVE. PLAN VIEW

SCALE: 1" = 20'

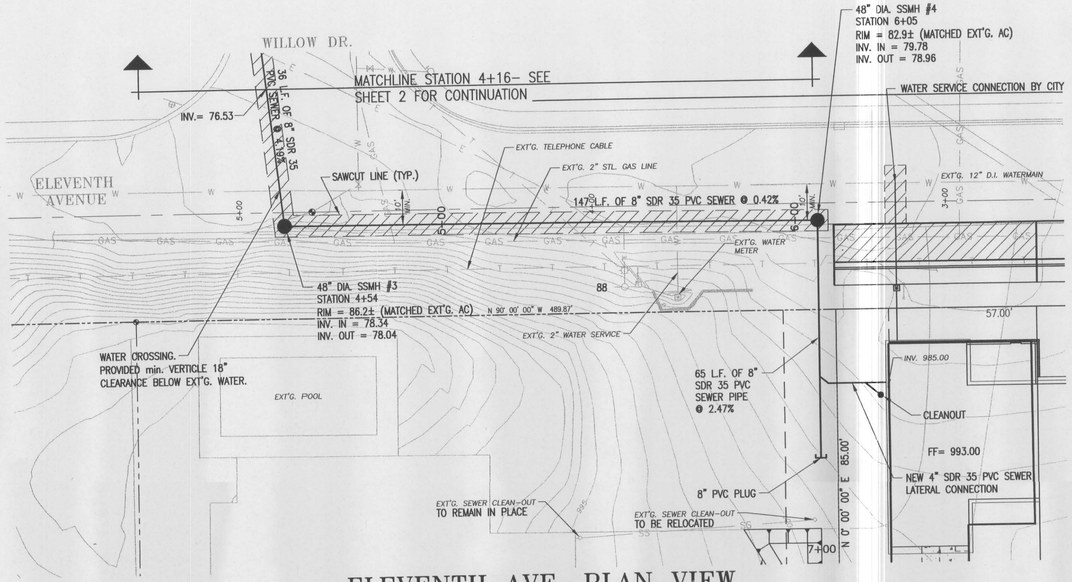


## ELEVENTH AVE. PROFILE VIEW

SCALE: HORIZONTAL 1" = 20'
VERICAL 1" = 2'

RECORD DRAWING 10/14/08

| No. | DATE | BY | REVISIONS |
|---|---|---|---|
| | | | |

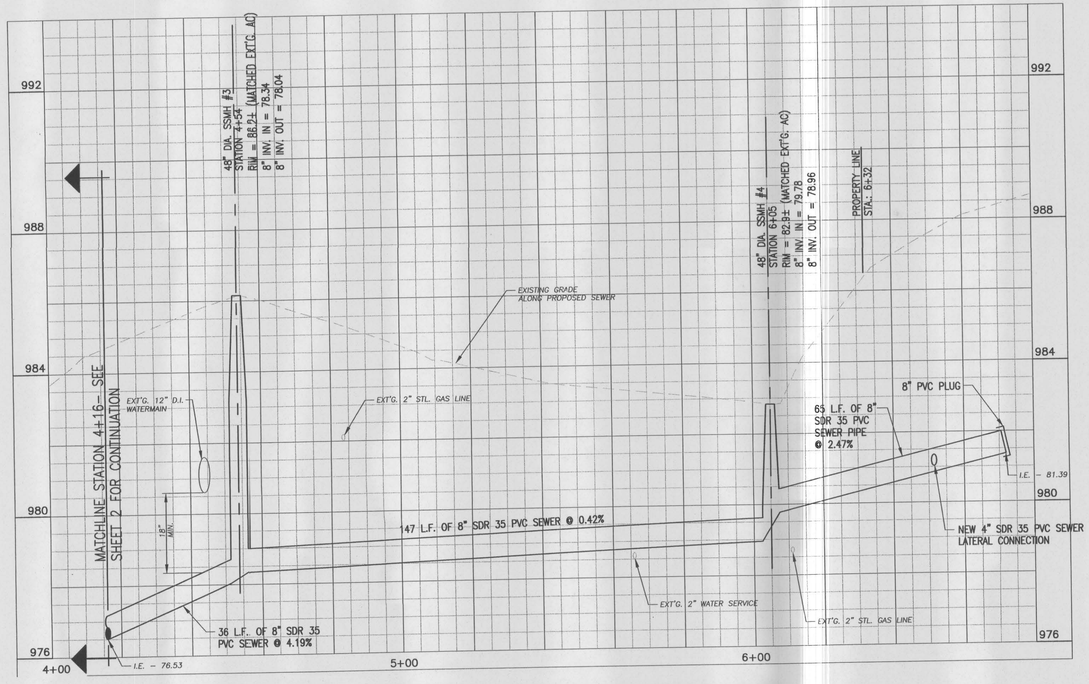PROFESSIONAL ENGINEER — 6978 — STATE OF IDAHO — JERRY W. HUNT — Oct. 29, 2008


PROGRESSIVE ENGINEERING GROUP, INC
PLANNING ◬ DESIGN + CONSTRUCTION MANAGEMENT
1208 IDAHO STREET
LEWISTON, IDAHO 83501
PH (208) 746-6406 FAX (208) 746-9732


RICHARD AND ANNA ANDERSON
ITALIANNA GASLITE VILLAGE NO.1
ELEVENTH AVENUE
UTILITY PLAN & PROFILE
STATION 4+16.50 TO STATION 7+71

| | |
|---|---|
| DRAWN BY: MSR | CHECKED BY: TWN |
| DESIGNED BY: RDS | |
| DATE: 06/05/07 | |
| LAST REV: 10/14/08 | |
| PROJECT NO.: 07-034 | |
| SHEET 2 OF 3 | |

Z:\Company Shares\AutoCAD\PEG\DRAW\07 JOBS\07-034\ASBUILTS\07-034 SHT 2.dwg, SHT2, 10/15/2008 8:14:13 AM, PROGRESS.pc3, JAY