



# NORTH 4TH STREET PROPOSED SITE PLAN

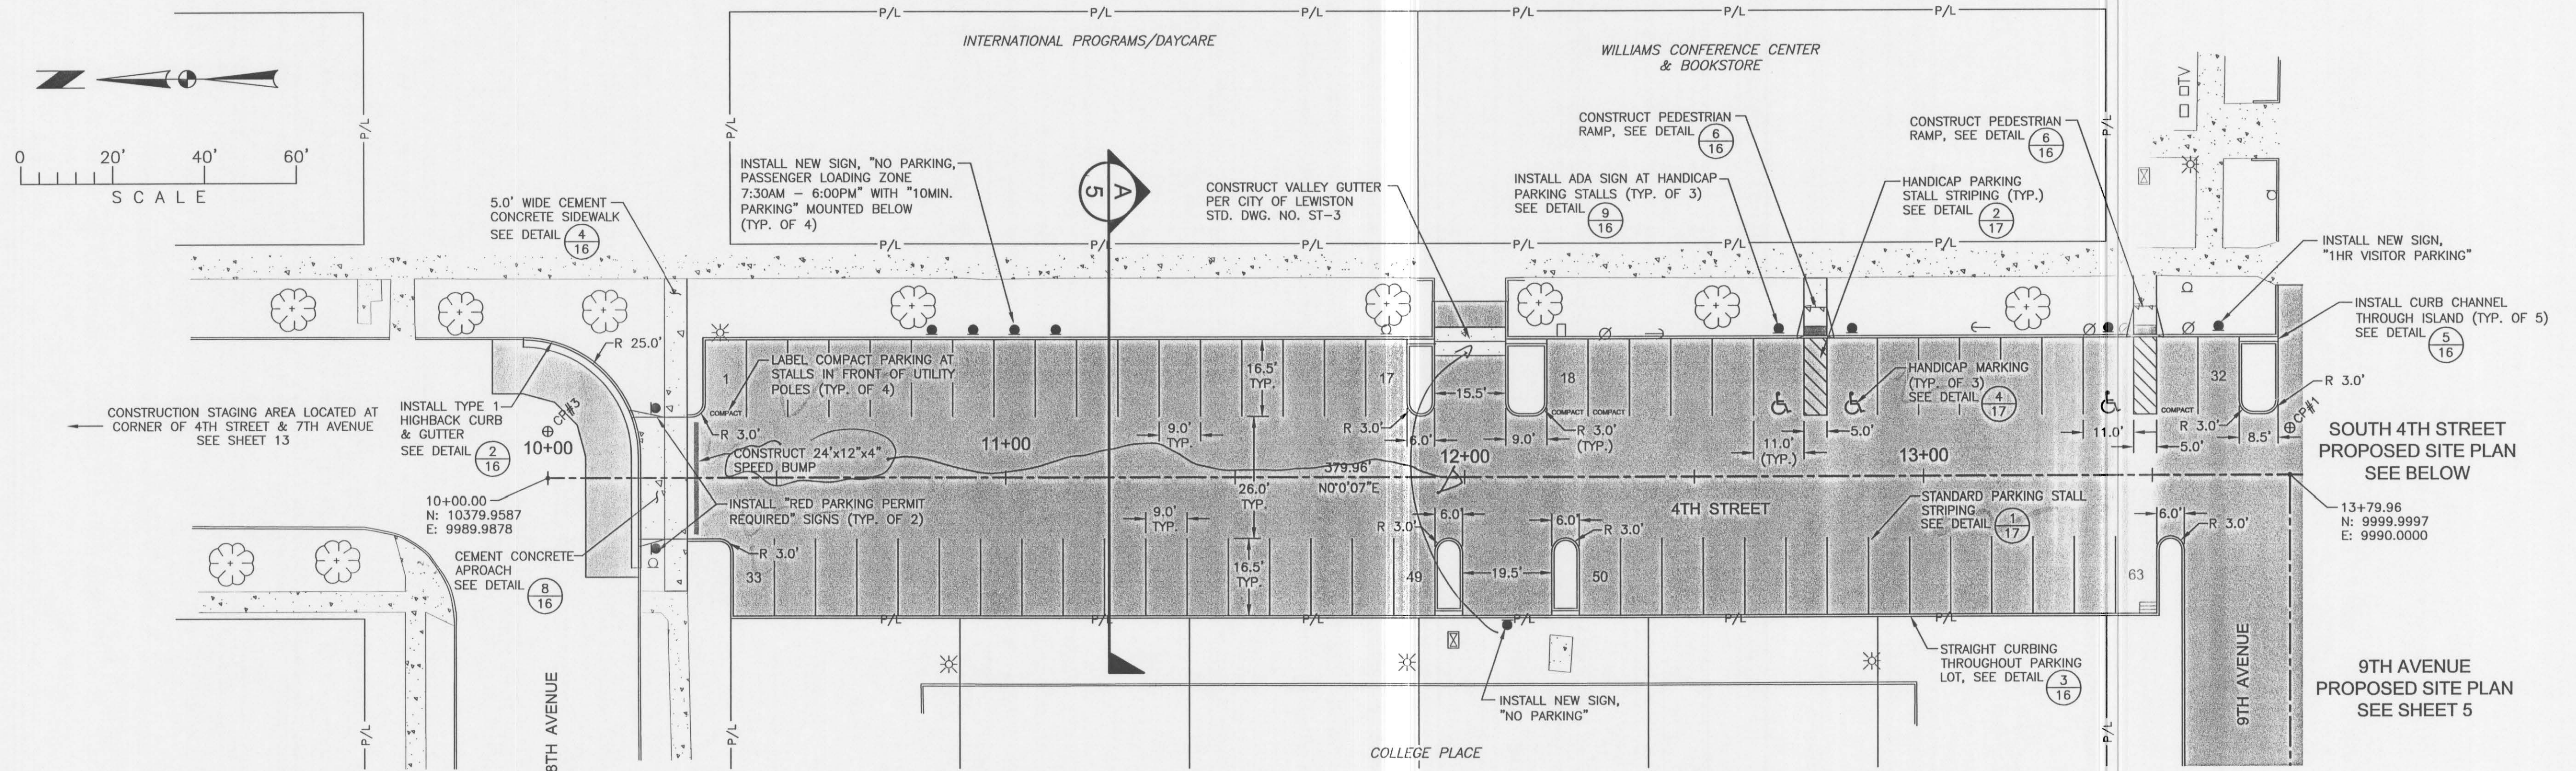

# SOUTH 4TH STREET PROPOSED SITE PLAN

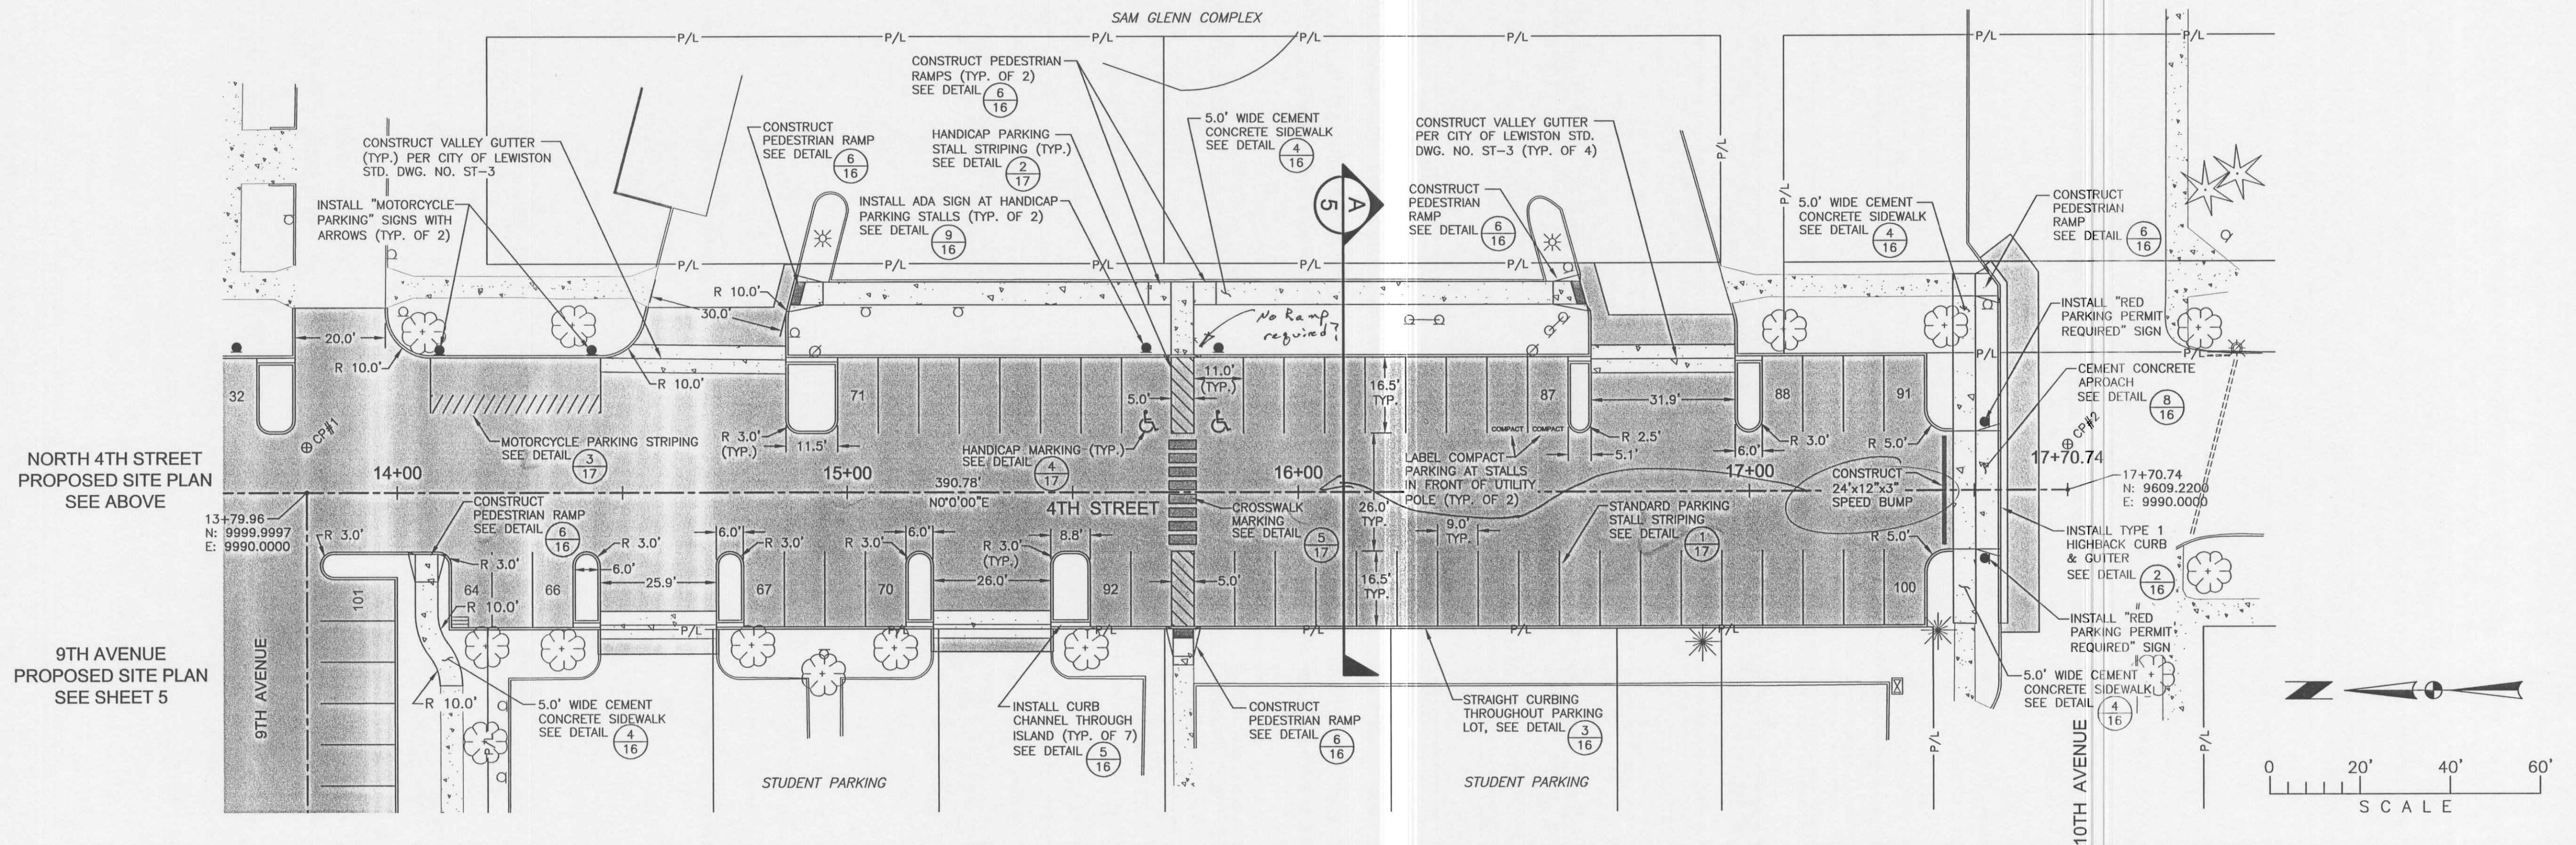

THOMAS, DEAN & HOSKINS, INC.  
ENGINEERING CONSULTANTS  
GREAT FALLS - BOZEMAN - KALISPELL  
SPOKANE - LEWISTON - IDAHO  
LEWISTON, ID 83501 (208) 746-0938

TD&H

DRAWN BY: HRF/TJP  
DESIGNED BY: JLN  
QUALITY CHECK:  
DATE: 05.25.07  
JOB NO. L06-020  
FIELDBOOK

DPW PROJECT NO. 07150 - LCSC 4TH STREET PARKING  
LEWISTON, IDAHO  
4TH STREET  
PROPOSED SITE PLAN

CAD NO. L06020-04.DWG  
SHEET 4 OF 17