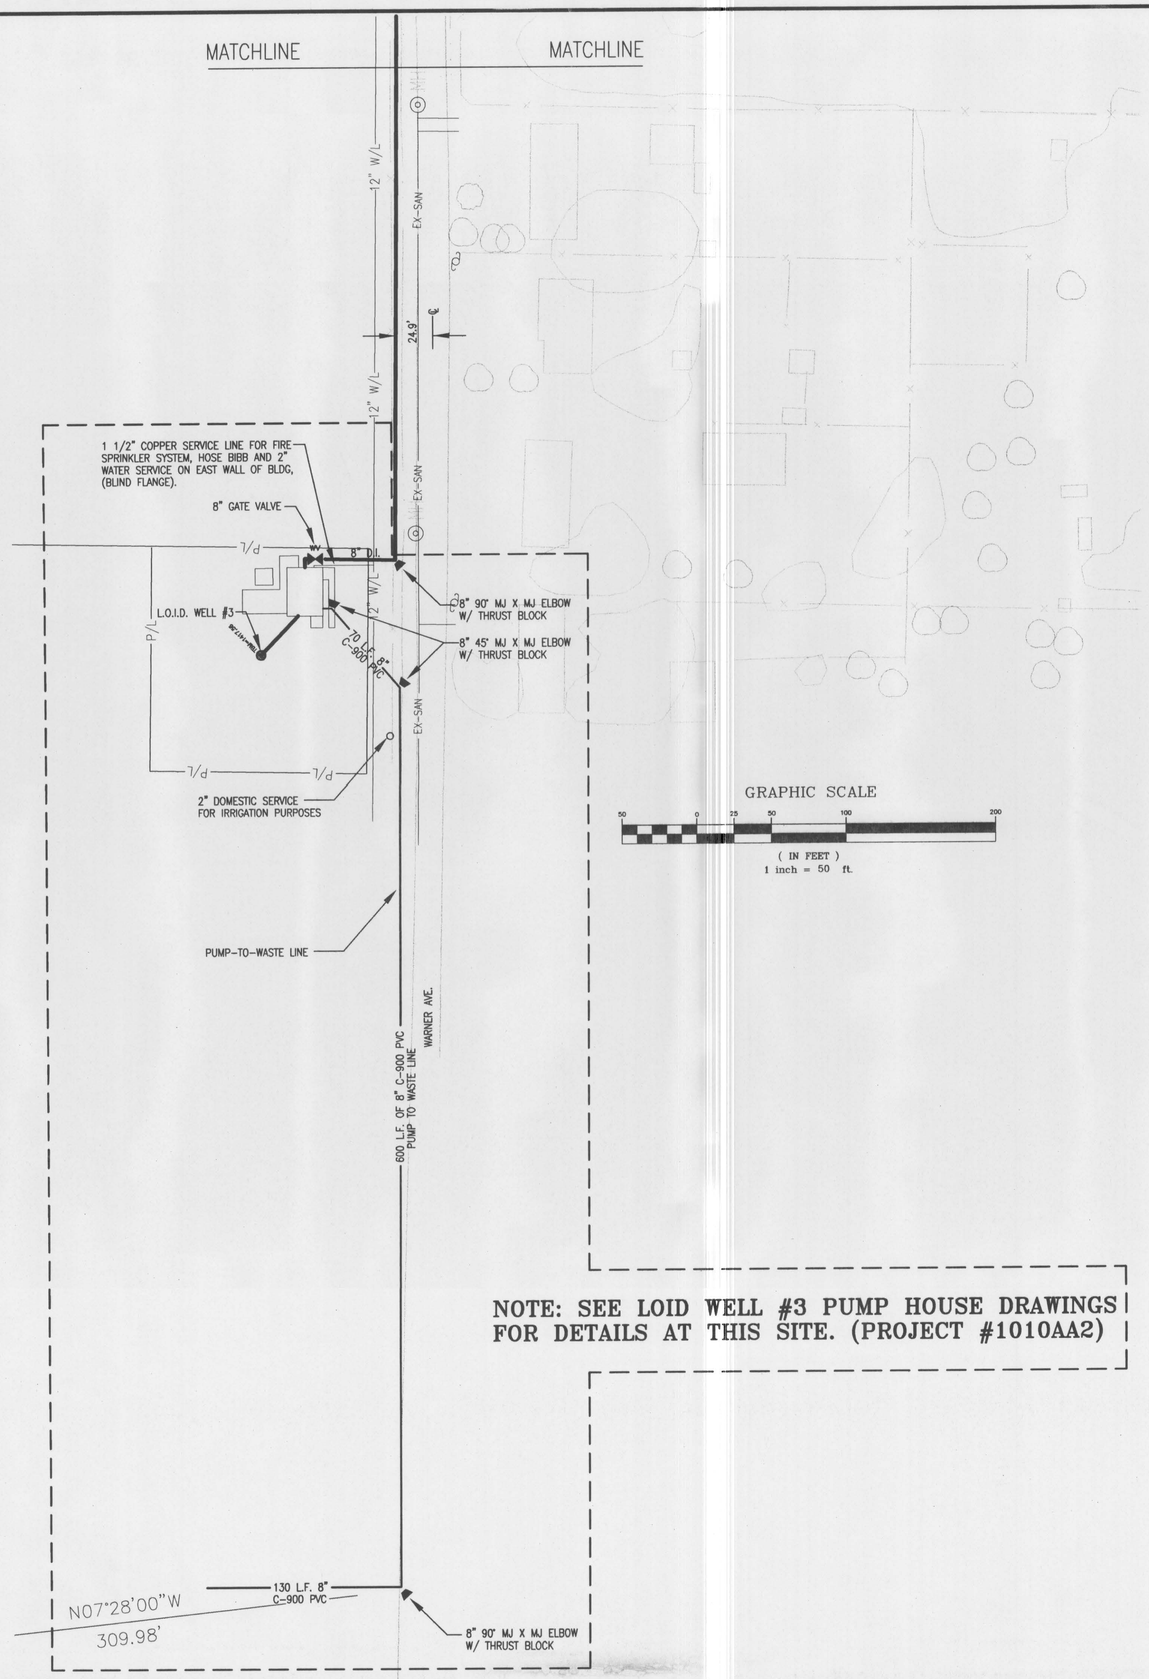

GRAPHIC SCALE

50 0 25 50 100 200

(IN FEET)
1 inch = 50 ft.

NOTE: SEE LOID WELL #3 PUMP HOUSE DRAWINGS FOR DETAILS AT THIS SITE. (PROJECT #1010AA2)

POST CONSTRUCTION DRAWINGS

THESE DRAWINGS REPRESENT THE CONSTRUCTION WORK AS NEAR AS CAN BE DETERMINED. THEY WERE PREPARED FROM INFORMATION GATHERED DURING CONSTRUCTION ACTIVITY BY THE CONTRACTORS AND INSPECTORS AND ARE THOUGHT TO BE ACCURATE. HOWEVER NO GUARANTEE OR WARRANTY IS EXPRESSED OR IMPLIED AS TO THEIR EXACTNESS AND THEY SHOULD BE USED ONLY AS A GENERAL REPRESENTATION OF THE CONSTRUCTION WORKS.

NO.	DATE	BY	FILENAME	REVISIONS
0			INT-16TH.DWG	ORIGINAL DRAWING

PROFESSIONAL ENGINEER REGISTERED 7036 STATE OF IDAHO LOWELL JAMES CUTSHAW 1-22-97

WYATT ENGINEERING
ENGINEERS • SURVEYORS
W. 1801 BROADWAY, #110
SPOKANE, WA 99201
FAX (509) 328-1423
PH (509) 328-5139
101 THAIN ROAD
LEWISTON, ID 83501
FAX (208) 746-8815
PH (208) 746-2661

CITY OF LEWISTON, IDAHO
L.O.I.D. INTERTIE PROJECT
WARNER AVE.

DRAWN BY: HI	CHECKED BY: LJC
DESIGNED BY: SSS	
SCALE: 1" = 50'	
DATE: 06/16/97	
PROJECT NO.: 1010AA4	
SHEET 2 OF 8	