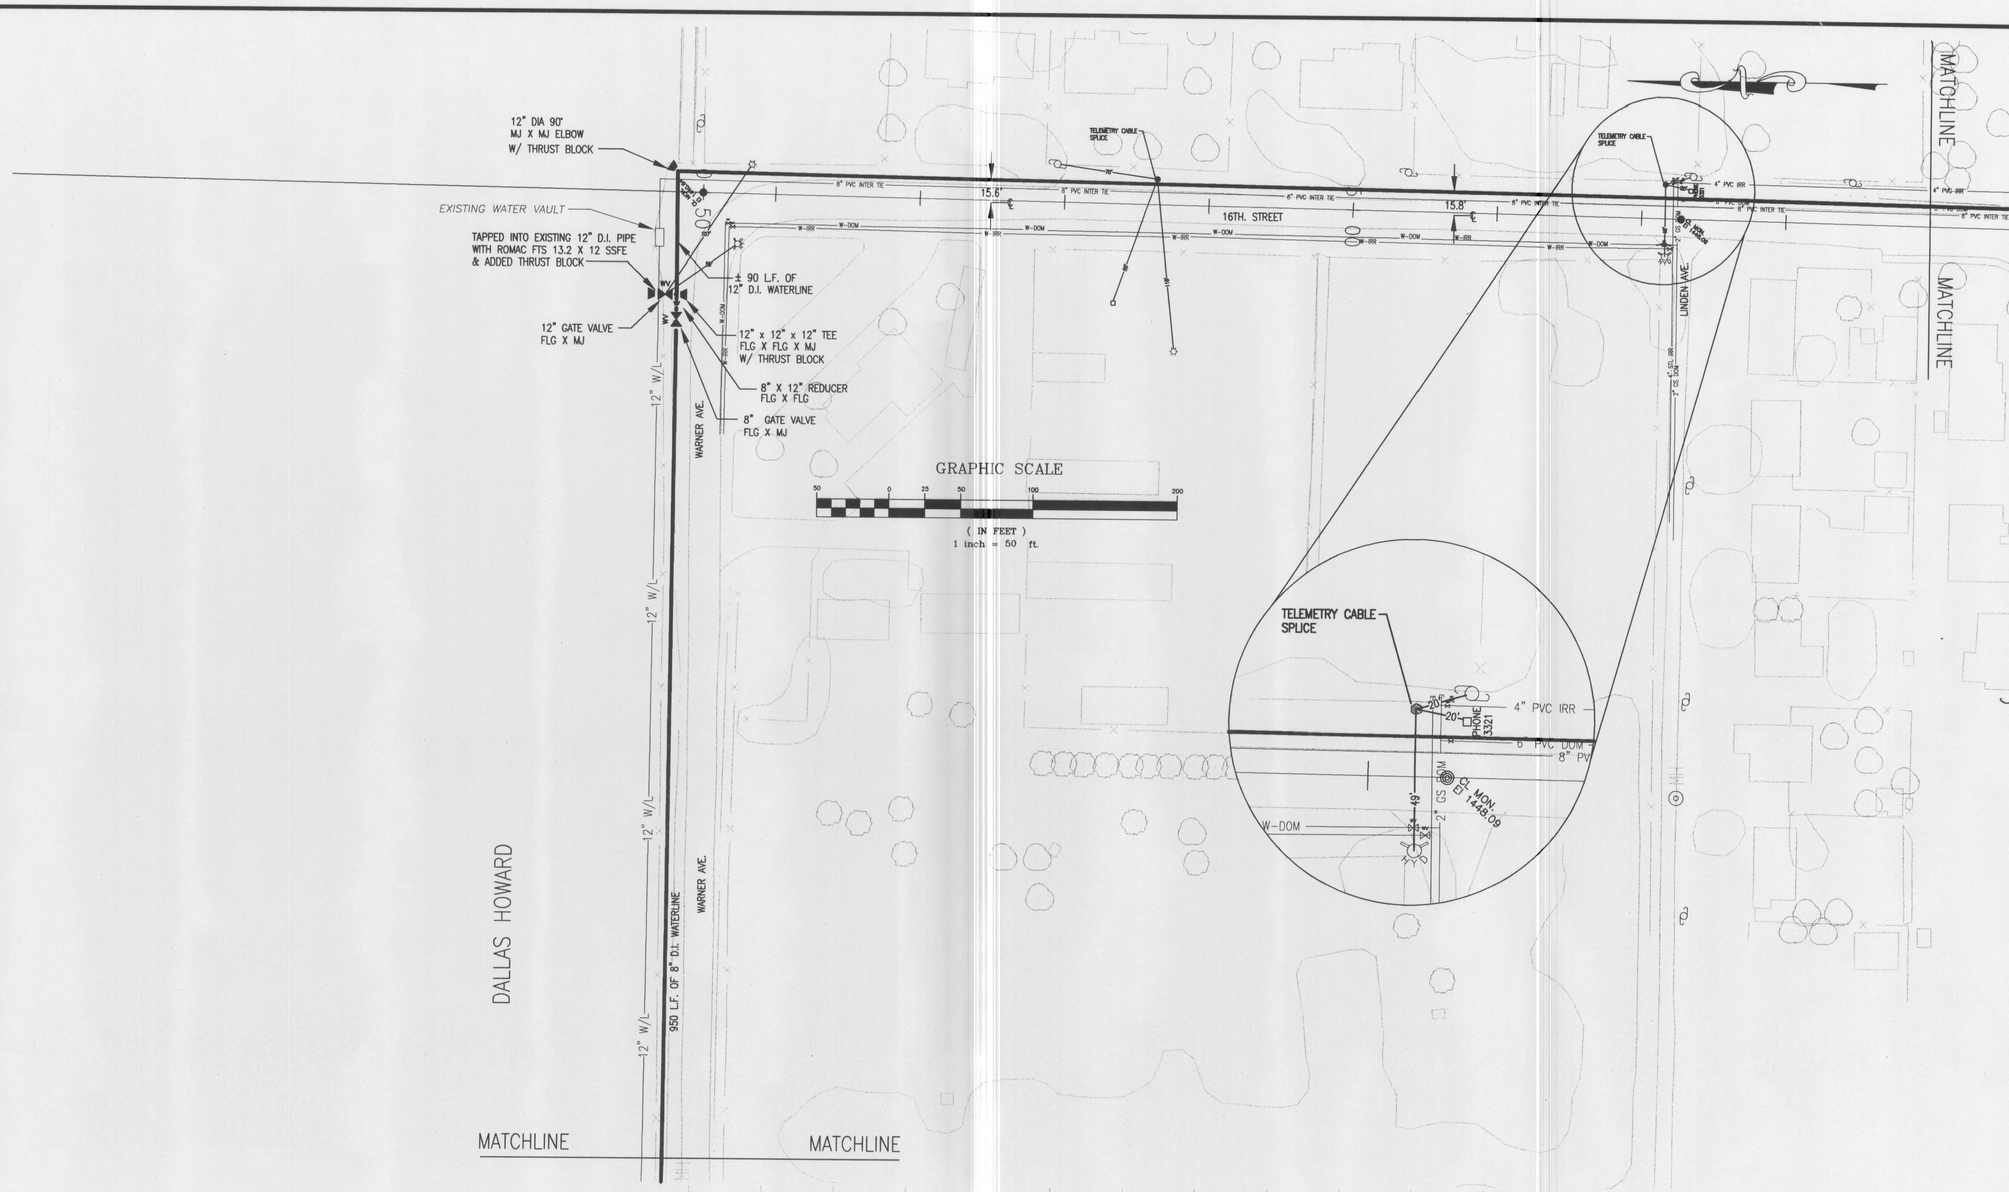

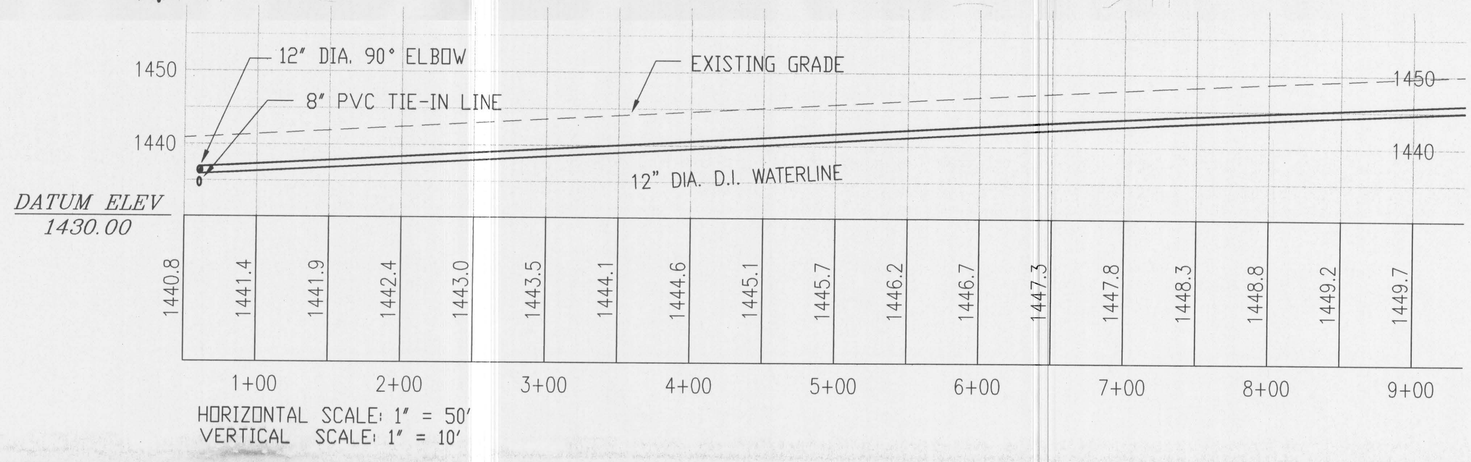

POST CONSTRUCTION DRAWINGS

THESE DRAWINGS REPRESENT THE CONSTRUCTION WORK AS NEAR AS CAN BE DETERMINED. THEY WERE PREPARED FROM INFORMATION GATHERED DURING CONSTRUCTION ACTIVITY BY THE CONTRACTORS AND INSPECTORS AND ARE THOUGHT TO BE ACCURATE. HOWEVER NO GUARANTEE OR WARRANTY IS EXPRESSED OR IMPLIED AS TO THEIR EXACTNESS AND THEY SHOULD BE USED ONLY AS A GENERAL REPRESENTATION OF THE CONSTRUCTION WORKS.

NO.	DATE	BY	REVISIONS
0			

FILENAME: INT-16TH.DWG

ORIGINAL DRAWING

PROFESSIONAL ENGINEER REGISTERED 7036 STATE OF IDAHO 1-22-99 RUSSELL JAMES CUTSHAW

WYATT ENGINEERING
ENGINEERS • SURVEYORS
W. 1801 BROADWAY, #110
SPOKANE, WA. 99201
FAX (509) 328-0423
PH (509) 328-5139
101 THAIN ROAD
LEWISTON, ID 83501
FAX (208) 746-6825
PH (208) 746-2661

CITY OF LEWISTON, IDAHO
L.O.I.D. INTERTIE PROJECT
16th STREET
STA: 0+50.0 TO STA: 9+00.0

DRAWN BY: H	CHECKED BY: LJC
DESIGNED BY: SSS	
SCALE: 1" = 50'	
DATE: 06/16/97	
PROJECT NO.: 1010AA4	
SHEET 3 OF 8	

C:\SDSCRIPT\1010aa\INT-R12ASBUILT Thu Jan 21 11:54:36 1999 CAD STATION #2