


LINDEN AVENUE PLAN

LINDEN AVENUE Q & PROFILE

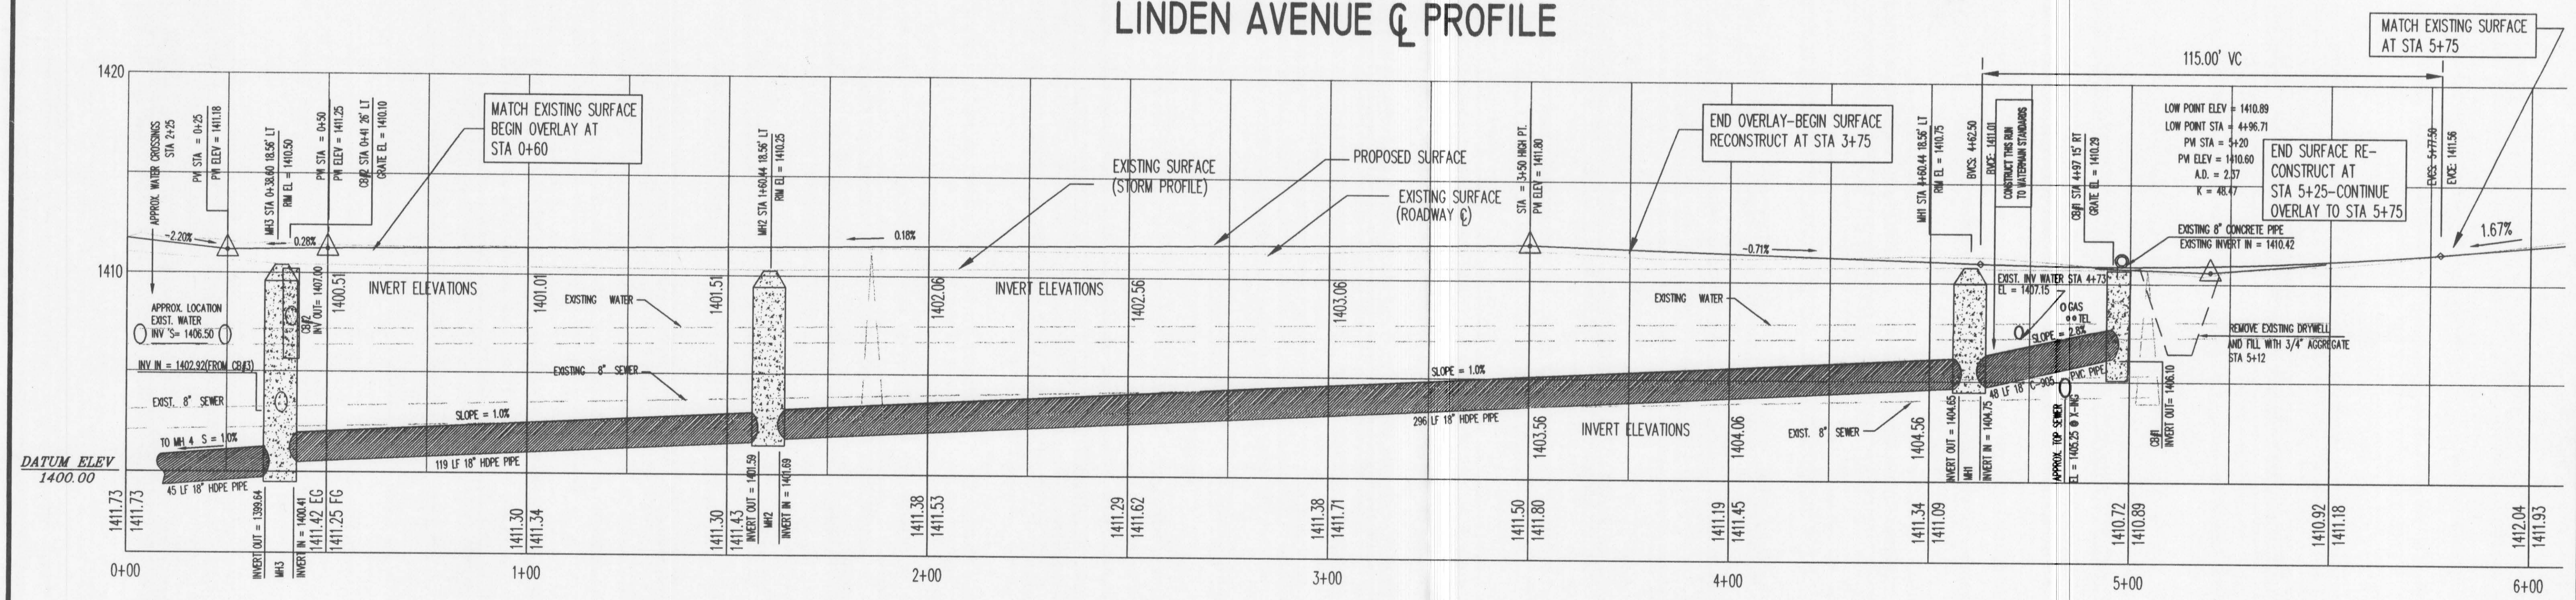

DESIGNED BY:	M.H.
DRAWN BY:	M.H.
CHECKED BY:	T.R.
DATE:	5/15/2000
DRAWING NO.:	L5B
SHEET NO. OF:	2 OF 6

LINDEN AVENUE PLAN & PROFILE  
 CITY OF LEWISTON  
 ENGINEERING DEPARTMENT  
