



CENTERLINE ROAD GRADES PER NEZ PERCE COUNTY APPROVED PLANS BY KELTIC ENGINEERING, INC. DATED 03-23-09

THE PRE-INSTALLED SEWER LINE SHALL BE EXPOSED EVERY 100' WITH COMPACTION TESTING FROM SURFACE LEVEL TO EXPOSED PIPE. ALL COMPACTION TESTS MUST PASS REQUIRED TESTS. SEWER LINE SHALL BE VIDEO RECORDED. ANY ABNORMALITIES IN THE PIPE OR JOINTS SHALL BE DUG UP AND VERIFIED THAT NO ISSUE EXISTS. COMPACTION TESTS SHALL CONFORM TO THE REQUIRED SPECIAL INSPECTION TESTING FOR NEW INSTALLATION.

NEW SANITARY SEWER MANHOLE PER CITY OF LEWISTON STD. DWG. 5-3, 5-6, 5-7, AND 5-8 (TYP.)

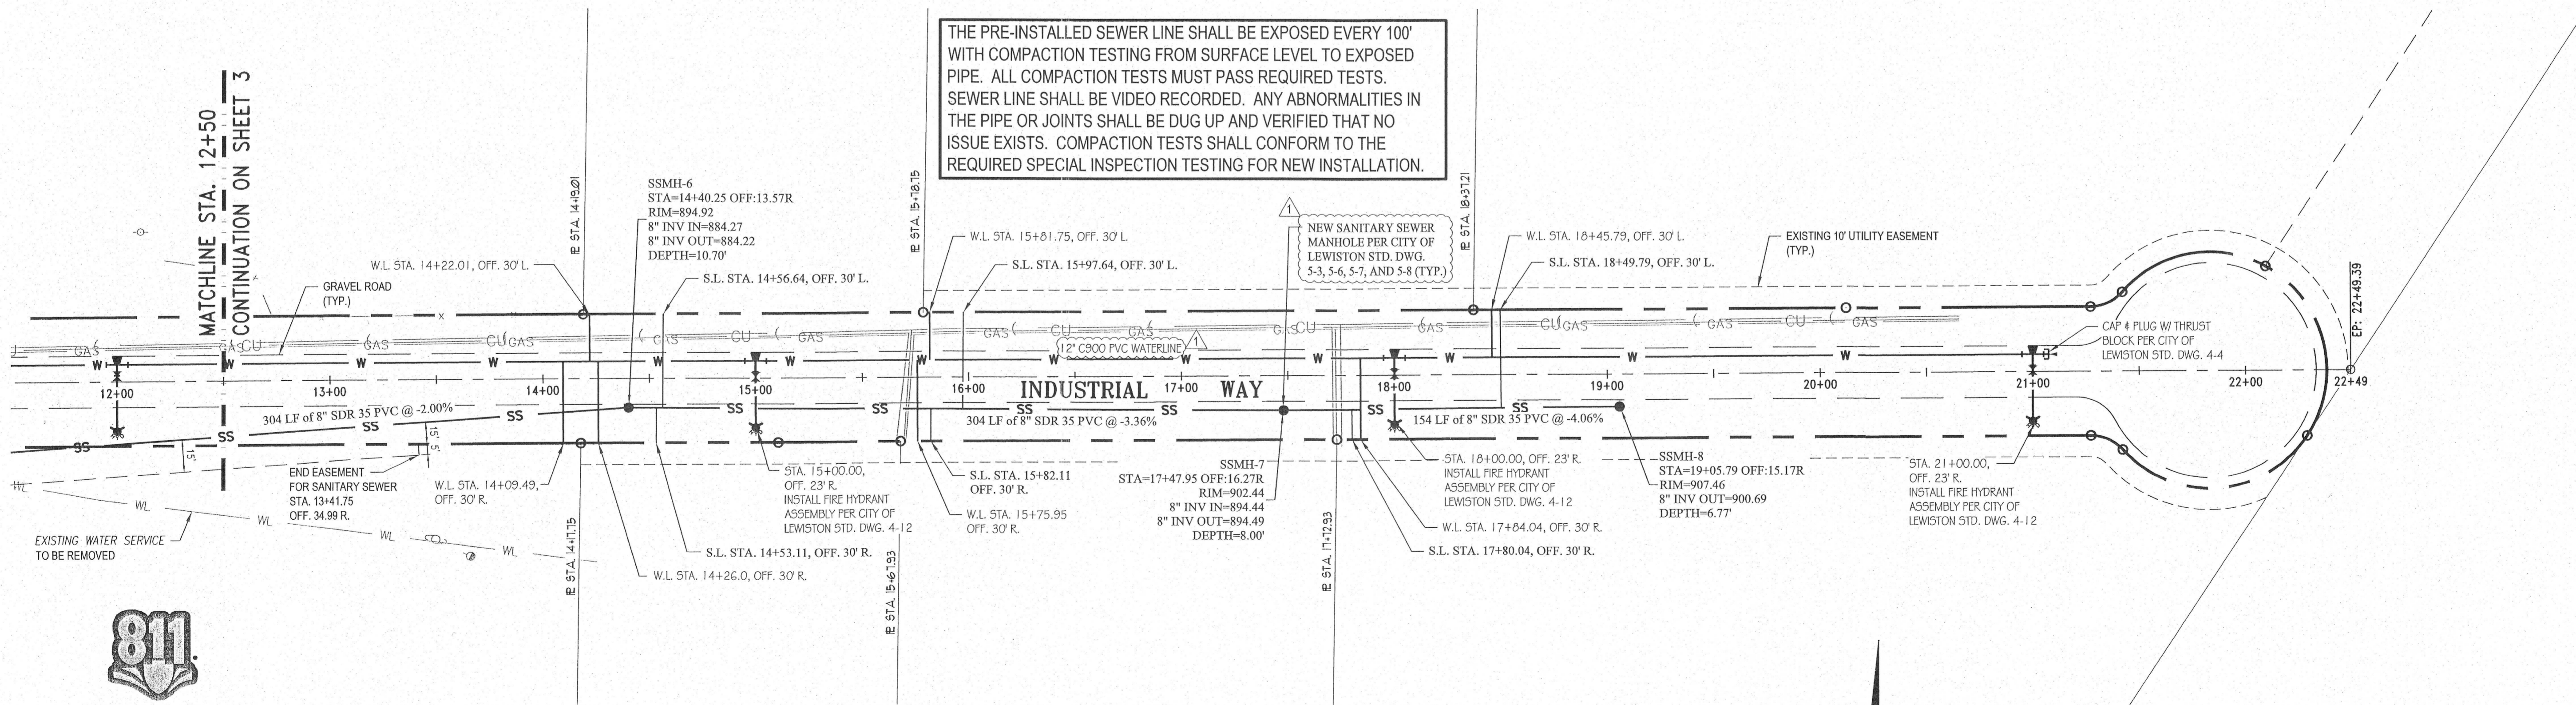

SEWER & WATER - STA. 12+50 - 23+00

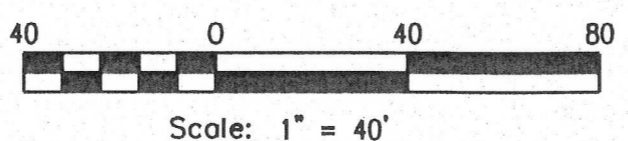

Know what's below. Call before you dig.

CALL 2 BUSINESS DAYS IN ADVANCE BEFORE YOU DIG, GRADE, OR EXCAVATE FOR THE MARKING OF UNDERGROUND MEMBER UTILITIES

No.	DATE	BY	DESCRIPTION
1	4-01-14	JDM	CITY OF LEWISTON PLAN REVIEW #014-000005 - 03-20-14

INDUSTRIAL WAY - SEWERS & WATER
 MCHARGUE INDUSTRIAL PARK
 MIKE MCHARGUE
 911 VISTA AVE, LEWISTON, IDAHO

KELTIC ENGINEERING, INC.
 315 Adams Lane • Lewiston, Idaho 83501 • (208) 743-2135 • (208) 743-2136 fax
 9425 North Nevada Street, Ste 204 • Spokane, WA 99218 • (509) 464-3000 • (509) 464-3005 fax
 • Development • Design • Construction Management

PROFESSIONAL ENGINEER
 REGISTERED
 6064
 4/8/2014
 STATE OF IDAHO
 ERIC HASENOHR

DRAWN BY:	CHECKED BY:
RGW	EFH
DESIGNED BY:	EFH
DATE:	02/13/14
LAST REV.:	04/01/14 (JDM)
PROJECT NO.:	13-0112
SHEET NO.:	4 OF 4