


**UTILITY LOCATION**

THE LOCATIONS OF UNDERGROUND UTILITIES REPRESENTED ON THIS DRAWING HAVE BEEN DETERMINED FROM A FIELD SURVEY AND FROM RECORDS OBTAINED FROM THE VARIOUS UTILITY COMPANIES. THE NUMBER AND LOCATIONS OF ALL UNDERGROUND UTILITIES SHOWN ARE FOR INFORMATIONAL PURPOSES ONLY. FOR YOUR SAFETY, STATE LAW REQUIRES THAT YOU CALL THE LOCAL "ONE-CALL" UNDERGROUND UTILITY LOCATING CENTER AT LEAST TWO WORKING DAYS BEFORE BEGINNING ANY EXCAVATION: 1-800-342-1585

"CALL BEFORE YOU DIG"



SCALE

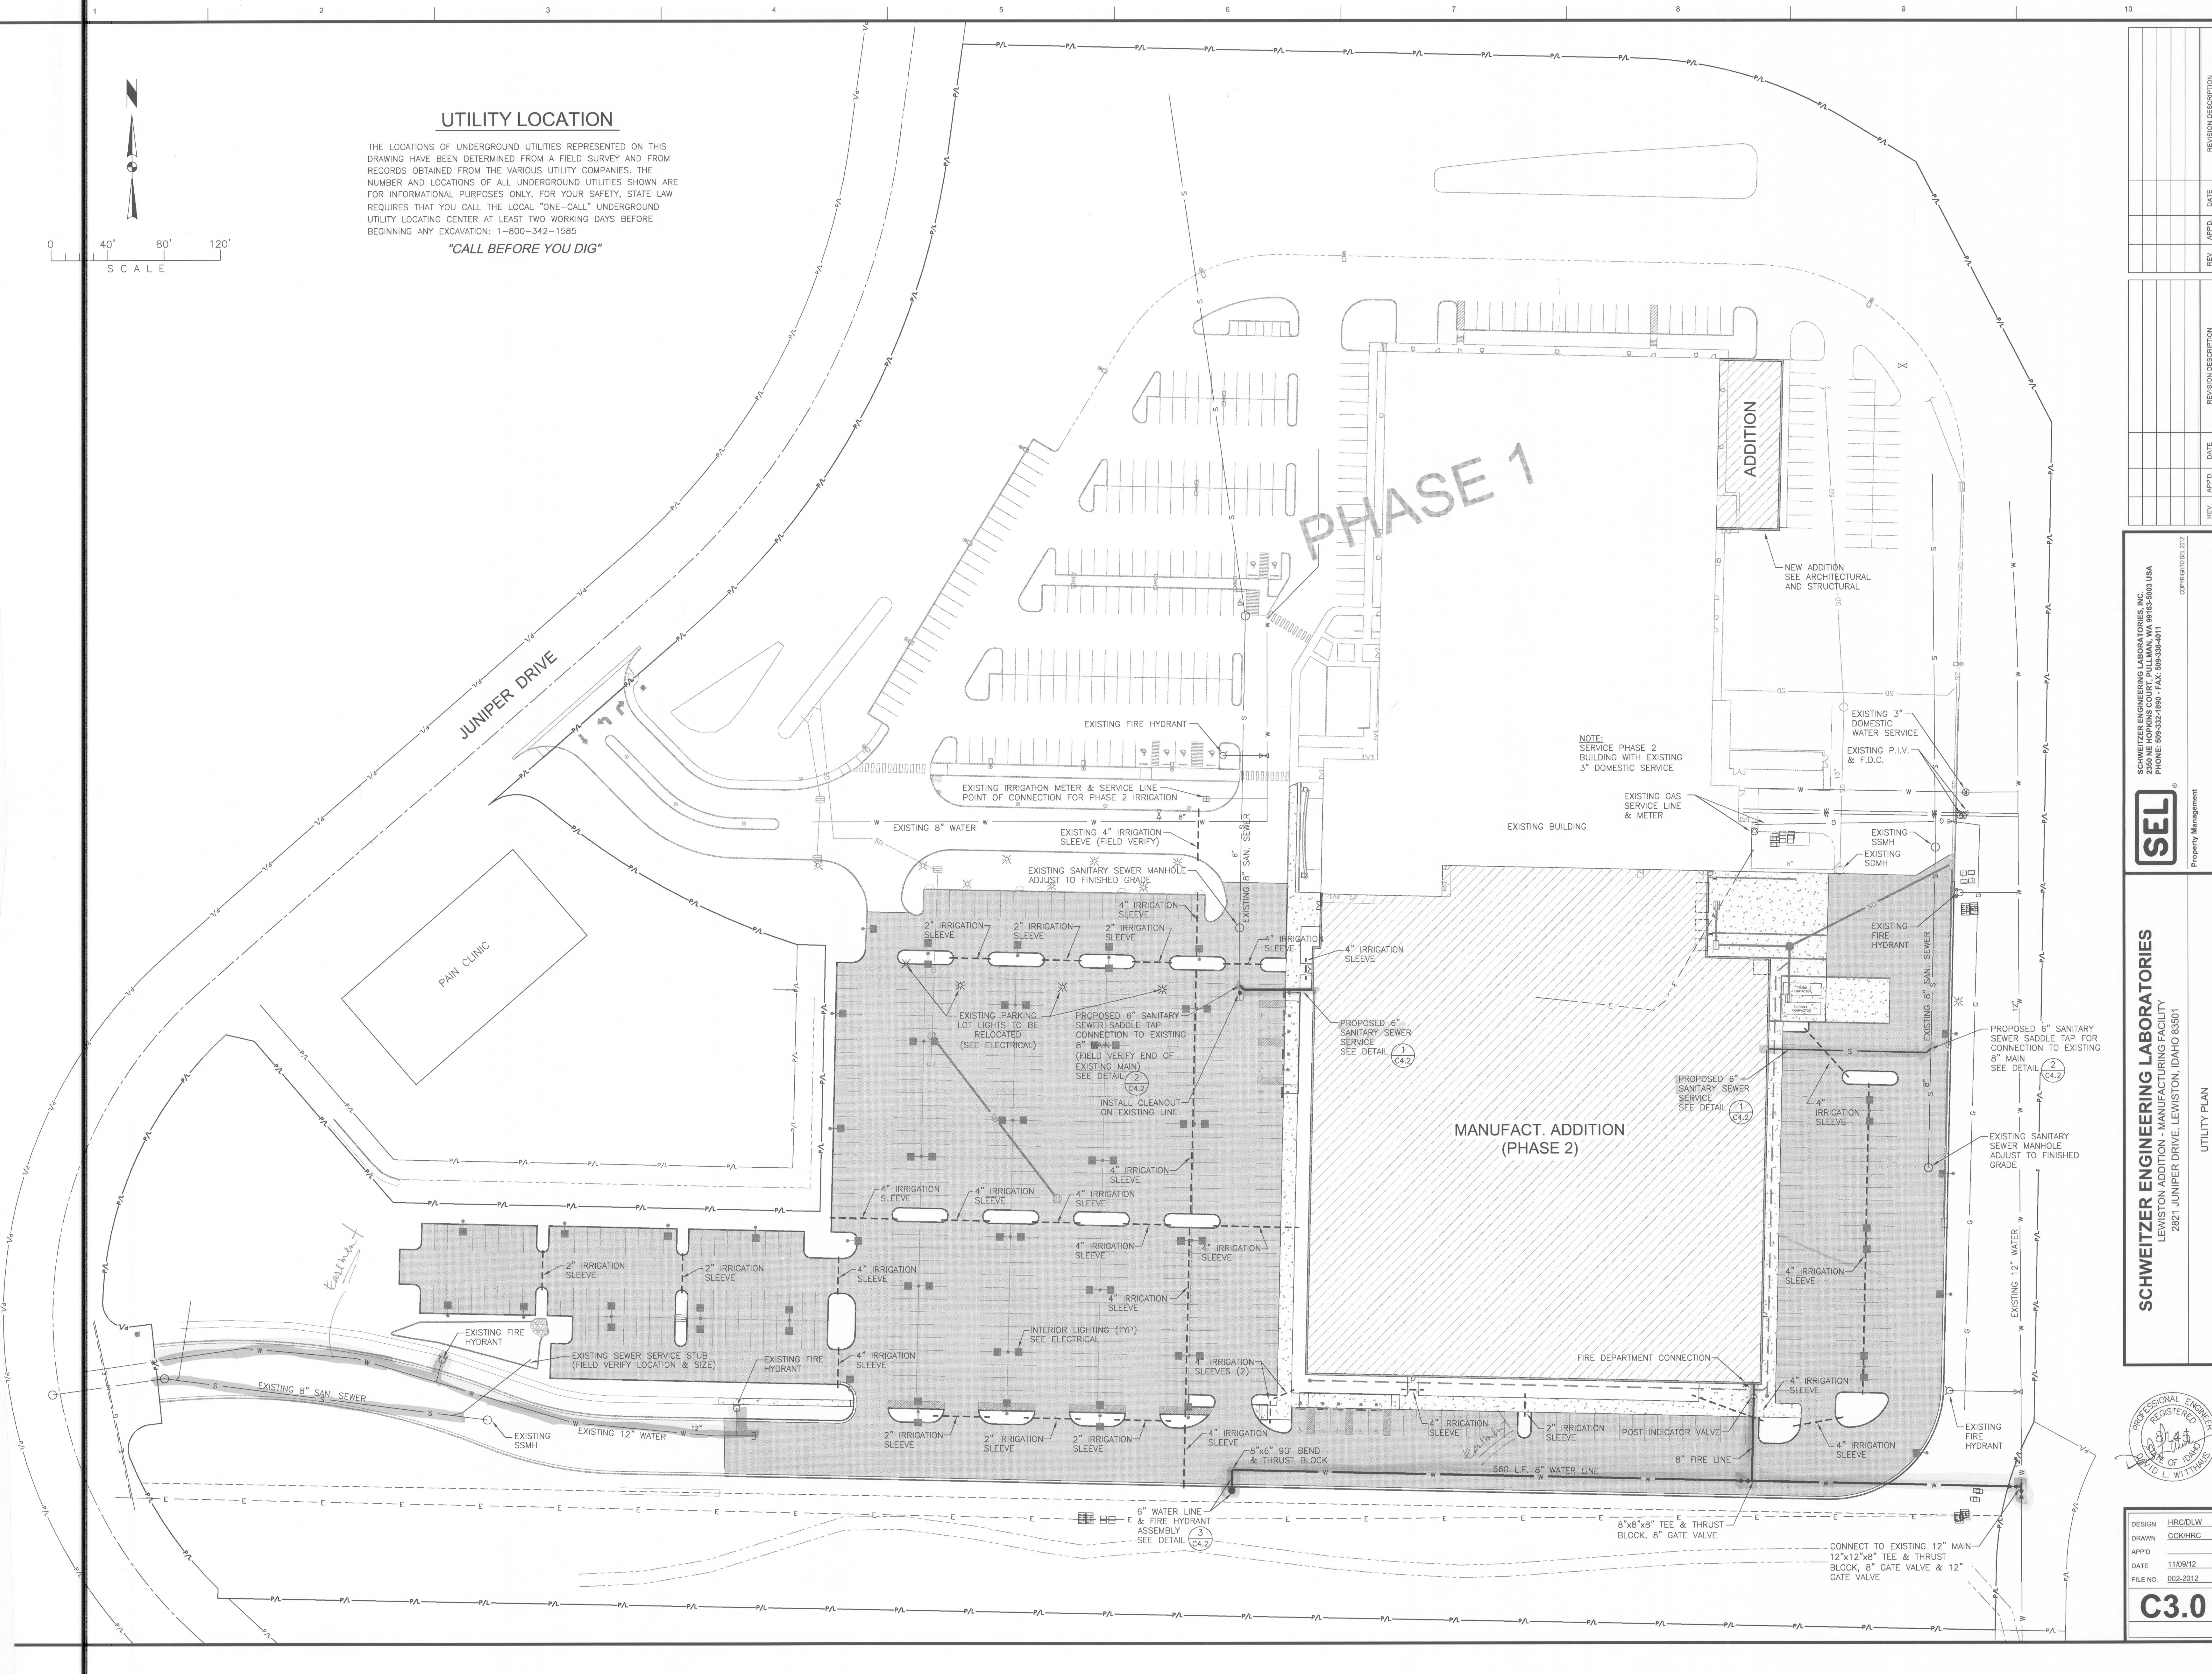


REV.	APPD.	DATE	REVISION DESCRIPTION

**SEL**  
Property Management

**SCHWEITZER ENGINEERING LABORATORIES, INC.**  
2330 NE HOPKINS COURT, PULLMAN, WA 99163-5003 USA  
PHONE: 509-335-1059 FAX: 509-335-4011  
CORPORATE REG. 2012

**SCHWEITZER ENGINEERING LABORATORIES**  
LEWISTON ADDITION - MANUFACTURING FACILITY  
2821 JUNIPER DRIVE, LEWISTON, IDAHO 83501

UTILITY PLAN

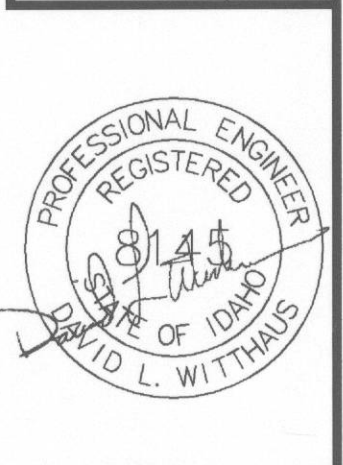

DESIGN	HRC/DLW
DRAWN	CGK/HRC
APPD	
DATE	11/09/12
FILE NO.	002-2012

**C3.0**