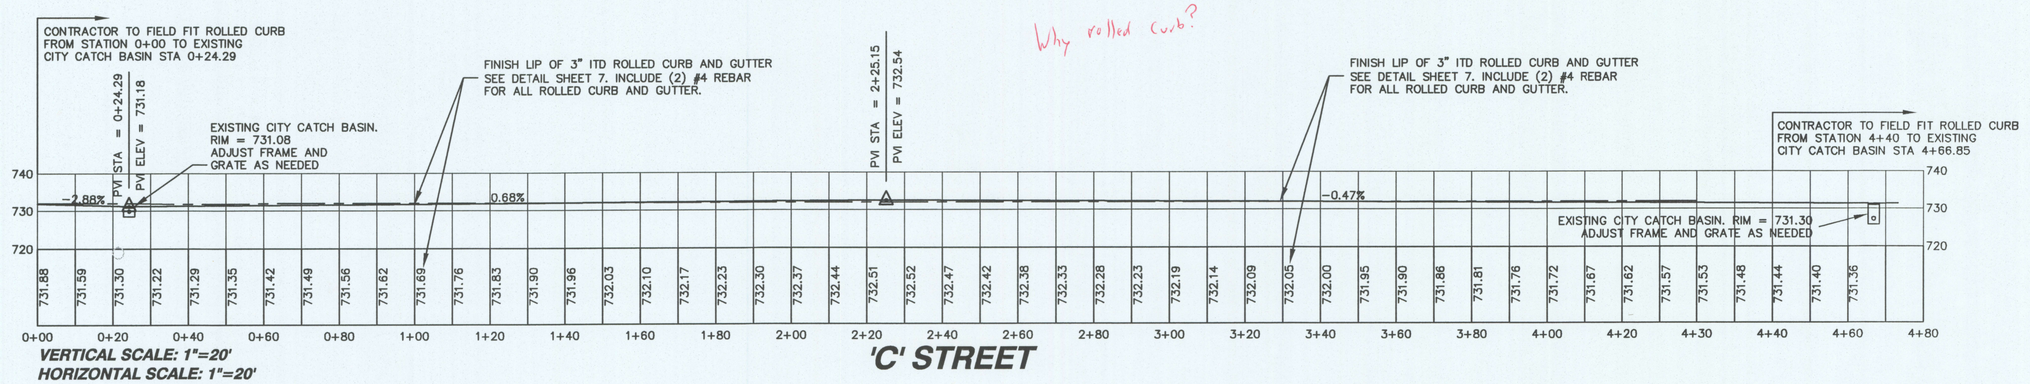

Why rolled curb?

VERTICAL SCALE: 1"=20'
HORIZONTAL SCALE: 1"=20'

'C' STREET

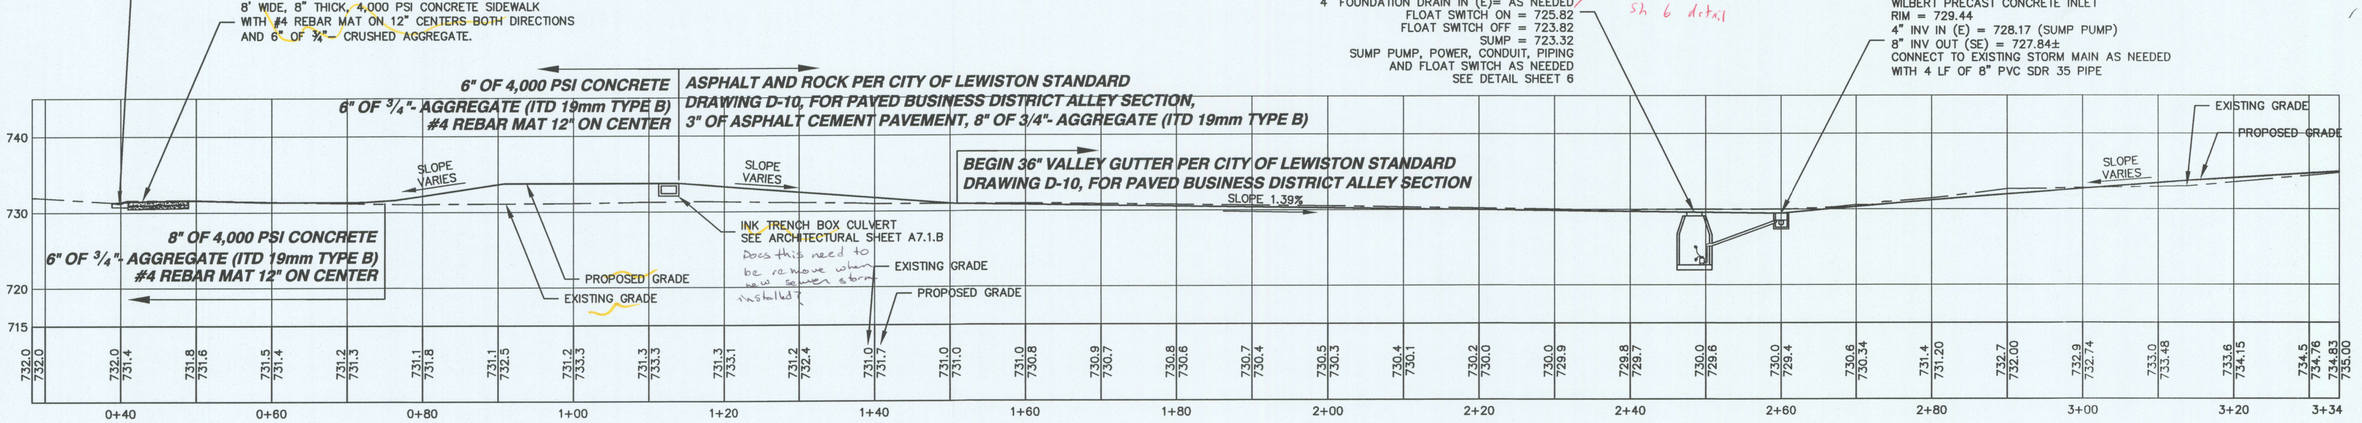

VERTICAL SCALE: 1"=10'
HORIZONTAL SCALE: 1"=10'

ALLEY

REVISIONS

NO.	DATE	BY	FILENAME
0			

ORIGINAL DRAWING

REGISTERED PROFESSIONAL ENGINEER 10962 STATE OF IDAHO CHARLES R. FISKE

4025 EAGLE COURT
LEWISTON, IDAHO 83501
FAX (208) 798-1082
(208) 791-9355

NACLINE ENGINEERING & DRAFTING "an affordable alternative"

LEWISTON TRIBUNE
PRINT PRESS BUILDING
'C' STREET CURB PROFILE
ALLEY PROFILE

DRAWN BY: CRF	CHECKED BY: CRF
DESIGNED BY: CRF	
SCALE: N/A	
DATE: 5/15/07	
PROJECT NO.: 00069	
SHEET 5 OF 7	