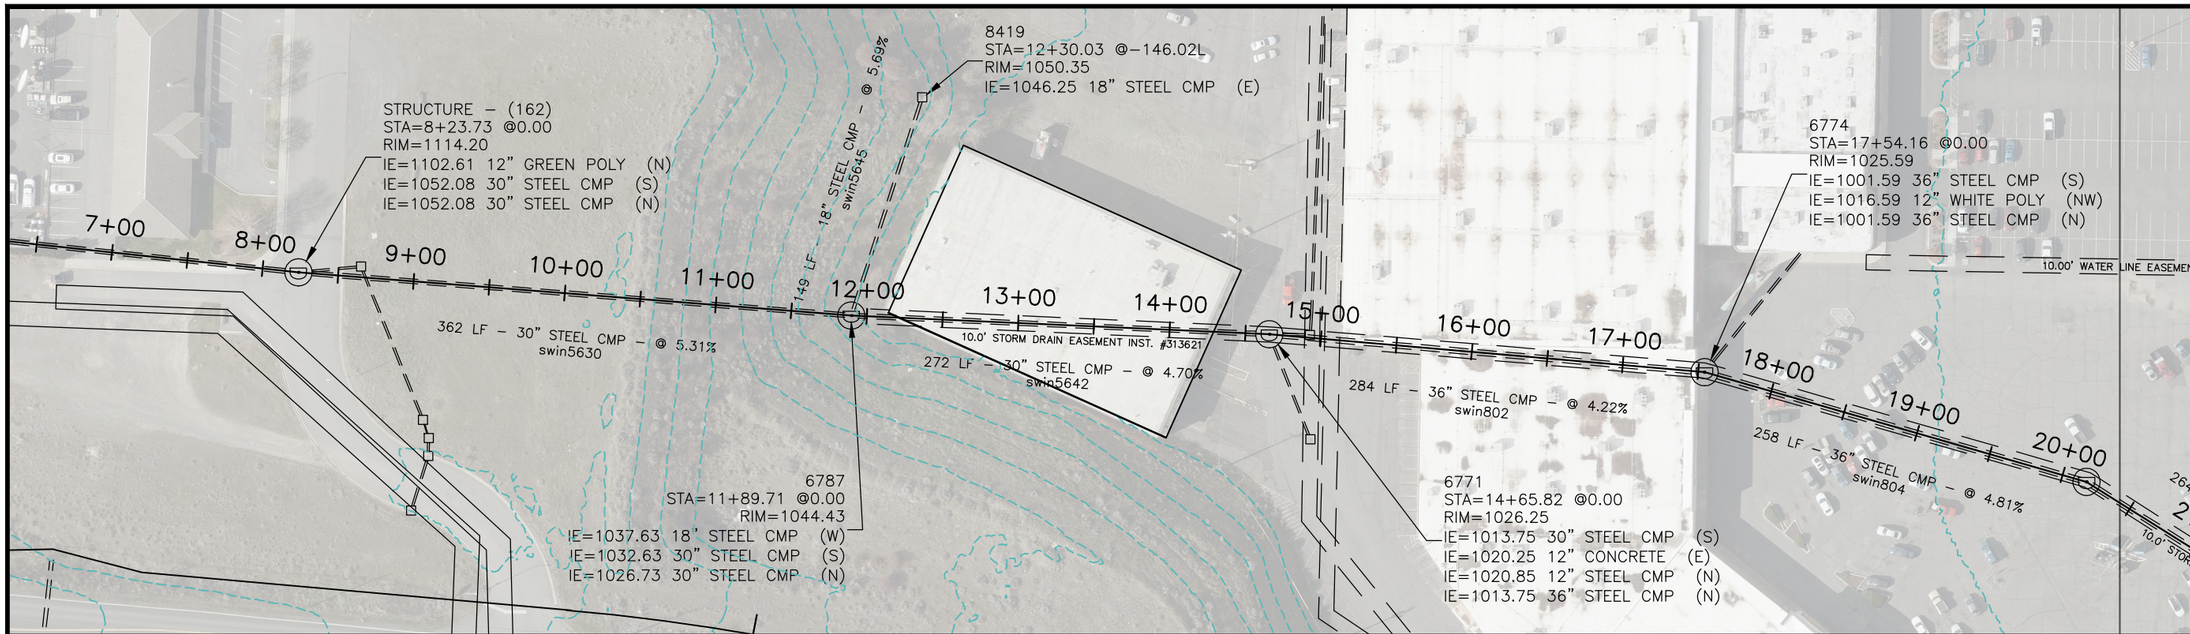

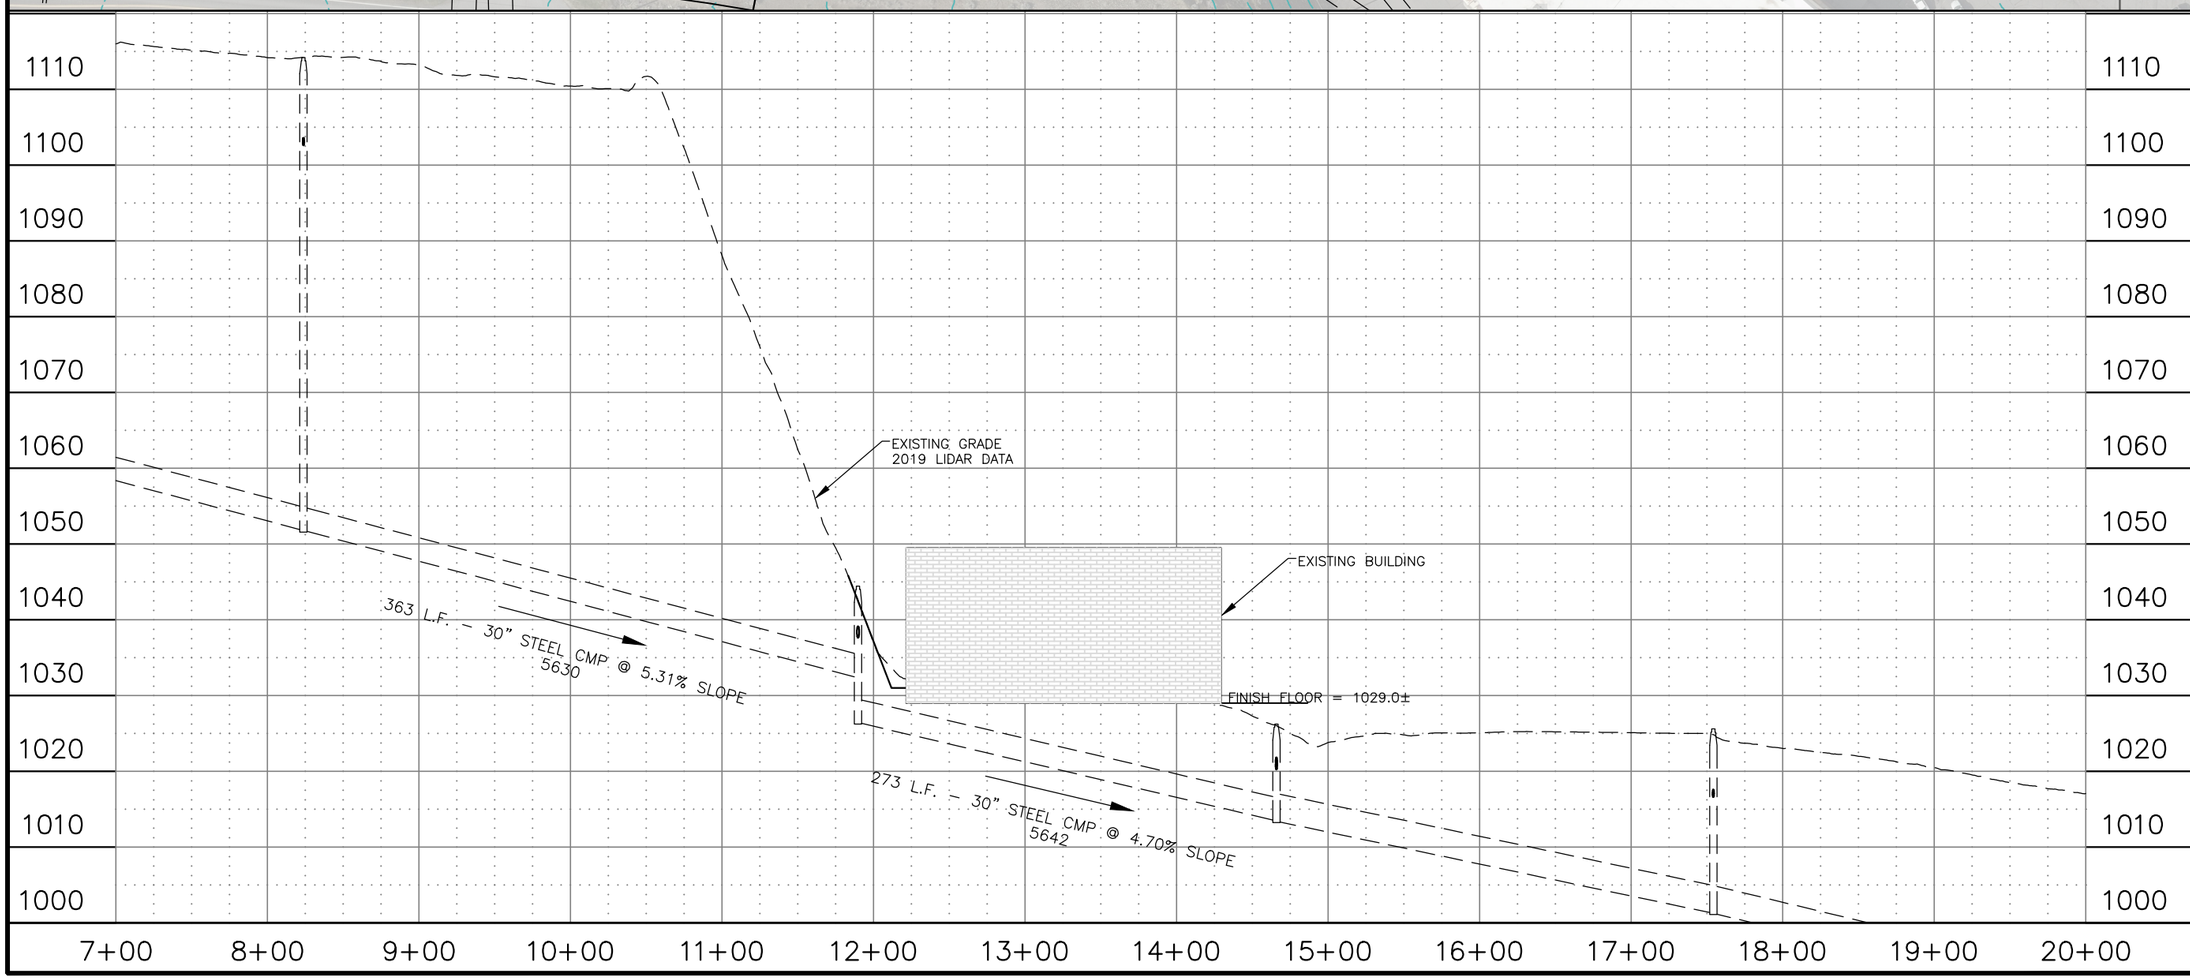

CITY OF LEWISTON
PUBLIC WORKS DEPARTMENT
1861
215 "D" Street, Lewiston, ID 83501-1930
Phone: 208-746-1316 Fax: 208-746-5595

NO.	DATE	DESCRIPTION	BY

REVISIONS

EXHIBIT DRAWING

LEWISTON CENTER MALL
EXISTING STORM WATER PROFILE

PLAN & PROFILE

SCALE: 1" = 100'
DESIGNED BY:
DRAWN BY: BDS
CHECKED BY:
SHEET SET: NONE
DATE: 11-05-2020
DRAWING NO.:
SHEET 1 OF 1