1 inch = 400 feet

CITY OF LEWISTON
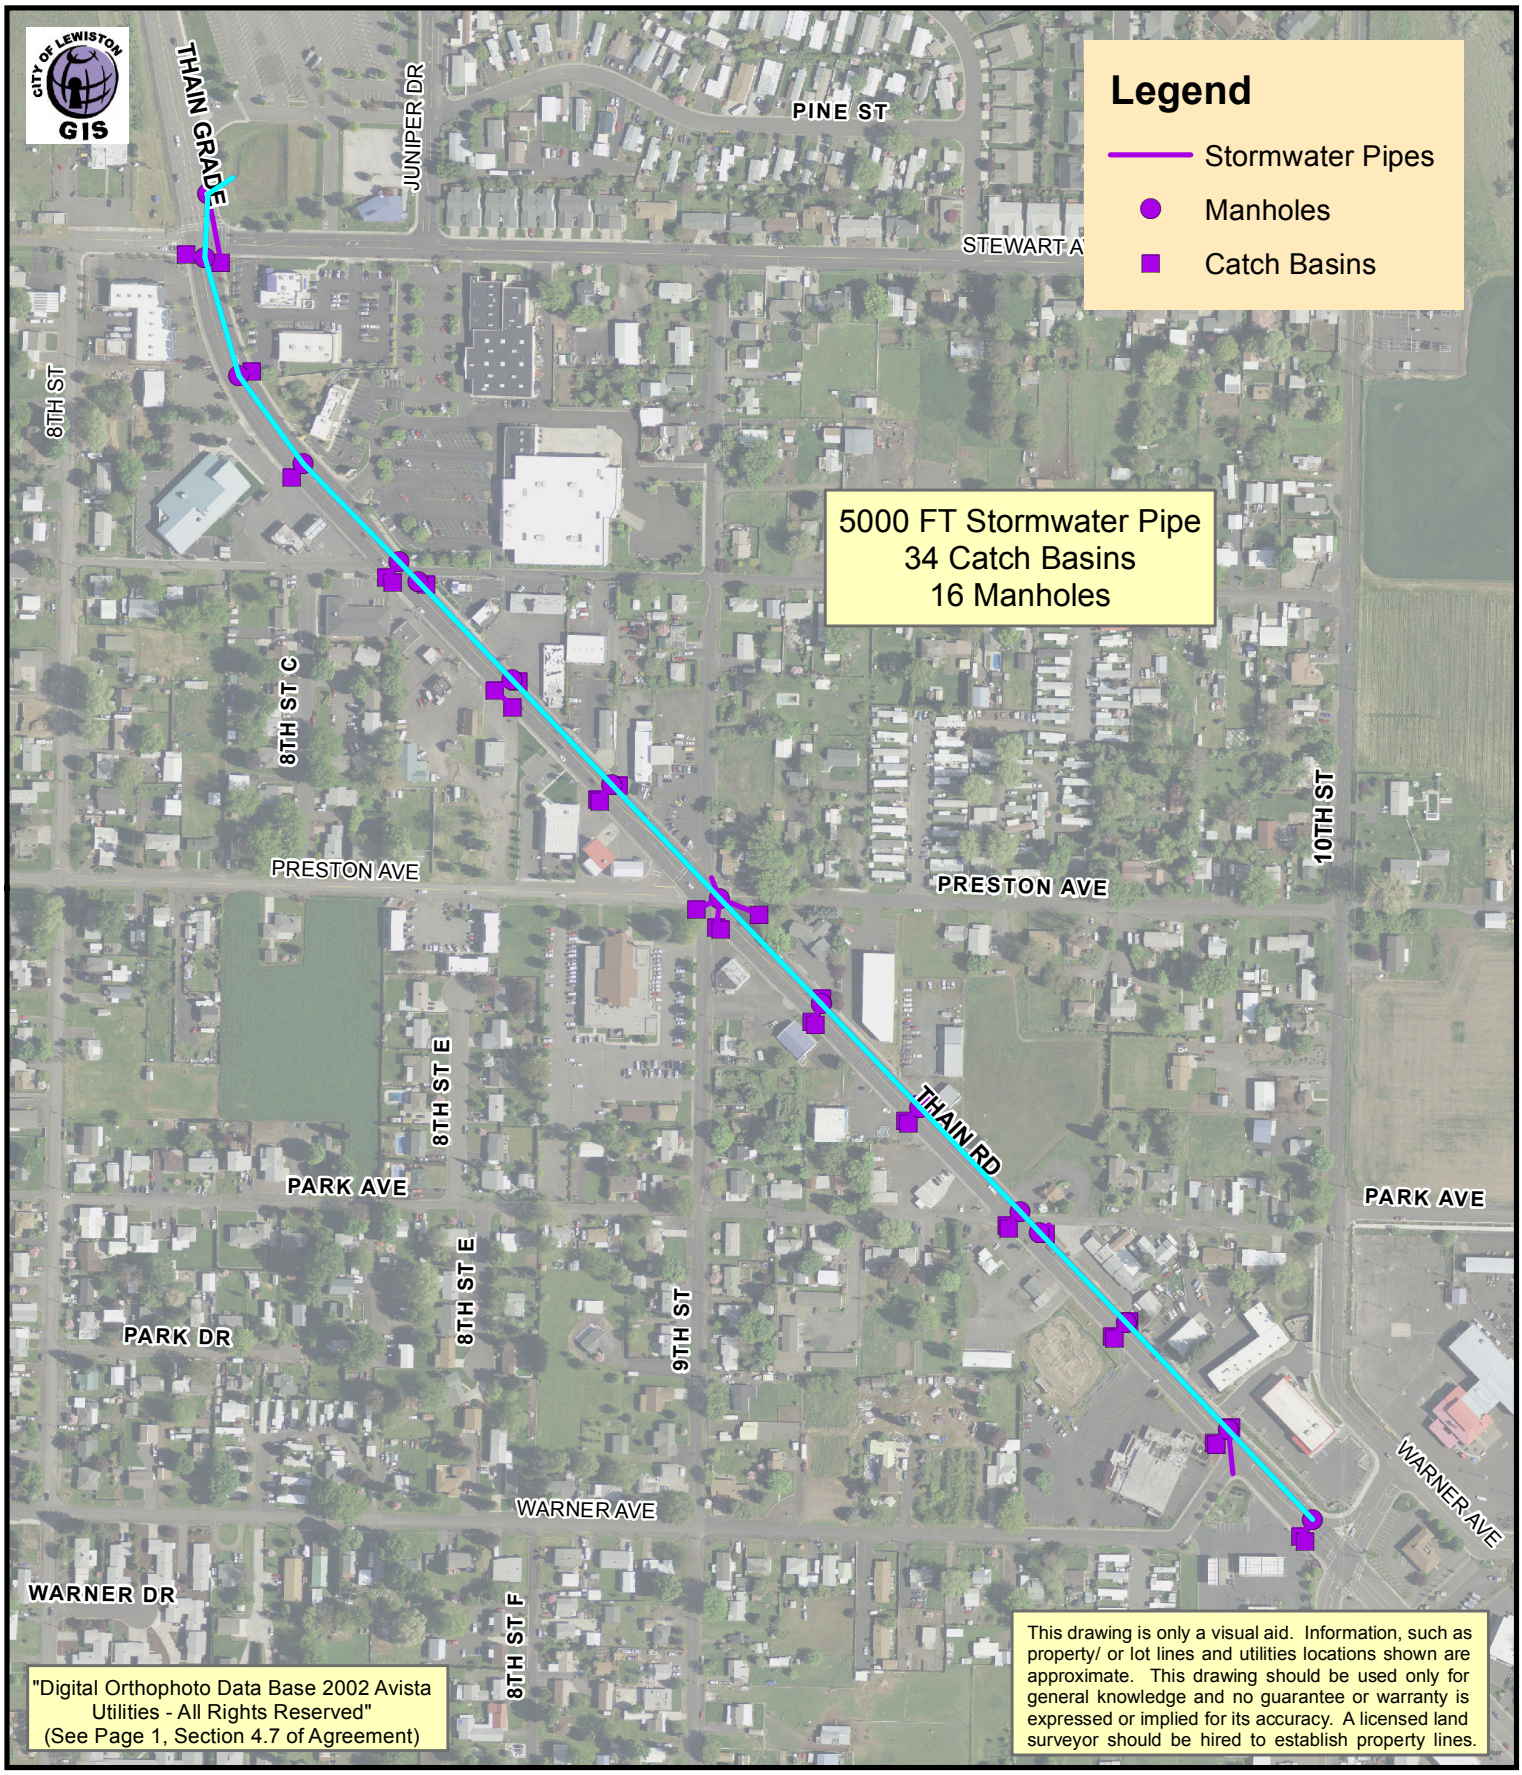
Thain Rd Storm Rehabilitation
Stewart Ave to 10th St