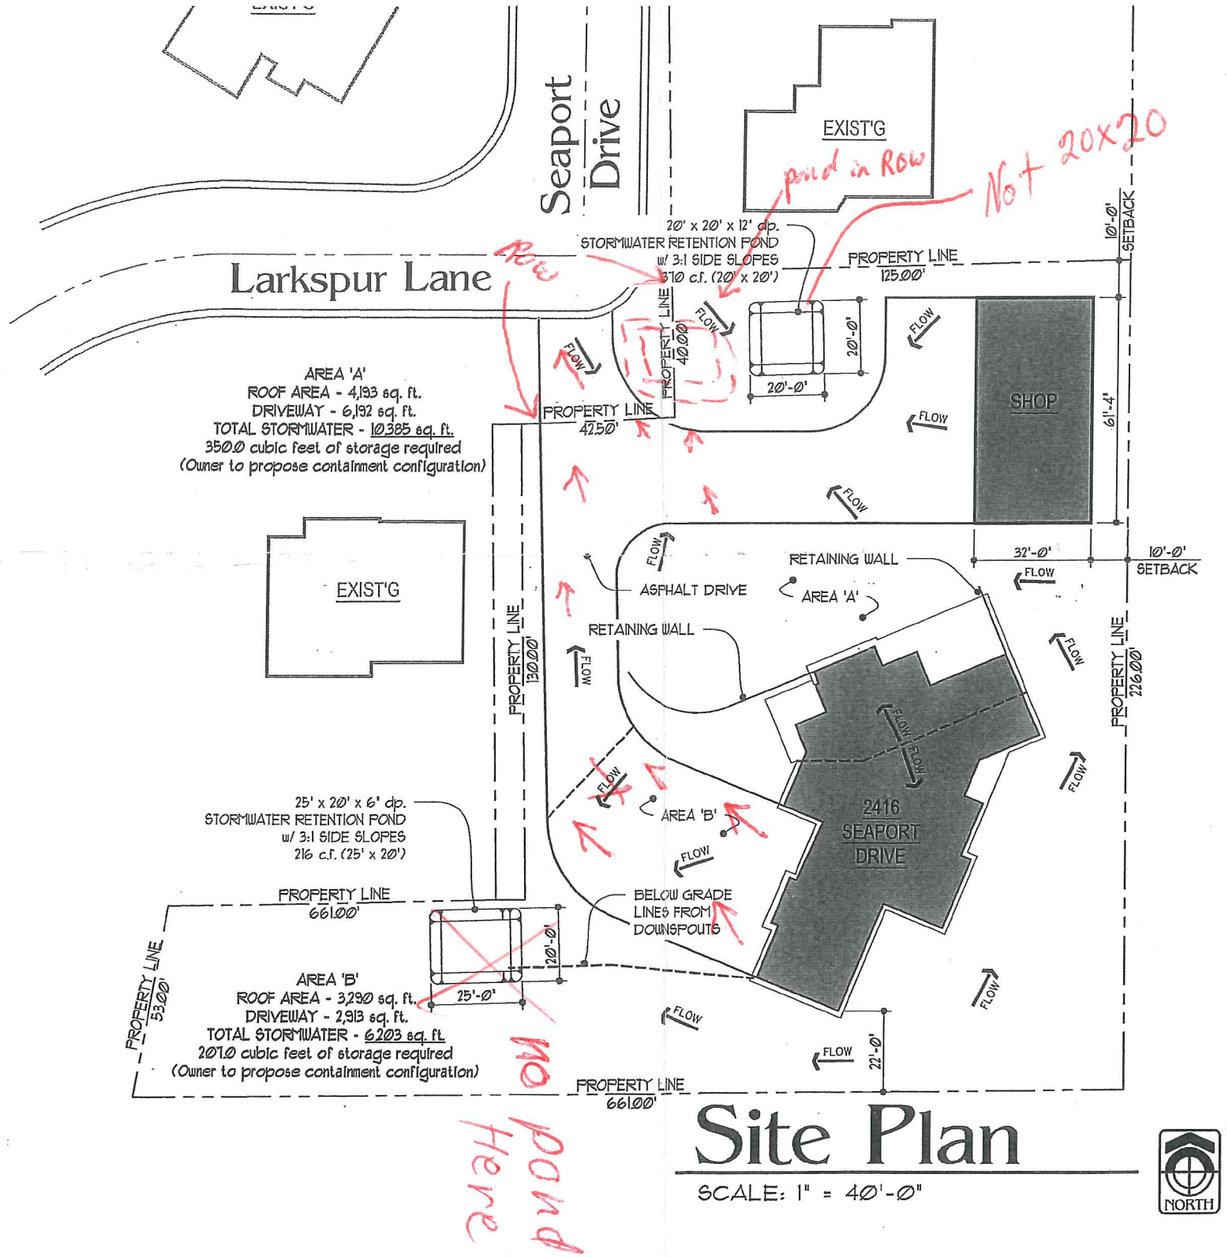

Site Plan

SCALE: 1" = 40'-0"

These drawings are intended for functional purposes only. They are not suitable for construction. Design Professional retains all copyright, common law, statutory and other reserved rights. The full scale set has been delivered to the owner for review, approval and said client, knowingly and fully forgo reliance on any copies made by other parties, clients and future entities out of the original set. Possession of a reproducible key set of this electronic data constitutes acknowledgement and acceptance of this disclaimer.

Site Plan for
Dan & Peggy Klemp

MY ARCHITECT
301 Main Street
Suite 101
Lewiston, Idaho
(208) 743-5902

Job Number: 14-019
Date: 11-19-14

S-1

☐ S/W ?
FILO option
Postponement ?

None of this storm system was built as planned

2416 SEAPORT DRIVE

#2 Resub - Eng. Storm Water Plan
B14-000395

RECEIVED
DEC 1 2015
CITY OF LEWISTON
BUILDING SERVICES